


Map No. _____ Sec. 24, Twp. 26, R. 4Well No. 3 Harmon Farm _____
Ramsey Pet. Company _____

NORTH

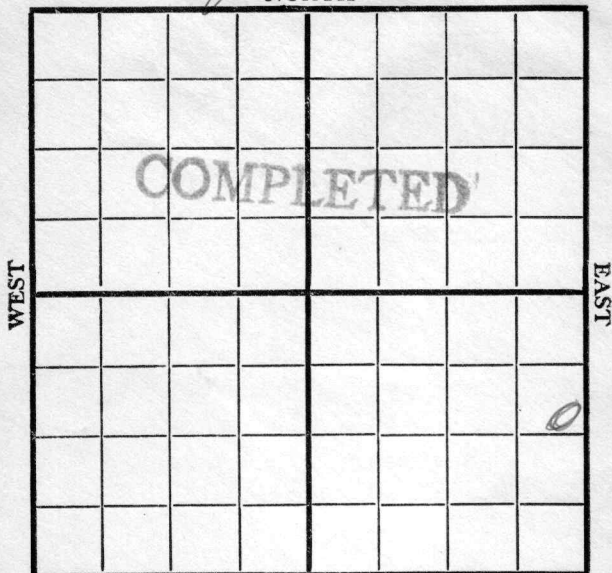

SOUTH

Location _____

Rig up _____

Drilling Remarks:

Drilling Remarks:

RECORD

Cased _____ in. _____ ft.

Sand _____

Gas _____

Oil _____

Total Depth _____

PRODUCTION

1st 24 hrs. Nat. _____

1st 24 hrs. after shot _____

Gas _____ Cu. Ft.

Dry Hole _____


Abandoned _____

Map No. _____ Sec. 24 Twp. 26 R. 4
 Well No. 3 Harrison Farm
Ramsey Petro Company

NORTH

WEST

EAST

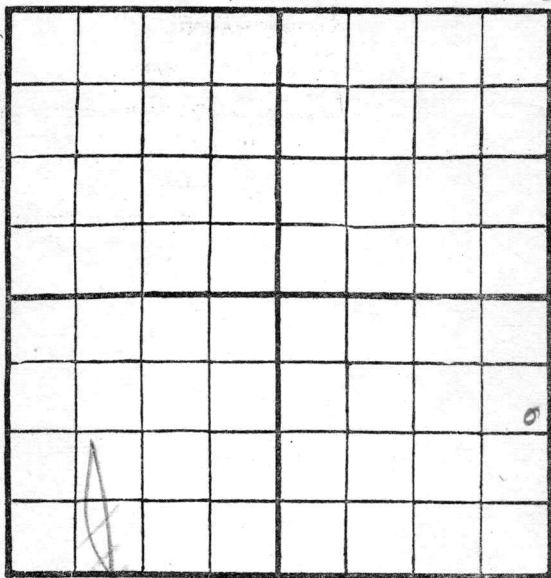

SOUTH

Location 0 4

Rig Up _____

Drilling and remarks

400

RECORD

Cased _____ in. _____ Ft.

Sand _____

Gas _____

Oil _____

Total Depth _____

PRODUCTION

1st 24 hrs. Nat. _____

1st 24 hrs. after shot _____

Gas _____ Cu. Ft.

Dry Hole _____

Abandoned _____

First Report


Date

1/16, 1918, S. Condy Scout

Map No. _____ Sec. 24 Twp. 26 R. 4Well No. 3 Hanson Farm _____Ramsey Petro Company _____

NORTH

WEST

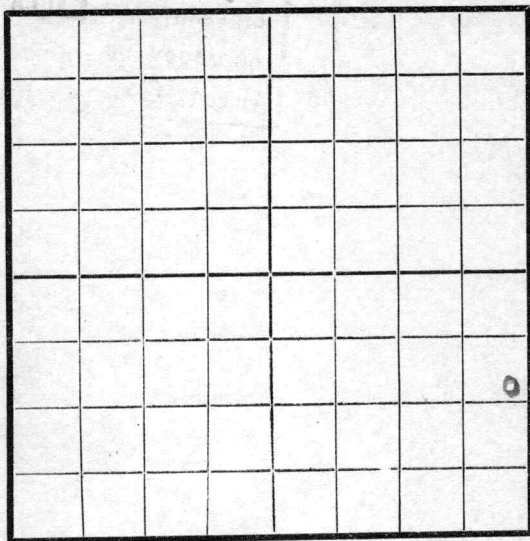

EAST

SOUTH

RECORD

Location _____

Cased _____ in. _____ Ft.

Rig Up _____

Sand _____

Drilling and remarks

Gas _____

Oil _____

Total Depth _____

PRODUCTION

1st 24 hrs. Nat. _____

1st 24 hrs. after shot _____

Gas _____ Cu. Ft.

Dry Hole _____

Abandoned _____

Date

1/23, 1918 Candy Scout

Map No. _____ Sec. 24 Twp. 26 R. 4


Well No. 3 Farm _____

Ramsey Oil Company

NORTH

WEST

EAST

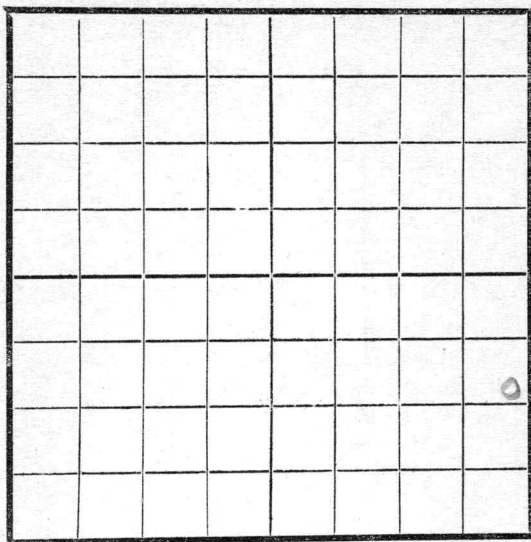

SOUTH

Location _____

Rig Up _____

Drilling and remarks

Done

RECORD

Cased _____ in. _____ Ft.

Sand _____

Gas _____

Oil _____

Total Depth _____

PRODUCTION

1st 24 hrs. Nat. _____

1st 24 hrs. after shot _____

Gas _____ Cu. Ft.


Dry Hole _____

Abandoned _____

Date

1/30, 1918 Scout

Map No. _____ Sec. 24 Twp. 26 R. 4
 Well No. 34 Ramsey Farm _____
Ramsey Oil Company _____
 Date Started _____ Ft. from N _____ S _____ E _____ W _____ line
NORTH

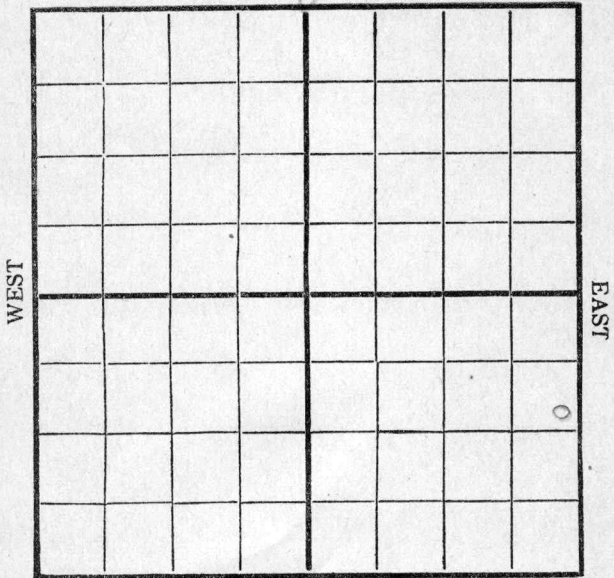

SOUTH

Cased _____ In. _____ Ft. Sand _____ Pay { Gas _____ Oil _____ Total Depth _____	Production Remarks 7/6/18
--	---

Condition of Well on this date _____

22 0000

C. C. Coffey


Scout

Map No. _____ Sec. 24 Twp. 26 R. 4

Well No. 3 Harmon Farm
Running Oil Company

NORTH

WEST

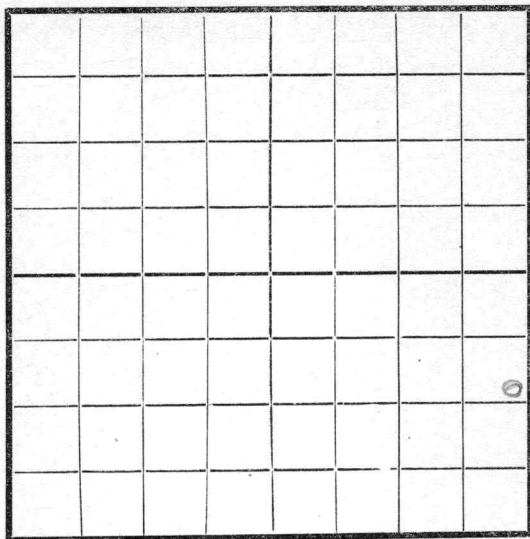

EAST

SOUTH

Location _____

Rig Up _____

Drilling and remarks

2400

RECORD

Cased _____ in. _____ Ft.

Sand _____

Gas _____

Oil _____

Total Depth _____

PRODUCTION

1st 24 hrs. Nat. _____

1st 24 hrs. after shot _____

Gas _____ Cu. Ft.

Dry Hole _____

Abandoned _____


Date

7/13, 1918 Candey Scout

Map No. K14 Sec. 24 Twp. 26 R. 4Well No. 3 Harmon FarmRamsey Oil Company

NORTH

WEST

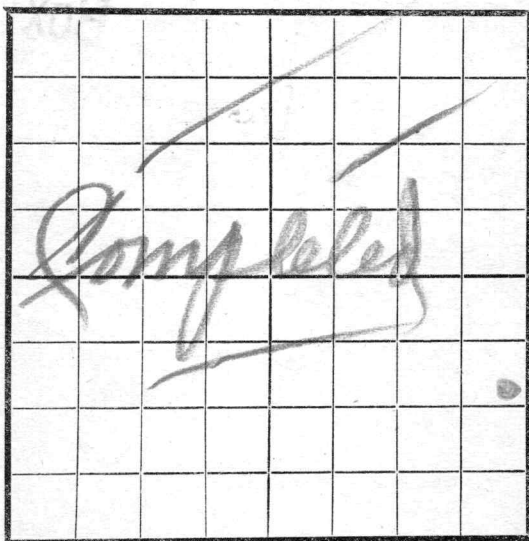

EAST

SOUTH

Location -----

Rig Up -----

Drilling and remarks

*Estimated
at 300
Bbls*

RECORD

Cased ----- in. ----- Ft.

Sand 2644-2662

Gas -----

Oil -----

Total Depth -----

PRODUCTION

1st 24 hrs. Nat. -----

1st 24 hrs. after shot -----

Gas ----- Cu. Ft.

Dry Hole -----

Abandoned -----

Date

7/21, 1918 O. Condey Scout