

Map No. _____ Sec. 11 Twp. 26 R. 4Well No. 5 Cardey Farm __________Empire_____
Company

NORTH

WEST

EAST

SOUTH

Location _____

Rig Up _____

Drilling Remarks:

Drilling Remarks:

RECORD

Cased _____ in. _____ ft.

Sand _____

Gas _____

Oil _____

Total Depth _____

PRODUCTION

1st 24 hrs. Nat. _____

1st 24 hrs. after shot _____

Gas _____ cu. ft

Dry Hole _____

Abandoned _____

Map No. _____ Sec. 11 Twp. 26 R. 4


Well No. 5 _____ Farm _____

Empire _____ Company _____

NORTH

WEST

EAST

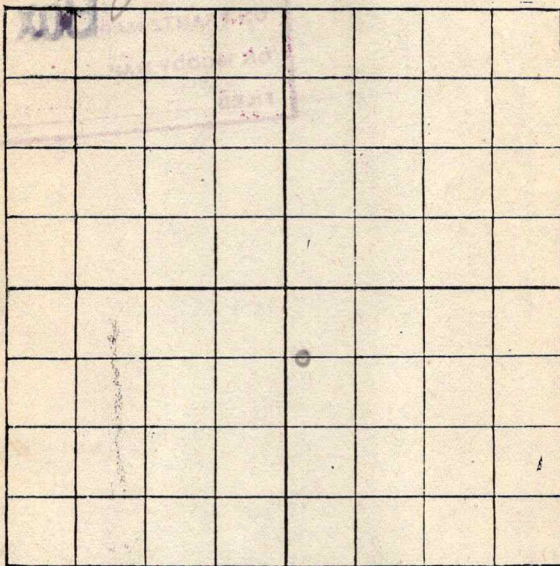

SOUTH

Location _____

Rig up _____

Drilling and remarks:

RECORD

Cased _____ in. _____ Ft.

Sand _____

Gas _____

Oil _____

Total Depth _____

PRODUCTION

1st 24 hrs. Nat. _____

1st 24 hrs. after shot _____

Gas _____ Cu. Ft.

Dry Hole _____

Abandoned _____

Date


7/19, 1917, Cardiff Scout

NEW LOCATION

Map No. _____ Sec. 11 Twp. 26 R. 4
 Well No. 5 Candy _____ Farm _____
Engine _____ Company _____

NORTH

WEST

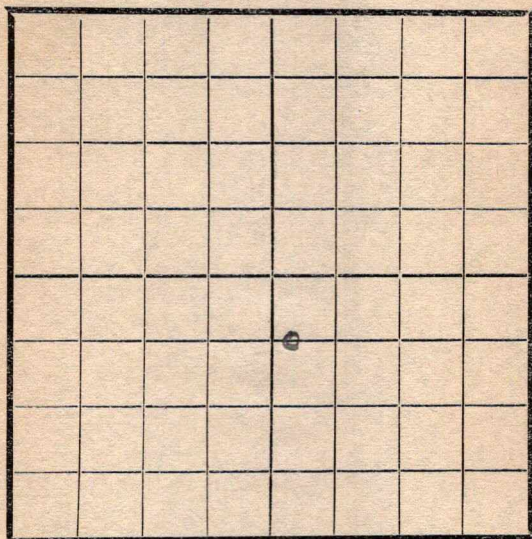

EAST

SOUTH

Location _____

Rig Up _____

Drilling and remarks

605

RECORD

Cased _____ in. _____ Ft

Sand _____

Gas _____

Oil _____

Total Depth _____

PRODUCTION

1st 24 hrs. Nat. _____

1st 24 hrs. after shot _____

Gas _____ Cu. Ft

Dry Hole _____

Abandoned _____

Date

8/9

, 191


7 Candy

Scout

Map No. _____ Sec. 11 Twp. 26 R. 4
 Well No. 5. Cordy Farm _____
Empire Company _____

NORTH

WEST

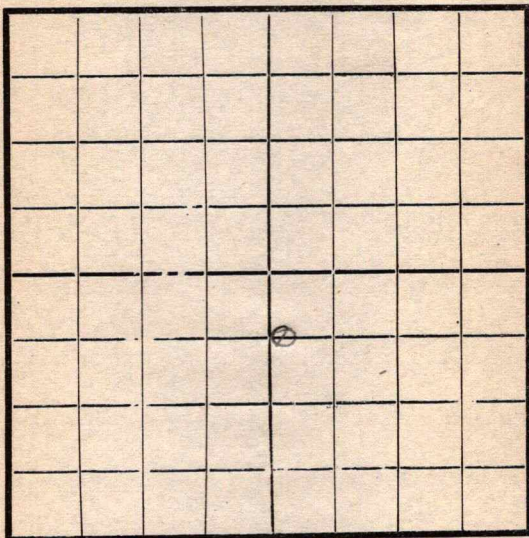

EAST

SOUTH

Location _____

Rig Up _____

Drilling and remarks

at 1690

RECORD

Cased _____ in. _____ Ft.

Sand _____

Gas _____

Oil _____

Total Depth _____

PRODUCTION

1st 24 hrs. Nat. _____

1st 24 hrs. after shot _____

Gas _____ Cu. Ft.

Dry Hole _____

Abandoned _____

Date

8-24, 1917


Lantz

Scout _____

Map No. _____ Sec. 11 Twp. 26 R. 4
 Well No. 5 Candy Farm _____
Engine Company _____

NORTH

WEST

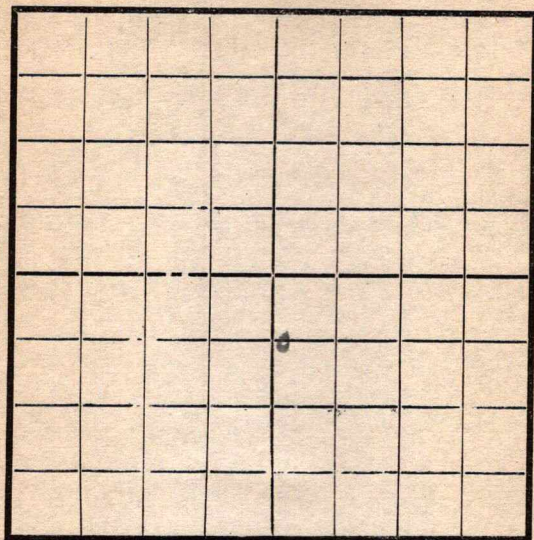

EAST

SOUTH

Location _____

Rig Up _____

Drilling and remarks _____

Tap sand
2350

RECORD

Cased _____ in. _____ Ft.

Sand _____

Gas _____

Oil _____

Total Depth _____

PRODUCTION

1st 24 hrs. Nat. _____

1st 24 hrs. after shot _____

Gas _____ Cu. Ft.

Dry Hole _____

Abandoned _____


Date

9/5, 1917 Candy Scout

Map No. _____ Sec. 11 Twp. 26 R. 4
Well No. 5 Candy Farm _____
Empire Company _____

NORTH

WEST

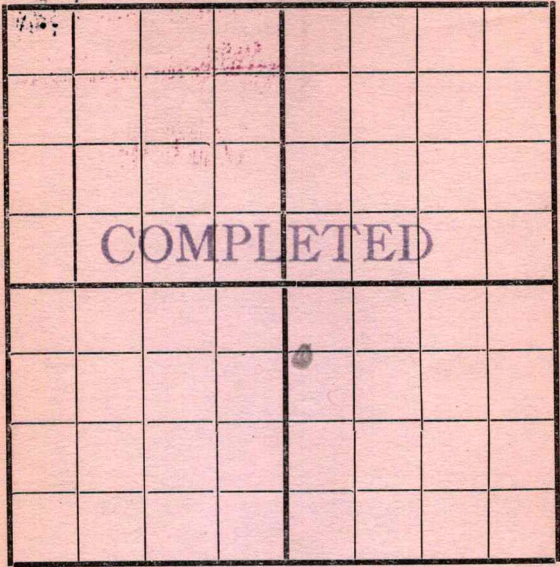

EAST

SOUTH

Location _____

Rig Up _____

Drilling and remarks

*Estimated
at 3500
Bbls*

RECORD

Cased _____ in. _____ Ft.

Sand 2353-2368

Gas _____

Oil _____

Total Depth _____

PRODUCTION

1st 24 hrs. Nat. _____

1st 24 hrs. after shot _____

Gas _____ Cu. Ft.

Dry Hole _____

Abandoned _____

Date

9/12, 1917 Candy Scout