


Map No. _____ Sec. 24 Twp. 26 R. 4
 Well No. 5- Harmon Farm _____
Ramsey Oil Company

NORTH

WEST

EAST

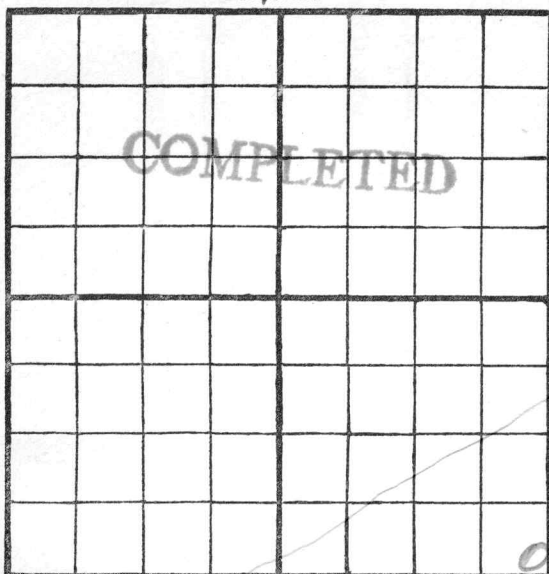

SOUTH

Location _____

Rig Up _____

Drilling Remarks:

Drilling Remarks:

RECORD

PRODUCTION

Cased _____ in. _____ ft.

1st 24 hrs. Nat. _____

Sand _____

1st 24 hrs. after shot _____

Gas _____

Gas _____ cu. ft

Oil _____

Dry Hole _____

Total Depth _____

Abandoned _____

Map No. _____ Sec. 24 Twp. 26 R. 4

Well No. 102 Harmon Farm

Ramsey Oil Company

NORTH

WEST

EAST

SOUTH

Location _____

Rig up ☒ _____

Drilling and remarks:

FIRST REPORT

RECORD

Cased _____ in. _____ Ft.

Sand _____

Gas _____

Oil _____

Total Depth _____

PRODUCTION

1st 24 hrs. Nat. _____

1st 24 hrs. after shot _____

Gas _____ Cu. Ft.

Dry Hole _____

Abandoned _____


Date

10/9, 1917, Candiff Scout

Map No. _____ Sec. 24 Twp. 26 R. 4Well No. 2 Harmon FarmRamsey Oil Company

NORTH

WEST

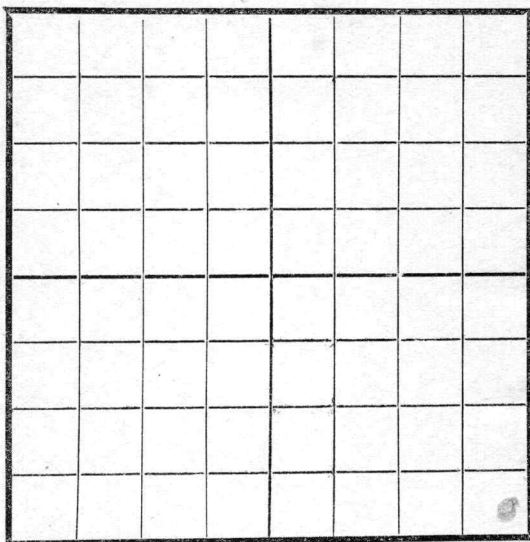

EAST

SOUTH

RECORD

Location _____

Cased _____ in _____ Ft.

Rig Up _____

Sand _____

Drilling and remarks

Gas _____

Oil _____

Total Depth _____

PRODUCTION

1st 24 hrs. Nat. _____

1st 24 hrs. after shot _____

Gas _____ Cu. Ft.

Dry Hole _____

Abandoned _____

Date

4/7, 1912 Early Scout


Map No. _____ Sec. 24 Twp. 26 R. 4

Well No. 2 Harmon Farm
Ramsay Oil Company

NORTH

WEST

EAST

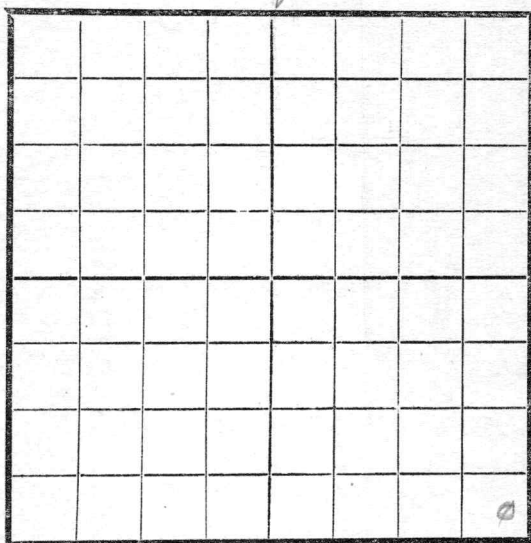

SOUTH

Location _____

Rig Up ☒ _____

Drilling and remarks

RECORD

Cased _____ in _____ Ft.

Sand _____

Gas _____

Oil _____

Total Depth _____

PRODUCTION

1st 24 hrs. Nat. _____

1st 24 hrs. after shot _____

Gas _____ Cu. Ft.

Dry Hole _____

Abandoned _____

Date

1/14, 1917 Condy Scout

Map No. _____ Sec. 24 Twp. 26 R. 4


Well No. 2 Harmon Farm

Ramsey Oil Company

NORTH

WEST

EAST

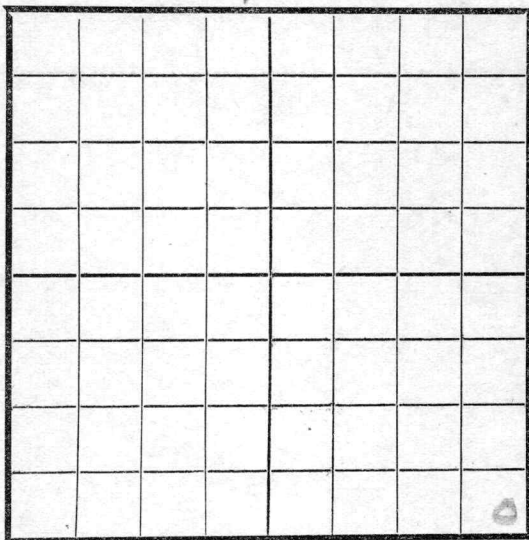

SOUTH

Location _____

Rig Up _____

Drilling and remarks

Rigging up

RECORD

Cased _____ in. _____ Ft.

Sand _____

Gas _____

Oil _____

Total Depth _____

PRODUCTION

1st 24 hrs. Nat. _____

1st 24 hrs. after shot _____

Gas _____ Cu. Ft.

Dry Hole _____

Abandoned _____

Date


11/21, 1917 C. O. D. J. Scout

Map No. _____ Sec. 24 Twp. 26 R. 4

Well No. 2 Harmon Farm
Ramsey Oil Company

NORTH

WEST

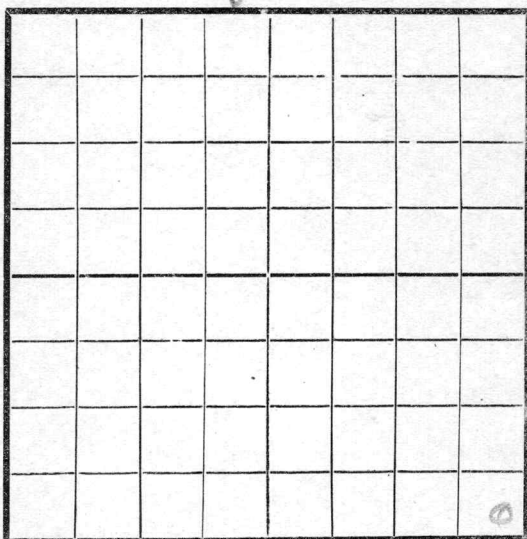

EAST

SOUTH

Location _____

Rig Up _____

Drilling and remarks

Rigging up

RECORD

Cased _____ in. _____ Ft.

Sand _____

Gas _____

Oil _____

Total Depth _____

PRODUCTION

1st 24 hrs. Nat. _____

1st 24 hrs. after shot _____

Gas _____ Cu. Ft.

Dry Hole _____

Abandoned _____

Date


11/28 1917 C. Lindsey Scout

Map No. _____ Sec. 24 Twp. 26 R. 4

Well No. 3 Hammer Farm _____
Ramsay Oil Company

NORTH

WEST

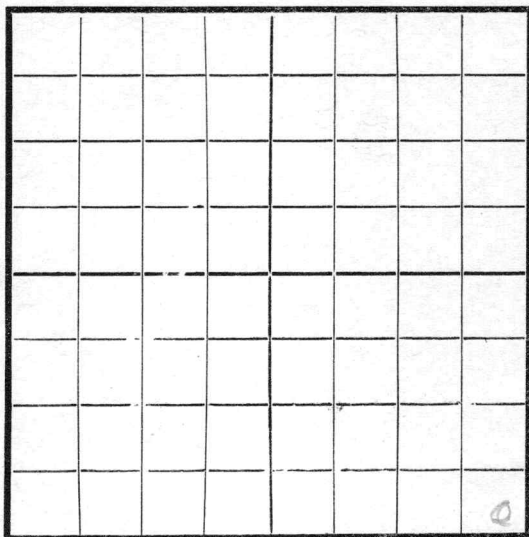

EAST

SOUTH

Location _____

Rig Up _____

Drilling and remarks

Rigged up

RECORD

Cased _____ in. _____ Ft.

Sand _____

Gas _____

Oil _____

Total Depth _____

PRODUCTION

1st 24 hrs. Nat. _____

1st 24 hrs. after shot _____

Gas _____ Cu. Ft.

Dry Hole _____

Abandoned _____

Date

12/5, 1917 Condyff Scout

Map No. 114 Sec. 24 Twp. 26 R. 4Well No. 2 Harmon Farm
Ramsey Oil & Gas Company

NORTH

WEST

EAST

SOUTH

Location -----

Rig Up -----

Drilling and remarks

*Changed
no from
2 to 5*

RECORD

Cased ----- in. ----- Ft.

Sand -----

Gas -----

Oil -----

Total Depth -----

PRODUCTION

1st 24 hrs. Nat. -----

1st 24 hrs. after shot -----

Gas ----- Cu. Ft.

Dry Hole -----

Abandoned -----

Date

1/2, 1918, Land Scout

Map No. _____ Sec. 24 Twp. 26 R. 4Well No. 5 Harmon Farm
Ramsay Oil & Gas Company

NORTH

WEST

EAST

SOUTH

Location _____

Rig Up _____

Drilling and remarks

1800Number
changed from
2 to 5

RECORD

Cased _____ in. _____ Ft.

Sand _____

Gas _____

Oil _____

Total Depth _____

PRODUCTION

1st 24 hrs. Nat. _____

1st 24 hrs. after shot _____

Gas _____ Cu. Ft.

Dry Hole _____

Abandoned _____


Date

1/2, 1918, C. C. C. C. Scout

Map No. _____ Sec. 24 Twp. 26 R. 4Well No. 5 Harmon Farm
Ramsay Oil Company

NORTH

WEST

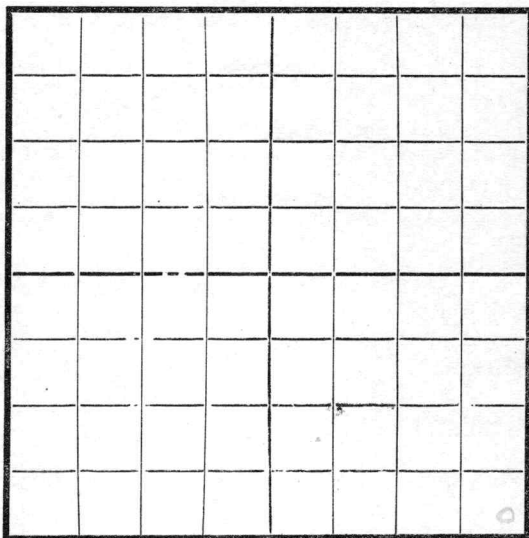

EAST

SOUTH

Location _____

Rig Up _____

Drilling and remarks

1800

RECORD

Cased _____ in. _____ Ft.

Sand _____

Gas _____

Oil _____

Total Depth _____

PRODUCTION

1st 24 hrs. Nat. _____

1st 24 hrs. after shot _____

Gas _____ Cu. Ft.

Dry Hole _____

Abandoned _____


Date

1/2, 1918 S. Condy Scout

Map No. K 14 Sec. 24 Twp. 26 R. 4Well No. 5 Herman Farm
Ramsey Oil Company

NORTH

WEST

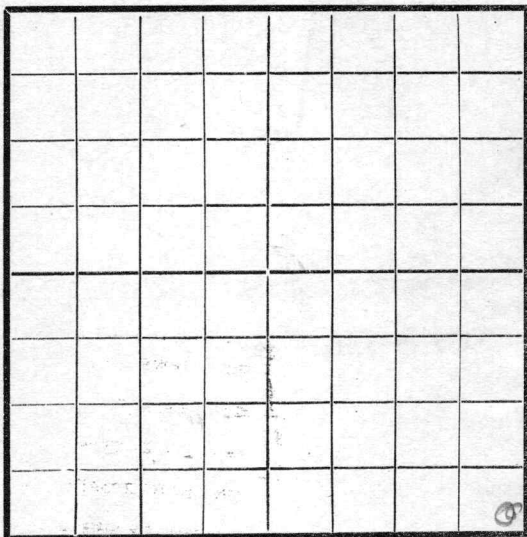

EAST

SOUTH

Location -----

Rig Up -----

Drilling and remarks

RECORD

Cased ----- in. ----- Ft.

Sand -----

Gas -----

Oil -----

Total Depth -----

PRODUCTION

1st 24 hrs. Nat. -----

1st 24 hrs. after shot -----

Gas ----- Cu. Ft.

Dry Hole -----

Abandoned -----

Date

1/9, 191

Scout

RETURNED BY W. J. [Signature]
 ON TRACING [Signature]
 ON U. S. C. MAP _____
 ON FRANTZ MAP _____
 ON MOODY MAP _____
 FILED _____

Should this be in

74-26-4

RECORD

Cased in _____
 Sand _____
 Gas _____
 Oil _____
 Total Depth _____

PRODUCTION

1st 24 hrs. Mat. _____
 1st 24 hrs. after shot _____
 Gas _____
 Dry Hole _____
 Abandoned _____

Location _____
 Hit Up _____
 Drilling and remarks _____

Date _____


Record _____

101

Map No. _____ Sec. 24 Twp. 26 R. 4

Well No. 5 Harmon Farm
Ramsey Petro Company
 NORTH

WEST

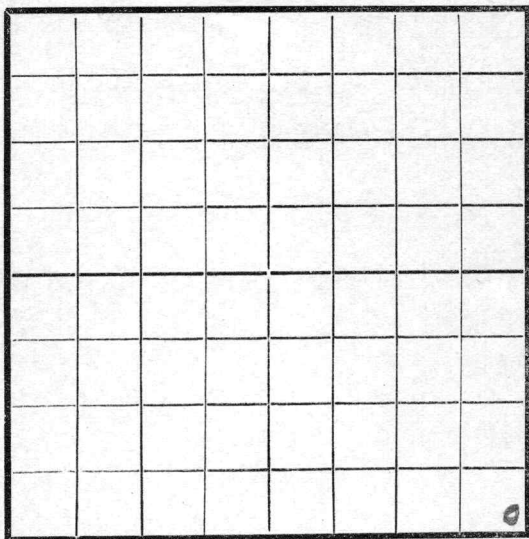

EAST

SOUTH

Location _____

Rig Up _____

Drilling and remarks

2225'

RECORD

Cased _____ in. _____ Ft.

Sand _____

Gas _____

Oil _____

Total Depth _____

PRODUCTION

1st 24 hrs. Nat. _____

1st 24 hrs. after shot _____

Gas _____ Cu. Ft.

Dry Hole _____

Abandoned _____

Date


1/16, 1918 E. Conley Scout

Map No. _____ Sec. 24 Twp. 26 R. 4

Well No. 5. Harmon Farm _____
Ramsey Petro Company

NORTH

WEST

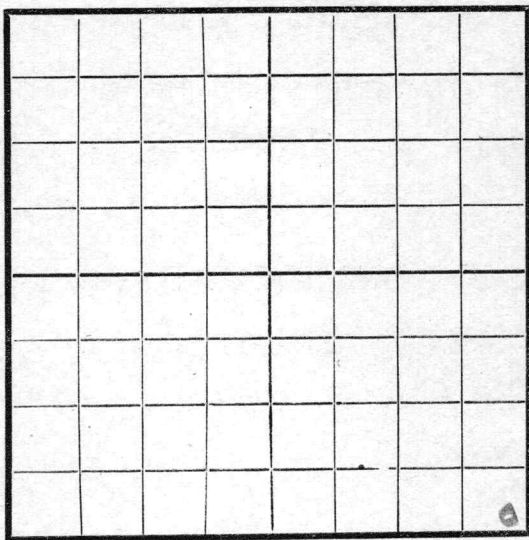

EAST

SOUTH

Location _____

Rig Up _____

Drilling and remarks

2350'

RECORD

Cased _____ in. _____ Ft.

Sand _____

Gas _____

Oil _____

Total Depth _____

PRODUCTION

1st 24 hrs. Nat. _____

1st 24 hrs. after shot _____

Gas _____ Cu. Ft.

Dry Hole _____

Abandoned _____


Date

1/23, 1918 and _____ Scout

Map No. K14 Sec. 24 Twp. 26 R. 4Well No. 5 Harmon FarmRamsey Oil Company

NORTH

WEST

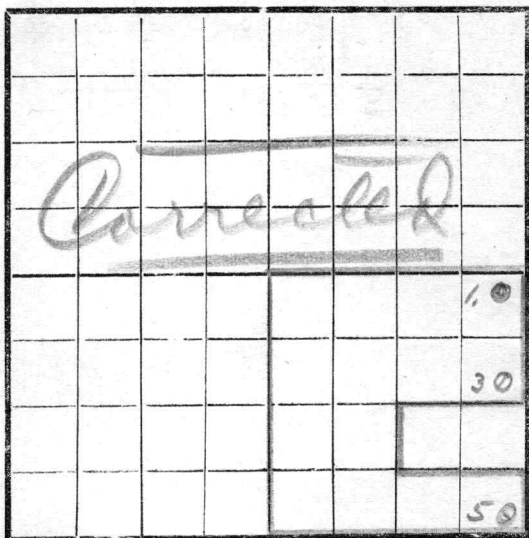

EAST

SOUTH

Location -----

Rig Up -----

Drilling and remarks -----

Plot of Ramsey
Oil Co's Accey
line 24-26-4

RECORD

Cased ----- in. ----- Ft.

Sand -----

Gas -----

Oil -----

Total Depth -----

PRODUCTION

1st 24 hrs. Nat. -----

1st 24 hrs. after shot -----

Gas ----- Cu. Ft.

Dry Hole -----

Abandoned -----


Date

1/29, 1918 C. C. C. C. Scout

Map No. _____ Sec. 24 Twp. 26 R. 4
 Well No. 55 Ramsey Farm
Ramsey Oil Company

NORTH

WEST

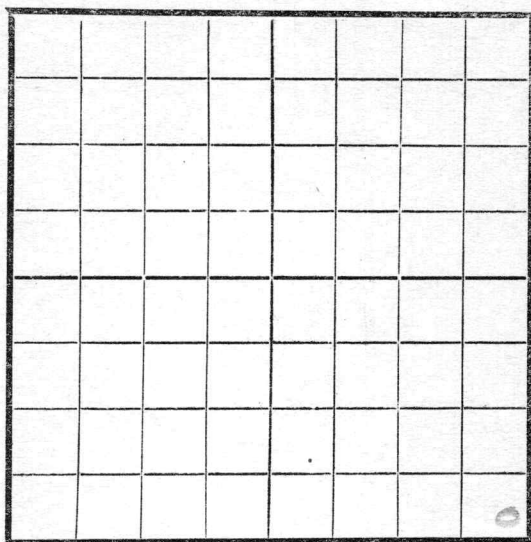

EAST

SOUTH

Location _____

Rig Up _____

Drilling and remarks

2560

RECORD

Cased _____ in. _____ Ft.

Sand _____

Gas _____

Oil _____

Total Depth _____

PRODUCTION

1st 24 hrs. Nat. _____

1st 24 hrs. after shot _____

Gas _____ Cu. Ft.


Dry Hole _____

Abandoned _____

Date

1/30, 1918 Scout

Map No. _____ Sec. 24 Twp. 26 R. 4
Well No. 5 Harmon Farm _____
Conroy Oil Company _____
Date Started _____ Ft. from N _____ S _____ E _____ W _____ line
NORTH

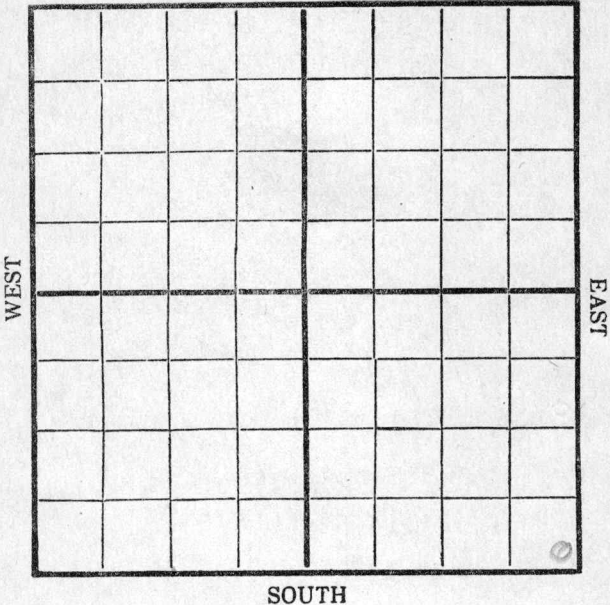

SOUTH

Cased _____ In. _____ Ft. _____	Production Remarks
Sand _____	
Pay { Gas _____	
Oil _____	
Total Depth _____	


Condition of Well on this date 2/6/18

22 2560

Conroy Scout

Map No. _____ Sec. 24 Twp. 26 R. 4Well No. 5 Harmon Farm
Ramsay Oil Company
NORTH

WEST

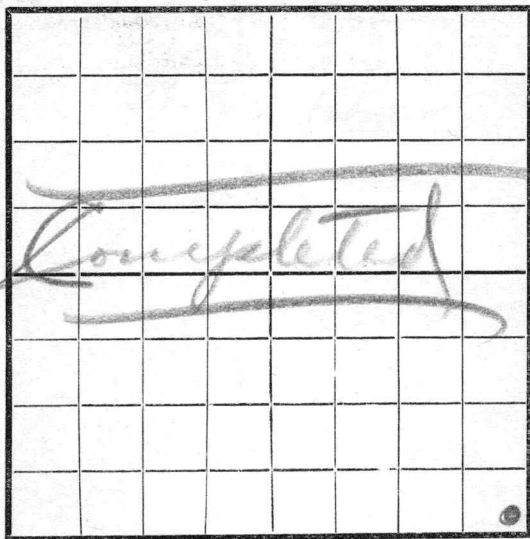

EAST

SOUTH

Location _____

Rig Up _____

Drilling and remarks

*Estimated
at 400 Bbls*

RECORD

Cased _____ in. _____ Ft.

Sand 2650-2666

Gas _____

Oil _____

Total Depth _____

PRODUCTION

1st 24 hrs. Nat. _____

1st 24 hrs. after shot _____

Gas _____ Cu. Ft.

Dry Hole _____

Abandoned _____

Date

2/13, 1918 C. C. C. C. Scout