


Well No. 6 Normans Farm

Ramsey Put Company

NORTH

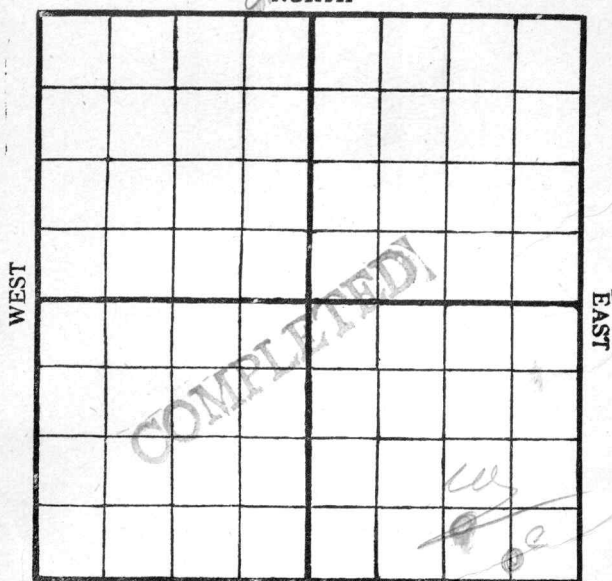

SOUTH

Rig Up

Drilling Remarks:

RECORD

PRODUCTION

Cased_____ in._____ ft.

1st 24 hrs. Nat.-----

Sand _____

1st 24 hrs. after shot-----

Gas _____

Gas----- cu. ft

Oil -----

Dry Hole -----


Total Depth_____

Abandoned -----

Map No. K14 Sec. 24 Twp. 26 R. 4Well No. 6 Harmon Farm
Ramsey Petro Company

NORTH

WEST

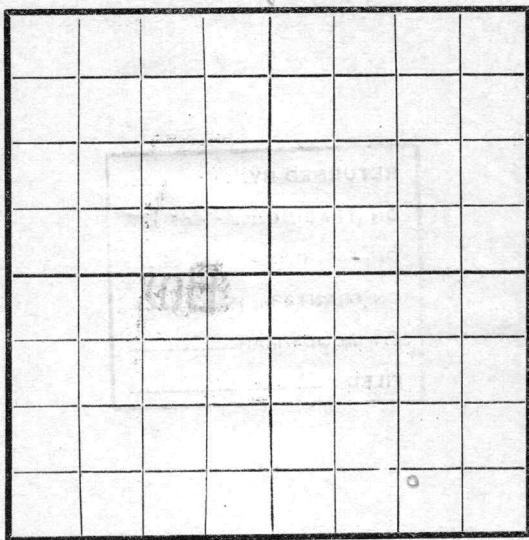

EAST

SOUTH

Location ✓Rig Up ✓

Drilling and remarks

RECORD

Cased _____ in. _____ Ft.

Sand _____

Gas _____

Oil _____

Total Depth _____

FIRST REPORT

PRODUCTION

1st 24 hrs. Nat. _____

1st 24 hrs. after shot _____

Gas _____ Cu. Ft.

Dry Hole _____

Abandoned _____


Date

3/3, 1918 C. C. C. C. Scout

Map No. _____ Sec. 24 Twp. 26 R. 4Well No. 6 Johnson Farm _____Ramsey Petroleum Company _____

NORTH

WEST

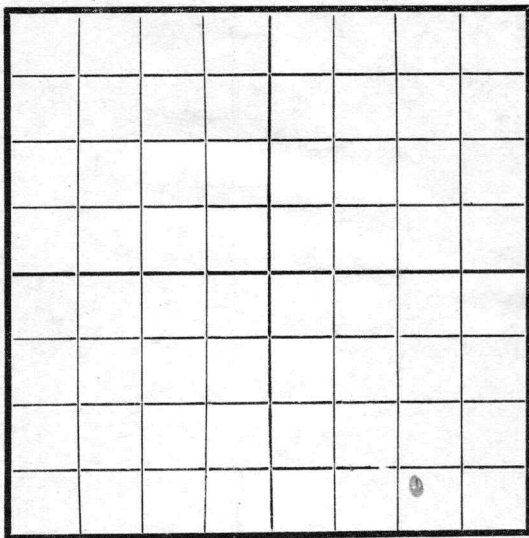

EAST

SOUTH

Location _____

Rig Up _____

Drilling and remarks

RECORD

Cased _____ in. _____ Ft.

Sand _____

Gas _____

Oil _____

Total Depth _____

PRODUCTION

1st 24 hrs. Nat. _____

1st 24 hrs. after shot _____

Gas _____ Cu. Ft.

Dry Hole _____

Abandoned _____


Date

3/27, 1918 S. C. Cady Scout

Map No. K14 Sec. 24 Twp. 26 R. 4Well No. 6 Harmon FarmRamsey Bros Company

NORTH

WEST

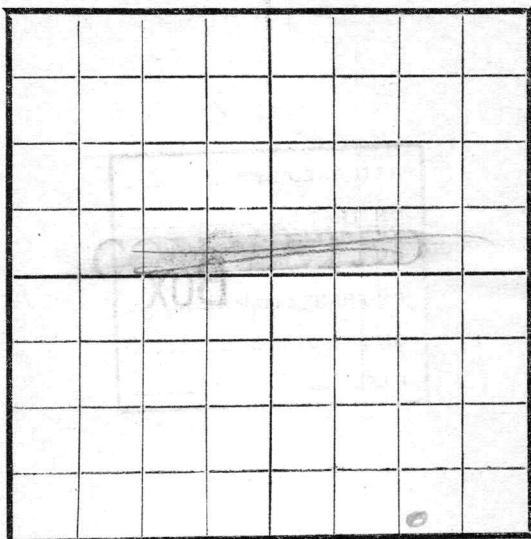

EAST

SOUTH

Location ✓Rig Up ✓

Drilling and remarks

FIRST REPORT**RECORD**

Cased _____ in _____ Ft.

Sand _____

Gas _____

Oil _____

Total Depth _____

PRODUCTION

1st 24 hrs. Nat. _____

1st 24 hrs. after shot _____

Gas _____ Cu. Ft.

Dry Hole _____

Abandoned _____


Date

5/1, 1918 Candley Scout

Map No. K14 Sec. 24 Twp. 26 R. 4Well No. 6 Harmon FarmRoussy Petroleum Company

NORTH

WEST

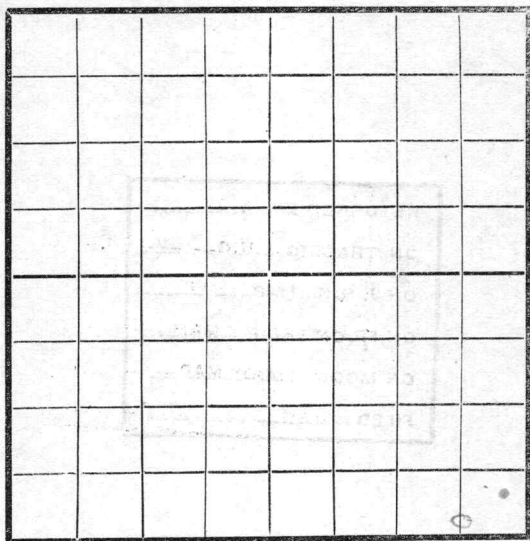

EAST

SOUTH

Location corrected

Rig Up _____

Drilling and remarks

490Frost Drill Co& Howard

RECORD

Cased _____ in. _____ Ft.

Sand _____

Gas _____

Oil _____

Total Depth _____

PRODUCTION

1st 24 hrs. Nat. _____

1st 24 hrs. after shot _____

Gas _____ Cu. Ft.

Dry Hole _____

Abandoned _____


Date

5/15, 1918 Conley Scout

Map No. K14 Sec. 24 Twp. 26 R. 4Well No. 6 Harmon FarmRamsay Petroleum Company

NORTH

WEST

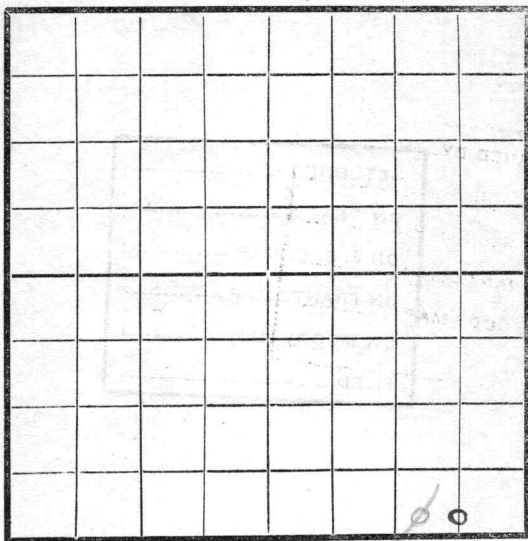

EAST

SOUTH

Location -----

Rig Up -----

Drilling and remarks

voidLocated wrongPlease make change

RECORD

Cased ----- in. ----- Ft.

Sand -----

Gas -----

Oil -----

Total Depth -----

PRODUCTION

1st 24 hrs. Nat. -----

1st 24 hrs. after shot -----

Gas ----- Cu. Ft.

Dry Hole -----

Abandoned -----

Date

5/5, 1918 C. Condy Scout

Map No. _____ Sec. 24 Twp. 36 R. 4Well No. 65 Farm __________
Company

NORTH

WEST

EAST

SOUTH

Location _____

Rig Up _____

Drilling and remarks

RECORD

Cased _____ in. _____ Ft.

Sand _____

Gas _____

Oil _____

Total Depth _____

PRODUCTION

1st 24 hrs. Nat. _____

1st 24 hrs. after shot _____

Gas _____ Cu. Ft.

Dry Hole _____

Abandoned _____


Date

5/22, 1918 _____ Scout

Map No. _____ Sec. 24 Twp. 26 R. 4Well No. 6 Ramsey FarmRamsey Petro Company

NORTH

WEST

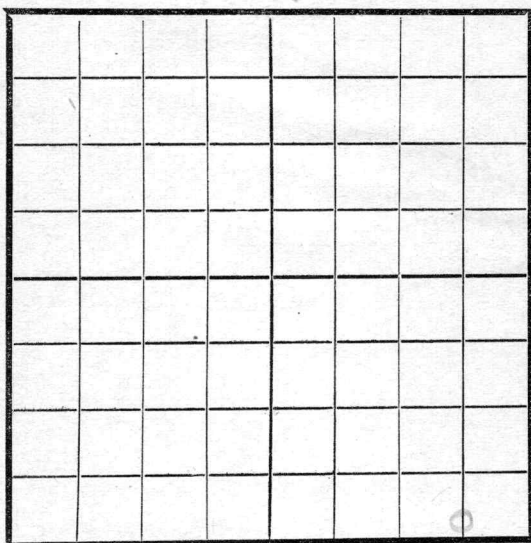

EAST

SOUTH

Location _____

Rig Up _____

Drilling and remarks

1360

RECORD

Cased _____ in _____ Ft.

Sand _____

Gas _____

Oil _____

Total Depth _____

PRODUCTION

1st 24 hrs. Nat. _____

1st 24 hrs. after shot _____

Gas _____ Cu. Ft.

Dry Hole _____

Abandoned _____

Date

5/29, 1918 O. C. Candy Scout


Map No. _____ Sec. 24 Twp. 26 R. 4

Well No. 6

Rainbow Petro Company

Contractor

NORTH

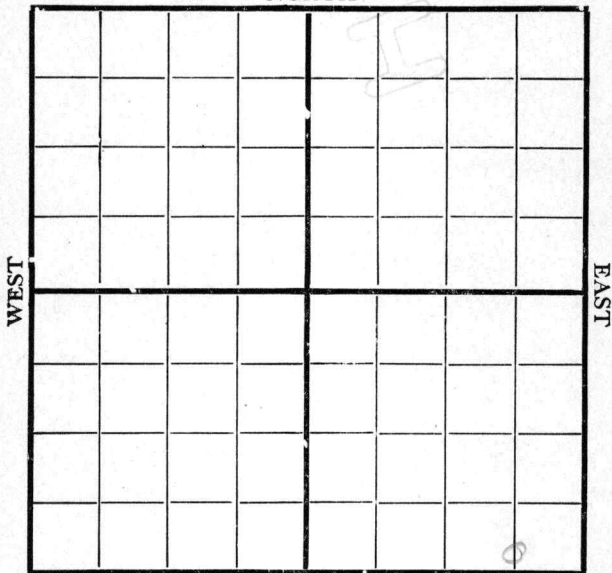

SOUTH

Location _____

Rig up _____

Drilling and Remarks:

22 1360

RECORD

Cased _____ in., _____ ft.

Sand _____

Gas _____

Oil _____

Total Depth _____

PRODUCTION

1st 24 hrs. Nat. _____

1st 24 hrs. after shot _____

Gas _____ Cu. Ft.

Dry Hole _____

Abandoned _____

Date

6/5 1918 Scout

Map No. _____ Sec. 24 Twp. 26 R. 4Well No. 6 HarmonHarmon Petro Company

Contractor _____

NORTH

WEST

EAST

SOUTH

Location _____

Rig up _____

Drilling and Remarks:

1870**RECORD**

Cased _____ in., _____ ft.

Sand _____

Gas _____

Oil _____

Total Depth _____

PRODUCTION

1st 24 hrs. Nat. _____

1st 24 hrs. after shot _____

Gas _____ Cu. Ft.

Dry Hole _____


Abandoned _____

Date

6/10 191 S. C. Cady Scout

Map No. _____ Sec. 24 Twp. 26 R. 4Well No. 6 HammBarney Petro Company_____
Contractor

NORTH

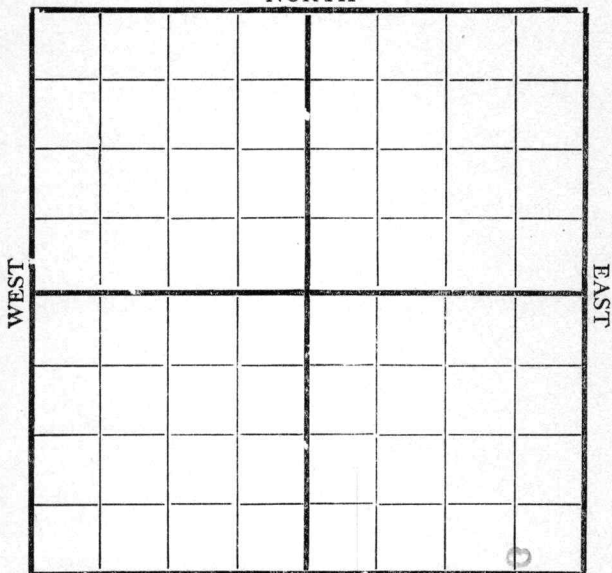

SOUTH

Location _____

Rig up _____

Drilling and Remarks:

7210**RECORD**

Cased _____ in., _____ ft.

Sand _____

Gas _____

Oil _____

Total Depth _____

PRODUCTION

1st 24 hrs. Nat. _____

1st 24 hrs. after shot _____

Gas _____ Cu. Ft.

Dry Hole _____

Abandoned _____

Date

6/19 191 8 Carly Scout

Map No. _____ Sec. 24 Twp. 26 R. 4


Well No. 6 Harmon

Pansey P. Co. Company

Contractor

NORTH

WEST

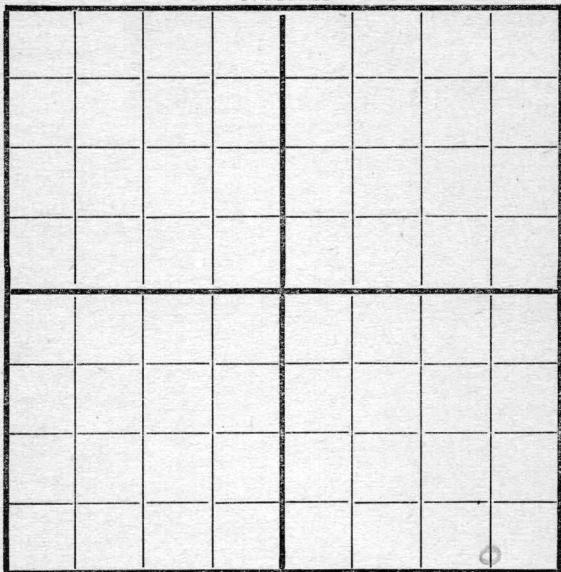

EAST

SOUTH

Location _____

Rig up _____

Drilling and Remarks:

2500

RECORD

Cased _____ in., _____ ft.

Sand _____

Gas _____

Oil _____

Total Depth _____

PRODUCTION

1st 24 hrs. Nat. _____

1st 24 hrs. after shot _____

Gas _____ Cu. Ft.

Dry Hole _____

Abandoned _____

Date

4/26

191

8 C. Co.

Scout


Map No. _____ Sec. 24 Twp. 36 R. 4Well No. 6 HarmonCompany Ramsay Peter

Contractor _____

NORTH

WEST

EAST

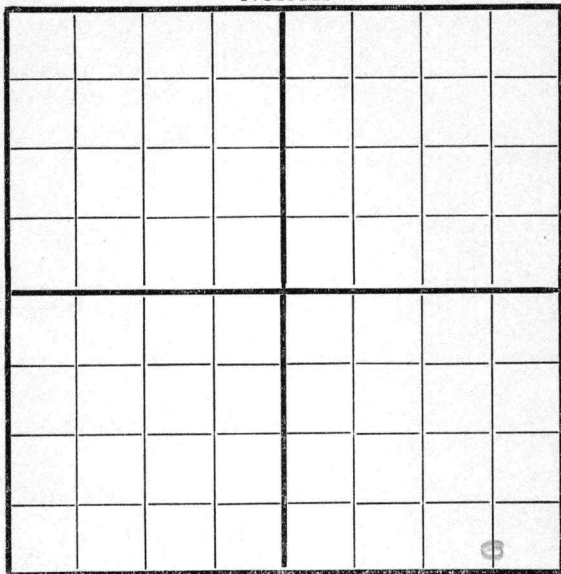

SOUTH

Location _____

Rig up _____

Drilling and Remarks:

Top sand
2659

RECORD

Cased _____ in., _____ ft.

Sand _____

Gas _____

Oil _____

Total Depth _____

PRODUCTION

1st 24 hrs. Nat. _____

1st 24 hrs. after shot _____

Gas _____ Cu. Ft.

Dry Hole _____


Abandoned _____

Date

7/3 191 *S. C. Andy* Scout

Map No. K/H Sec. 24 Twp. 26 R. 4Well No. 6 HarmonRumsey Petro CompanyFrost Drilling Co ContractorEl Dorado NORTH OK

WEST

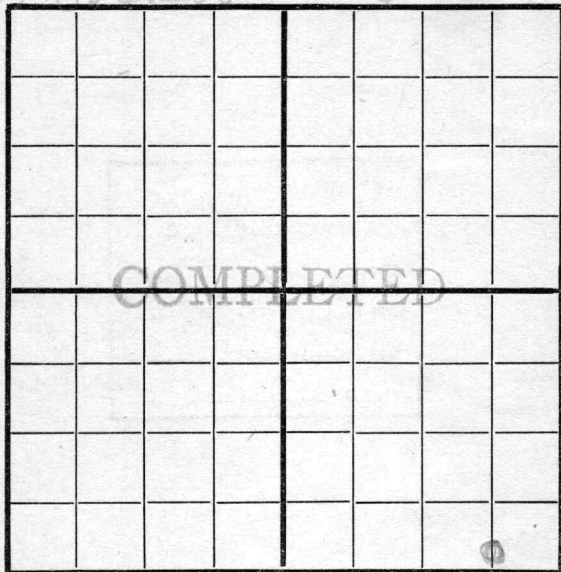

EAST

SOUTH

RECORD

Location _____

Cased _____ in., _____ ft.

Rig up _____

Sand 2659-2677

Drilling and Remarks:

Gas _____

Oil _____

Total Depth _____

PRODUCTION

1st 24 hrs. Nat. _____

1st 24 hrs. after shot _____

Gas _____ Cu. Ft.

Dry Hole _____

Abandoned _____

Date

7/9

191

J. C. Cady Scout