


Map No. 14 Sec. 24 Twp. 26 R. 4

Well No. 9 Harmon Farm

Ramsey Petroleum Company

NORTH

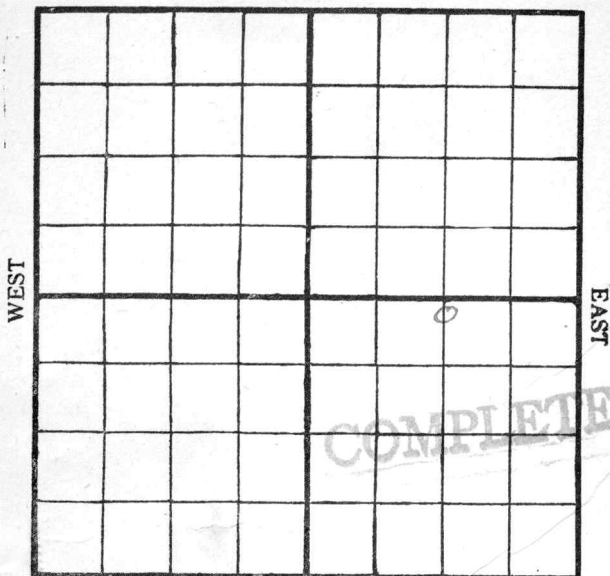

SOUTH

Location -----

Rig Up -----

Drilling Remarks:

Drilling Remarks:

RECORD

Cased ----- in. ----- ft.

Sand -----

Cas -----

Oil -----

Total Depth -----

PRODUCTION

1st 24 hrs. Nat. -----


1st 24 hrs. after shot -----

Gas ----- cu. ft.

Dry Hole -----

Abandoned -----

Map No. K14 Sec. 24 Twp. 26 R. 4
Well No. 5 Harmon
Ramsey Pctn Company _____
Contractor _____

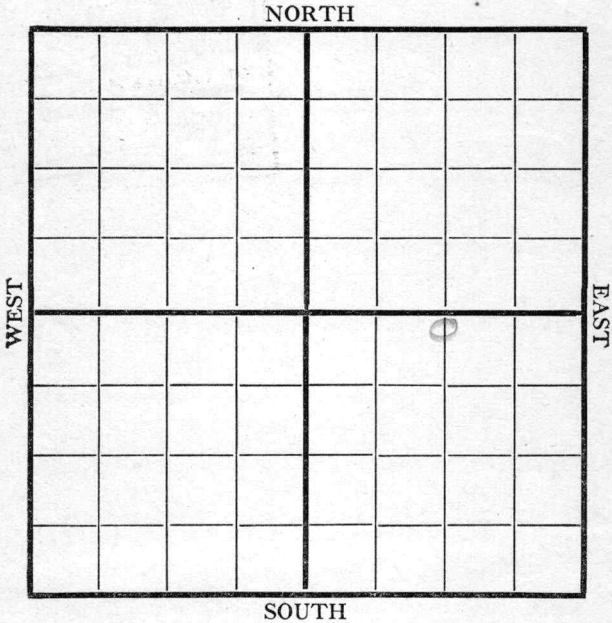

RECORD	
Location _____	Cased _____ in., _____ ft.
Rig up _____	Sand _____
Drilling and Remarks:	Gas _____
	Oil _____
	Total Depth _____
	PRODUCTION
FIRST REPORT	1st 24 hrs. Nat. _____
	1st 24 hrs. after shot _____
	Gas _____ Cu. Ft.
	Dry Hole _____
	Abandoned _____

Date 7/24 1918 Scout

Map No. _____ Sec. 24 Twp. 26 R. 4Well No. 9 _____


Company _____

Contractor _____

NORTH

WEST

EAST

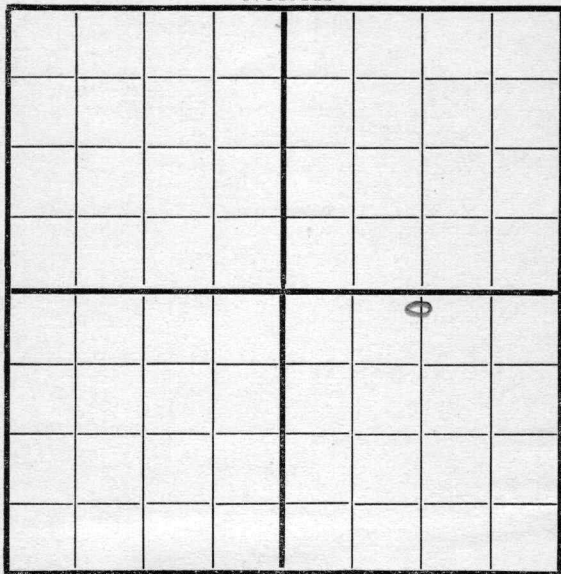

SOUTH

Location 1320 E 200 N

Rig up _____

Drilling and Remarks:

600

RECORD

Cased _____ in., _____ ft.

Sand _____

Gas _____

Oil _____

Total Depth _____

PRODUCTION

1st 24 hrs. Nat. _____

1st 24 hrs. after shot _____

Gas _____ Cu. Ft.

Dry Hole _____

Abandoned _____

Date

8/7

191


8C. C. C. C.

Scout

Map No. _____ Sec. 24 Twp. 26 R. W
Well No. 9 _____ Company _____
Contractor _____

NORTH

WEST

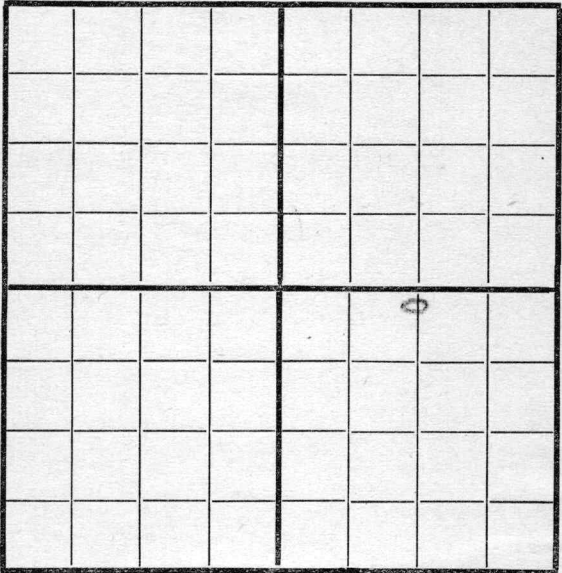

EAST

SOUTH

Location 200N
13208

Rig up _____

Drilling and Remarks:

D. H. for
water @
600'

RECORD

Cased _____ in., _____ ft.

Sand _____

Gas _____

Oil _____

Total Depth _____

PRODUCTION

1st 24 hrs. Nat. _____

1st 24 hrs. after shot _____


Gas _____ Cu. Ft.

Dry Hole _____

Abandoned _____

Date

8/15 1918 Oyle Scout

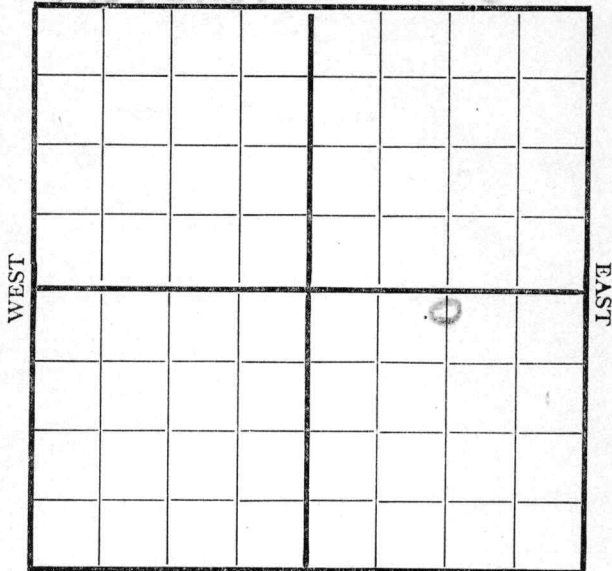Map No. _____ Sec. 24 Twp. 26 R. 4Well No. 9 HarmonPrimary P. Co. CompanyFront Drilling Co. ContractorE. J. D. Co. NORTH

SOUTH

Location _____

Rig up _____

Drilling and Remarks:

DD for
water @
600'

RECORD

Cased _____ in., _____ ft.

Sand _____

Gas _____

Oil _____

Total Depth _____

PRODUCTION

1st 24 hrs. Nat. _____

1st 24 hrs. after shot _____

Gas _____ Cu. Ft.

Dry Hole _____

Abandoned _____

Date

8/23

191

Pyle

Scout

Map No. K14 Sec. 24 Twp. 26 R. 4

Well No. 9


Ramsey Petro Company

Contractor

NORTH

WEST

EAST

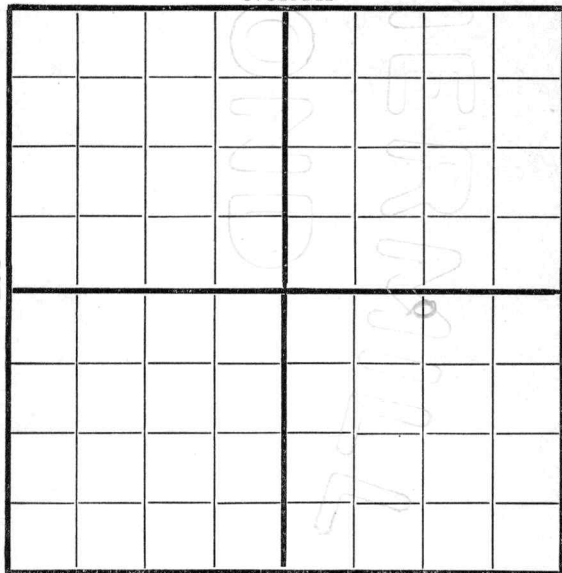

SOUTH

2008/1320 E

Location _____

Rig up _____

Drilling and Remarks:

Shut Down
600

RECORD

Cased _____ in., _____ ft.

Sand _____

Gas _____

Oil _____

Total Depth _____

PRODUCTION

1st 24 hrs. Nat. _____

1st 24 hrs. after shot _____

Gas _____ Cu. Ft.

Dry Hole _____

Abandoned _____

Date

8/28/8 Scout

Map No. K14 Sec. 24 Twp. 26 R. 4Well No. 9 Hammer
Ramsey Petro Company
Contractor

NORTH

WEST

EAST

SOUTH

Location _____

Rig up _____

Drilling and Remarks:

RECORD

Cased _____ in., _____ ft.

Sand _____

Gas _____

Oil _____

Total Depth _____

PRODUCTION

1st 24 hrs. Nat. _____

1st 24 hrs. after shot _____


Gas _____ Cu. Ft.

Dry Hole _____

Abandoned _____

Date

Map No. 1514 Sec. 24 Twp. 26 R. 4
 Well No. 9 Hammer
Ramsey Petro Company
 Contractor

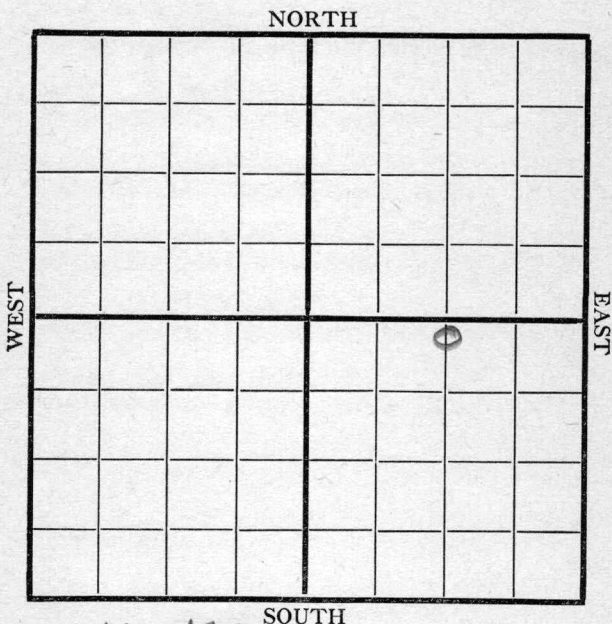

200 X - 1320 E

Location _____

Rig up _____

Drilling and Remarks:

750

RECORD

Cased _____ in., _____ ft.

Sand _____

Gas _____

Oil _____

Total Depth _____

PRODUCTION

1st 24 hrs. Nat. _____

1st 24 hrs. after shot _____

Gas _____ Cu. Ft.

Dry Hole _____

Abandoned _____

Date


9/11 1911 P. Landry Scout

Map No. 1514 Sec. 24 Twp. 26 R. 4Well No. 9 Harmon
Ramsay Peter Company
Contractor

NORTH

WEST

EAST

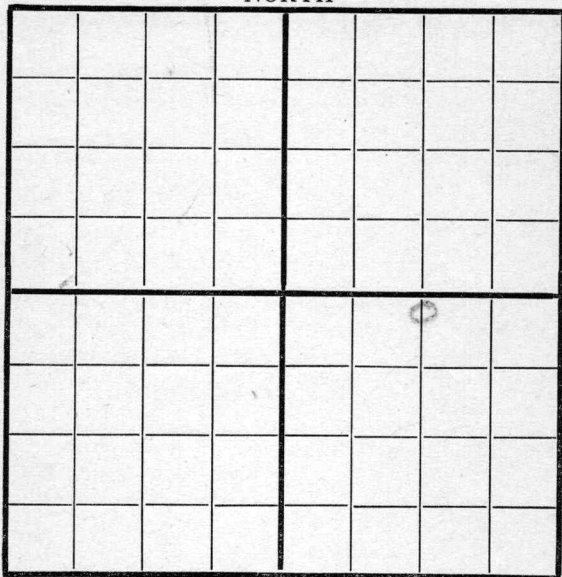

SOUTH

200 X - 1320

Location _____

Rig up _____

Drilling and Remarks:

RECORD

Cased _____ in., _____ ft.

Sand _____

Gas _____

Oil _____

Total Depth _____

PRODUCTION

1st 24 hrs. Nat. _____

1st 24 hrs. after shot _____

Gas _____ Cu. Ft.

Dry Hole _____

Abandoned _____

Date

9/18 191 8 C. C. C. Scout


Map No. K14 Sec. 24 Twp. 26 R. 4Well No. 9 Harmon
Ramsey Petro Company

Contractor

NORTH

WEST

EAST

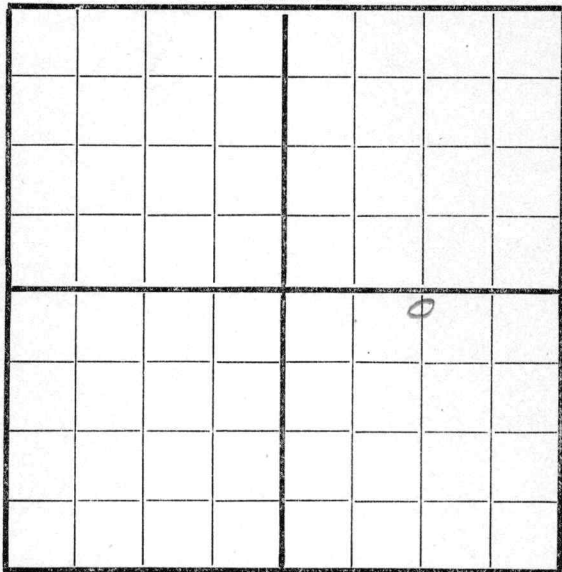

SOUTH

2005-1320 E

Location _____

Rig up _____

Drilling and Remarks:

1380

RECORD

Cased _____ in., _____ ft.

Sand _____

Gas _____

Oil _____

Total Depth _____

PRODUCTION

1st 24 hrs. Nat. _____

1st 24 hrs. after shot _____

Gas _____ Cu. Ft.

Dry Hole _____

Abandoned _____

Date

9/25 191 8 Candiff Scout


Map No. 1514 Sec. 24 Twp. 26 R. 4Well No. 9 HarmonRamsey Petro Company

Contractor

NORTH

WEST

EAST

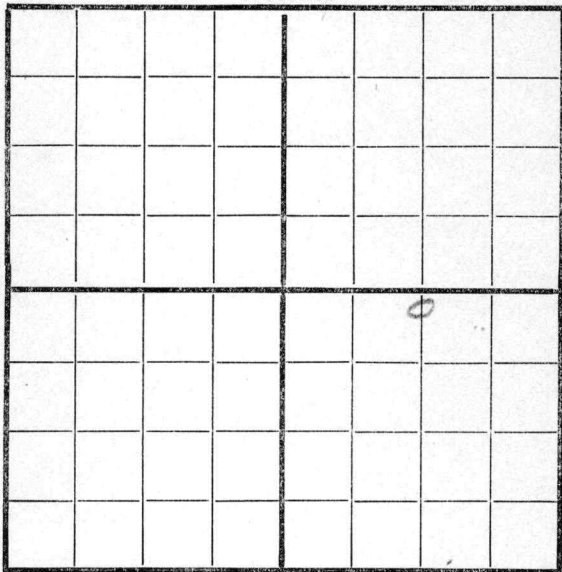

SOUTH

2005-1320 E

Location _____

Rig up _____

Drilling and Remarks:

1800

RECORD

Cased _____ in., _____ ft.

Sand _____

Gas _____

Oil _____

Total Depth _____

PRODUCTION

1st 24 hrs. Nat. _____

1st 24 hrs. after shot _____

Gas _____ Cu. Ft.


Dry Hole _____

Abandoned _____

Date

10/2 191 S. C. C. C. Scout

Map No. K14 Sec. 24 Twp. 26 R. 4
 Well No. 9 Harmon
Ramsey Petro Company
 Contractor

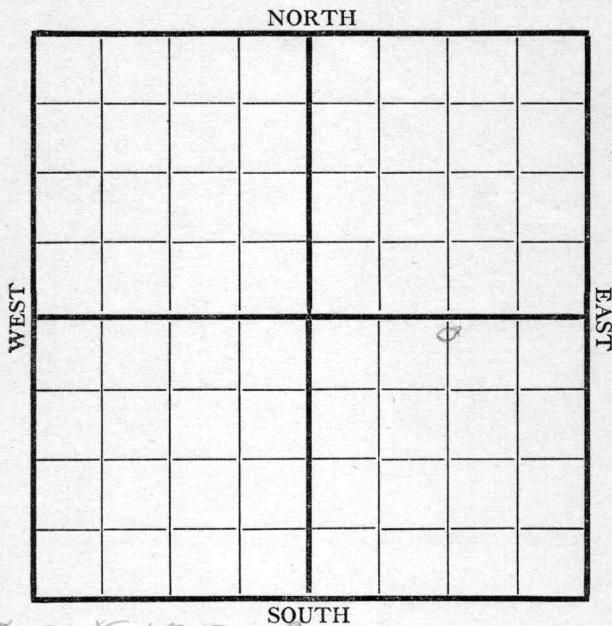

20081370 E

	RECORD
Location _____	Cased _____ in., _____ ft.
Rig up _____	Sand _____
Drilling and Remarks:	Gas _____
	Oil _____
	Total Depth _____
	PRODUCTION
	1st 24 hrs. Nat. _____
	1st 24 hrs. after shot _____
	Gas _____ Cu. Ft.
	Dry Hole _____
	Abandoned _____

Date 10/9 1918 Scout


Map No. 1K14 Sec. 24 Twp. 26 R. 4Well No. 9 HammerRamsey P. Co. Company

Contractor

NORTH

WEST

EAST

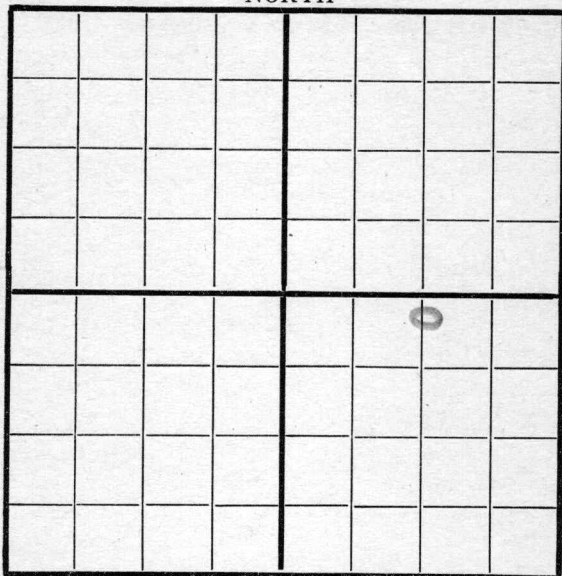

SOUTH

Location _____

Rig up _____

Drilling and Remarks:

2550

RECORD

Cased _____ in., _____ ft.

Sand _____

Gas _____

Oil _____

Total Depth _____

PRODUCTION

1st 24 hrs. Nat. _____

1st 24 hrs. after shot _____

Gas _____ Cu. Ft.


Dry Hole _____

Abandoned _____

Date

10/16 1918 C. Ramsey Scout

Map No. 1514 Sec. 24 Twp. 26 R. 4
Well No. 9
Company Ramsay Bros
Contractor Frost Drilling Co.
El. Dr. 110' NORTH

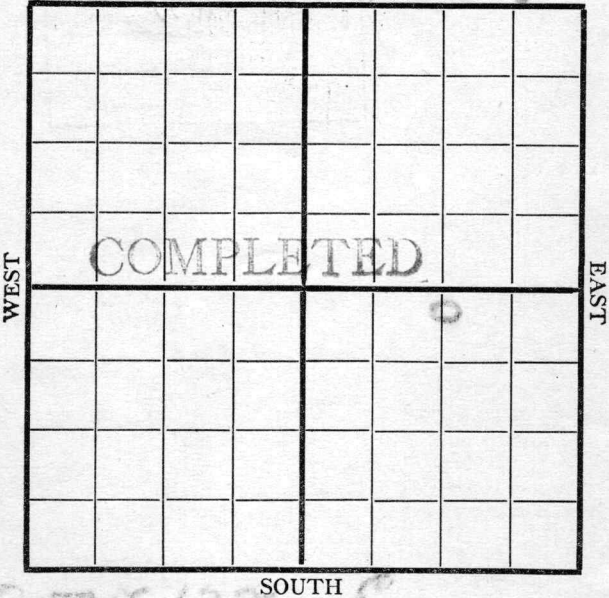

20715 1370 E

	RECORD
Location _____	Cased _____ in., _____ ft.
Rig up _____	Sand <u>2624-2640</u>
Drilling and Remarks: <u>Est at</u> <u>50</u> <u>Bbl</u>	Gas _____
	Oil _____
	Total Depth _____
	PRODUCTION
	1st 24 hrs. Nat. _____
	1st 24 hrs. after shot _____
	Gas _____ Cu. Ft.
	Dry Hole _____
	Abandoned _____

Date 10/24 1918 8 Carley Scout