


Map No. _____ Sec. 24 Twp. 26 R. 4

Well No. 13 Harmon Farm _____
Ramsey Pet. Company

NORTH

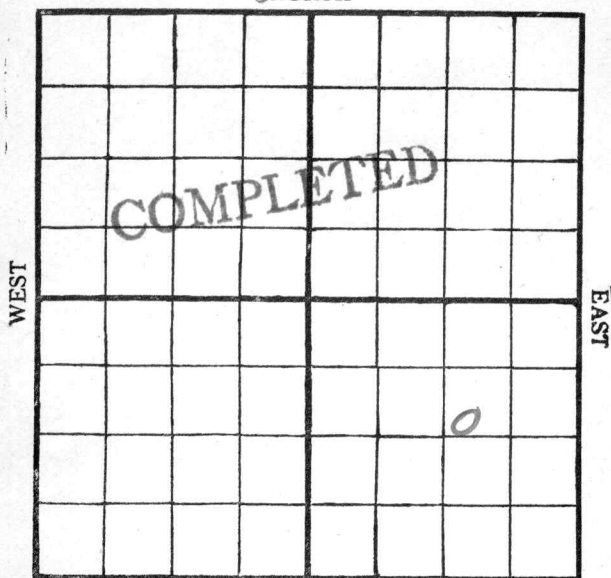

SOUTH

Location _____

Rig Up _____

Drilling Remarks:

noobies (Sand 2648-2666)

5/30/

Drilling Remarks:

RECORD

Cased _____ in. _____ ft.

Sand _____

Gas _____

Oil _____

Total Depth _____

PRODUCTION

1st 24 hrs. Nat. _____

1st 24 hrs. after shot _____

Gas _____ cu. ft.

Dry Hole _____

Abandoned _____

Map No. _____ Sec. 24 Twp. 26 R. 4



NORTH

WEST

EAST

SOUTH

Location _____

Rig up _____

Drilling and Remarks:

RECORD

Cased _____ in., _____ ft.

Sand _____

Gas _____

Oil _____

Total Depth _____

PRODUCTION

1st 24 hrs. Nat. _____

1st 24 hrs. after shot _____

Gas _____ Cu. Ft.

Dry Hole _____

Abandoned _____

FIRST REPORT


Date

4/4 191 8 Conroy Scout

Map No. _____ Sec. 24 Twp. 26 R. 4Well No. 13 Harmon Farm
Ramsey Petro Company

NORTH

WEST

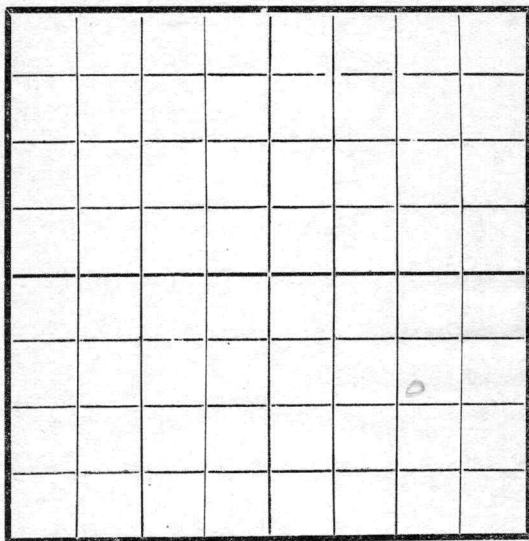

EAST

SOUTH

Location _____

Rig Up _____

Drilling and remarks

735Frost Drilling Co.
Q. L. D. No. 735

RECORD

Cased _____ in. _____ Ft.

Sand _____

Gas _____

Oil _____

Total Depth _____

PRODUCTION

1st 24 hrs. Nat. _____

1st 24 hrs. after shot _____

Gas _____ Cu. Ft.

Dry Hole _____

Abandoned _____

Date


5/1, 1918 C. L. D. Scout

Map No. _____ Sec. 24 Twp. 26 R. 4

Well No. 13 Harmon Farm
Raymond P. Harmon Company

NORTH

WEST

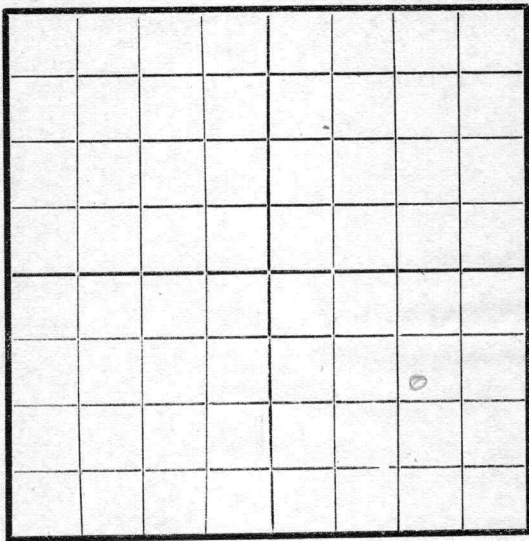

EAST

SOUTH

RECORD

Location _____

Cased _____ in. _____ Ft.

Rig Up _____

Sand _____

Drilling and remarks

Gas _____

Oil _____

Total Depth _____

PRODUCTION

1st 24 hrs. Nat. _____

1st 24 hrs. after shot _____

Gas _____ Cu. Ft.

Dry Hole _____

Abandoned _____


Date

578, 1918 Scout

Map No. _____ Sec. 24 Twp. 26 R. 4Well No. 13 Hammer Farm
Ramsey Peltier Company

NORTH

WEST

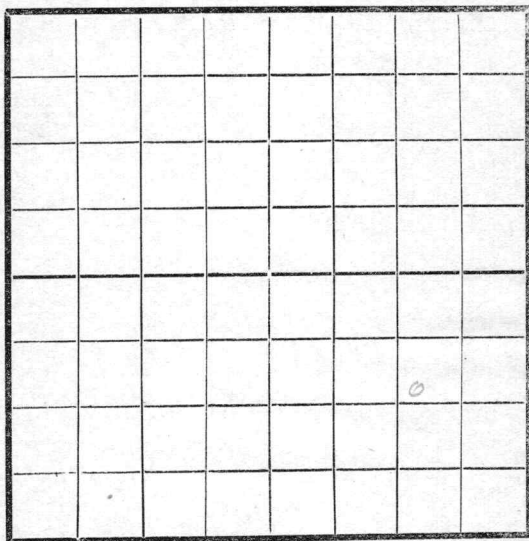

EAST

SOUTH

Location _____

Rig Up _____

Drilling and remarks

2135

RECORD

Cased _____ in. _____ Ft.

Sand _____

Gas _____

Oil _____

Total Depth _____

PRODUCTION

1st 24 hrs. Nat. _____

1st 24 hrs. after shot _____

Gas _____ Cu. Ft.

Dry Hole _____

Abandoned _____

Date

5/15, 1918 Campbell Scout


Map No. _____ Sec. 24 Twp. 26 R. 4

Well No. 3 Koimau Farm
Ramsay Petro Company

NORTH

WEST

EAST

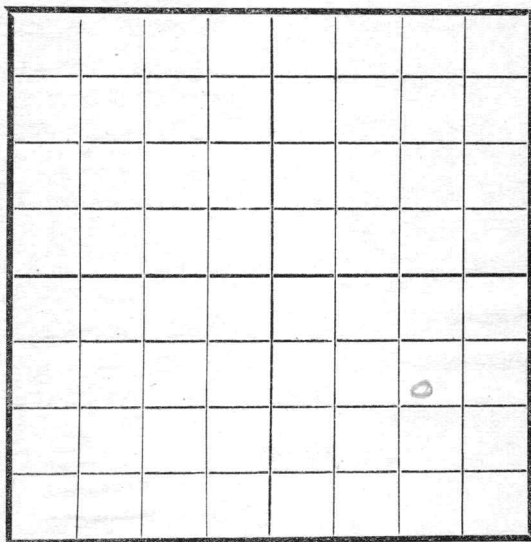

SOUTH

Location _____

Rig Up _____

Drilling and remarks

2495

RECORD

Cased _____ in. _____ Ft.

Sand _____

Gas _____

Oil _____

Total Depth _____

PRODUCTION

1st 24 hrs. Nat. _____

1st 24 hrs. after shot _____

Gas _____ Cu. Ft.

Dry Hole _____

Abandoned _____

Date


5/22, 1918 Clady Scout

Map No. 114 Sec. 24 Twp. 26 R. 4Well No. 13 Farm Barney Peter

Company

NORTH

WEST

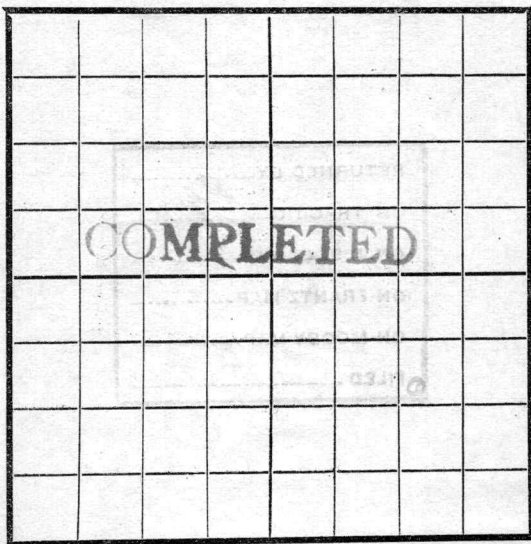

EAST

SOUTH

Location -----

Rig Up -----

Drilling and remarks

Exp at
200
Bbls

RECORD

Cased ----- in. ----- Ft.

Sand 2648-2666

Gas -----

Oil -----

Total Depth -----

PRODUCTION

1st 24 hrs. Nat. -----

1st 24 hrs. after shot -----

Gas ----- Cu. Ft.

Dry Hole -----

Abandoned -----

Date

730, 1918 Scout