


Map No. _____ Sec. 24 Twp. 26 R. 4
 Well No. 16 Harmon Farm _____
Ramsay Plt Company _____

NORTH

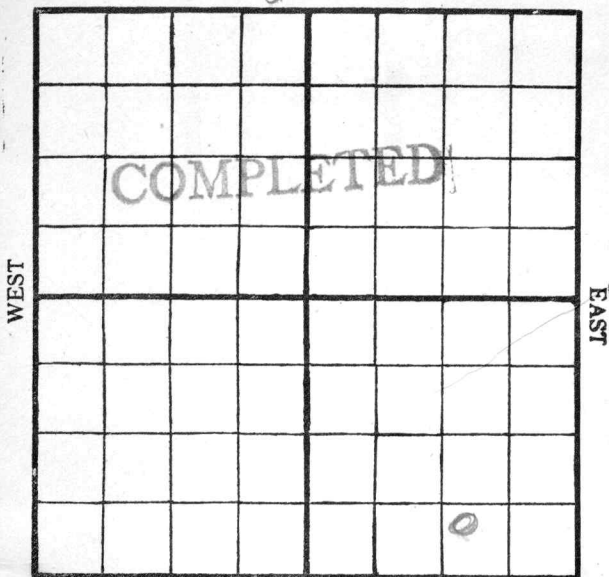

SOUTH

Location _____

Rig Up _____

Drilling Remarks:

150 Bbs (Aval 2658-2672)

Drilling Remarks:

5/22/18

RECORD

Cased _____ in. _____ ft.

Sand _____

Gas _____

Oil _____

Total Depth _____

PRODUCTION

1st 24 hrs. Nat. _____

1st 24 hrs. after shot _____

Gas _____ cu. ft.


Dry Hole _____

Abandoned _____

Map No. _____ Sec. 24 Twp. 26 R. 4Well No. 16 Harmon Farm
Ramsey Petroleum Company

NORTH

WEST

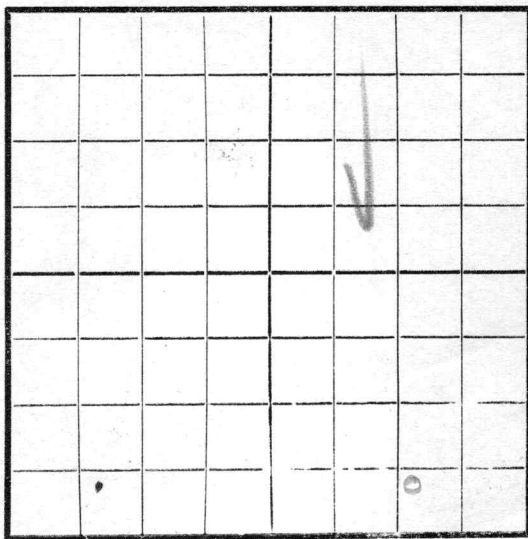

EAST

SOUTH

Location _____

Rig Up _____

Drilling and remarks

700

RECORD

Cased _____ in. _____ Ft.

Sand _____

Gas _____

Oil _____

Total Depth _____

PRODUCTION

1st 24 hrs. Nat. _____

1st 24 hrs. after shot _____

Gas _____ Cu. Ft.

Dry Hole _____

Abandoned _____

Date

APR 3 1918

, 191


Carley

Scout

Map No. _____ Sec. 24 Twp. 26 R. 4
 Well No. 16 Harmon
Ramsay Petro Company

NORTH

WEST

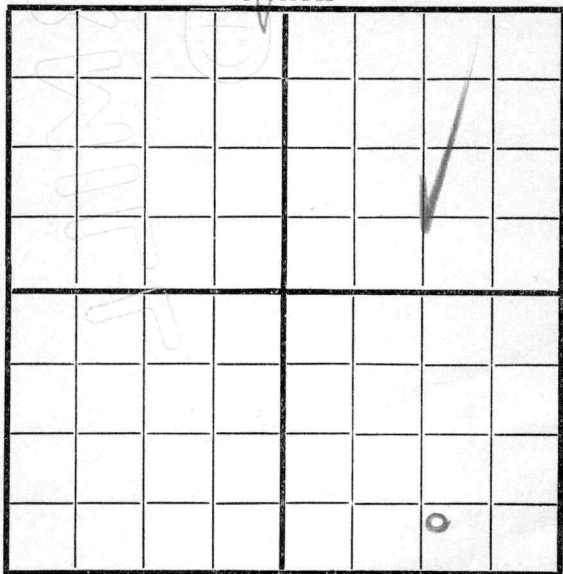

EAST

SOUTH

Location _____

Rig up _____

Drilling and Remarks:

310Frost Drilling Co

RECORD

Cased _____ in., _____ ft.

Sand _____

Gas _____

Oil _____

Total Depth _____

PRODUCTION

1st 24 hrs. Nat. _____

1st 24 hrs. after shot _____

Gas _____ Cu. Ft.

Dry Hole _____

Abandoned _____

Date


4/4 191 8Scout

Map No. _____ Sec. 24 Twp. 26 R. 4
 Well No. 6 Harmon
Ramsey Peter Company

NORTH

WEST

EAST

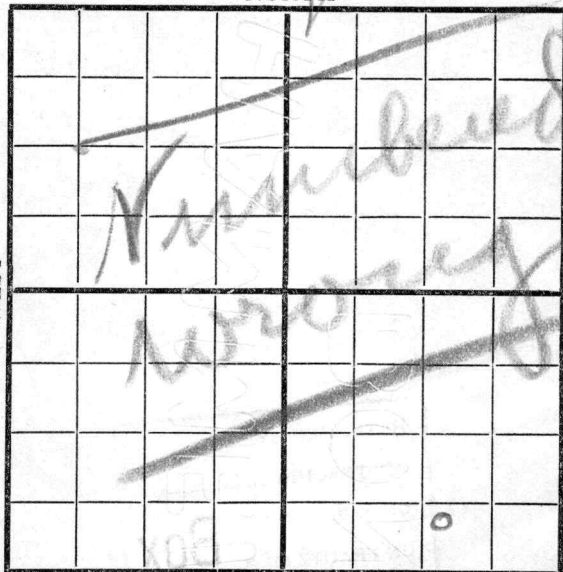

SOUTH

Location _____

Rig up _____

Drilling and Remarks:

*Number
 Changed
 from #6 to
 #16*

RECORD

Cased _____ in., _____ ft.

Sand _____

Gas _____

Oil _____

Total Depth _____

PRODUCTION

1st 24 hrs. Nat. _____

1st 24 hrs. after shot _____

Gas _____ Cu. Ft.

Dry Hole _____

Abandoned _____

Date

4/4 191

Scout

Map No. _____ Sec. 24 Twp. 36 R. 4


Well No. 16 Harmon Farm

Ross & Peterson Company

NORTH

WEST

EAST

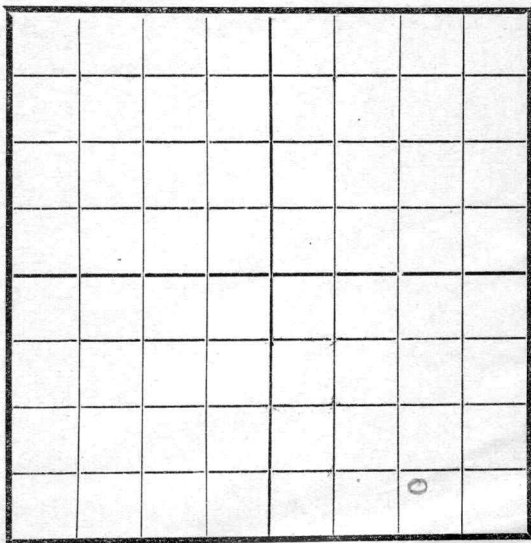

SOUTH

Location _____

Rig Up _____

Drilling and remarks

1000

RECORD

Cased _____ in. _____ Ft.

Sand _____

Gas _____

Oil _____

Total Depth _____

PRODUCTION

1st 24 hrs. Nat. _____

1st 24 hrs. after shot _____

Gas _____ Cu. Ft.

Dry Hole _____

Abandoned _____


Date

4/10, 1911 S. C. Anderson Scout

Map No. _____ Sec. 34 Twp. 36 R. 4Well No. 16 Harmon FarmRausay P. Co. Company

NORTH

WEST

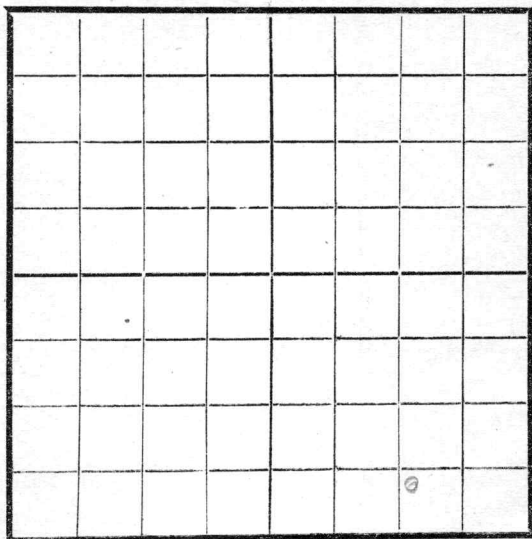

EAST

SOUTH

Location _____

Rig Up _____

Drilling and remarks

1750

RECORD

Cased _____ in. _____ Ft

Sand _____

Gas _____

Oil _____

Total Depth _____

PRODUCTION

1st 24 hrs. Nat. _____

1st 24 hrs. after shot _____

Gas _____ Cu. Ft.

Dry Hole _____

Abandoned _____


Date

4/17, 1918 S. Candy Scout

Map No. _____ Sec. 24 Twp. 26 R. 4Well No. 16 Harmon FarmRamsey Peter Company

NORTH

WEST

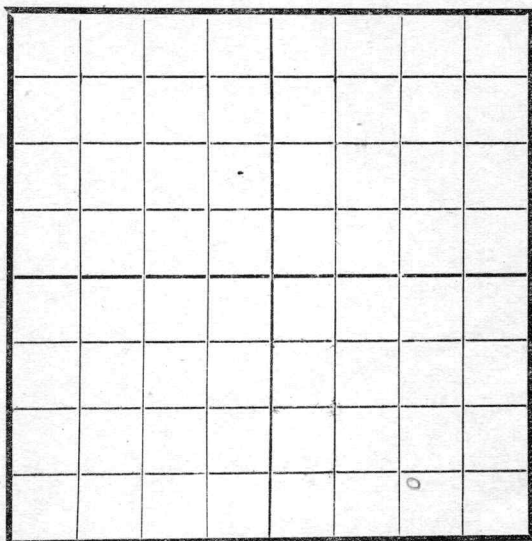

EAST

SOUTH

Location _____

Rig Up _____

Drilling and remarks

RECORD

Cased _____ in. _____ Ft.

Sand _____

Gas _____

Oil _____

Total Depth _____

PRODUCTION

1st 24 hrs. Nat. _____

1st 24 hrs. after shot _____

Gas _____ Cu. Ft.

Dry Hole _____

Abandoned _____

Date

4/24, 1911 S. Condy Scout


Map No. _____ Sec. 24 Twp. 26 R. 4

Well No. 16 Harmon Farm _____

Ramsay Petro Company _____

NORTH

WEST

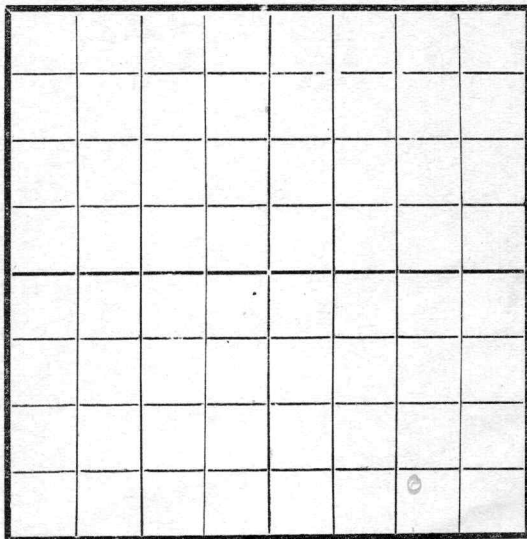

EAST

SOUTH

RECORD

Location _____

Cased _____ in. _____ Ft.

Rig Up _____

Sand _____

Drilling and remarks

Gas _____

Oil _____

Total Depth _____

2200

PRODUCTION

1st 24 hrs. Nat. _____

1st 24 hrs. after shot _____

Gas _____ Cu. Ft.


Dry Hole _____

Abandoned _____

Date

5/1, 1918 Scout

Map No. _____ Sec. 24 Twp. 26 R. 4
Well No. 16 Harmon Farm
Running Retros Company
NORTH

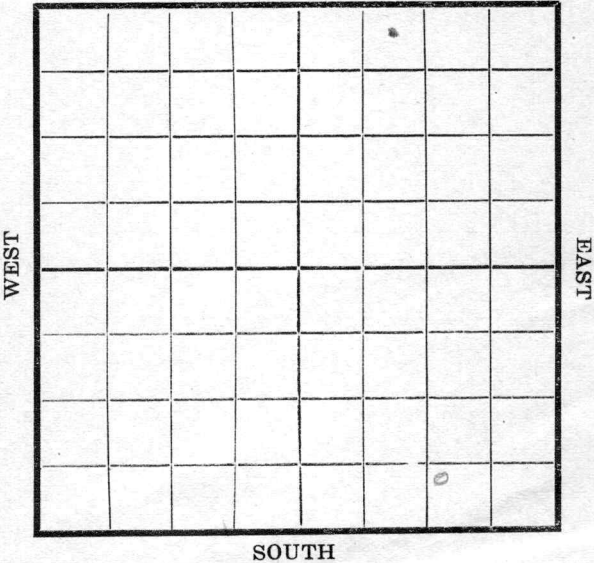

RECORD		
Location _____	Cased _____ in. _____ Ft.	
Rig Up _____	Sand _____	
Drilling and remarks	Gas _____	
<u>2375</u>	Oil _____	
	Total Depth _____	
	PRODUCTION	
	1st 24 hrs. Nat. _____	
	1st 24 hrs. after shot _____	
	Gas _____ Cu. Ft.	
	Dry Hole _____	
	Abandoned _____	


Date 5/8, 1911 S. C. Anderson Scout

Map No. _____ Sec. 24 Twp. 26 R. 4

Well No. 16 Harmon Farm
Roundy Petro Company

NORTH

WEST

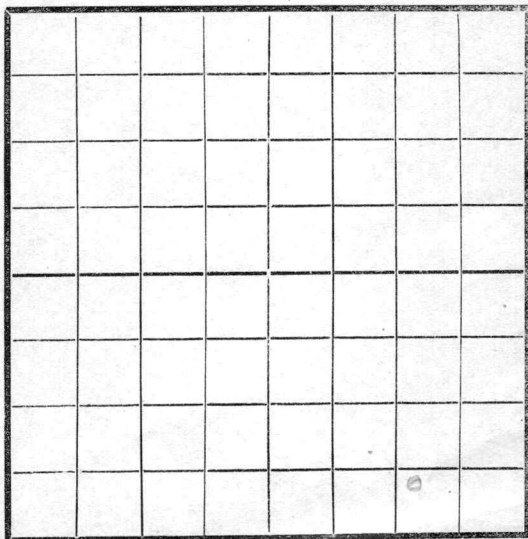

EAST

SOUTH

Location _____

Rig Up _____

Drilling and remarks

Thp sand

2653

RECORD

Cased _____ in. _____ Ft.

Sand _____

Gas _____

Oil _____

Total Depth _____

PRODUCTION

1st 24 hrs. Nat. _____

1st 24 hrs. after shot _____

Gas _____ Cu. Ft.

Dry Hole _____

Abandoned _____

Date

5/15, 1918


Condy

Scout

Map No. K14 Sec. 24 Twp. 26 R. 4Well No. 16 Harmon Farm
Raymond Petro Company

NORTH

WEST

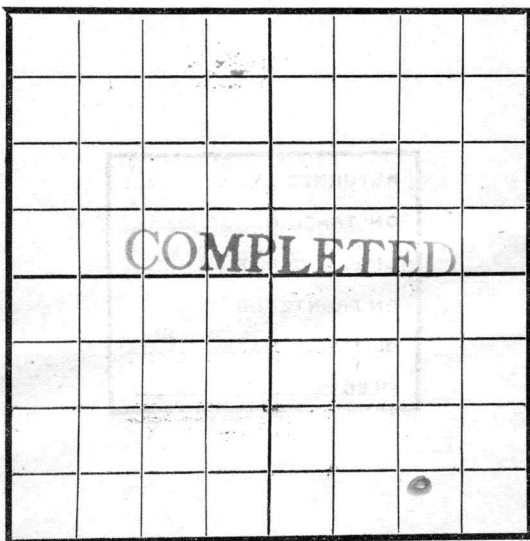

EAST

SOUTH

Location -----

Rig Up -----

Drilling and remarks

Ext at
150
Blue

RECORD

Cased ----- in ----- Ft.

Sand 2658-2673

Gas -----

Oil -----

Total Depth -----

PRODUCTION

1st 24 hrs. Nat. -----

1st 24 hrs. after shot -----

Gas ----- Cu. Ft.

Dry Hole -----

Abandoned -----

Date

5/22, 1918 Candey Scout