


Map No. _____ Sec. 24 Twp. 76 R. 4

Well No. 20 Harrison Farm
Ramsay Oil Co. Company

NORTH

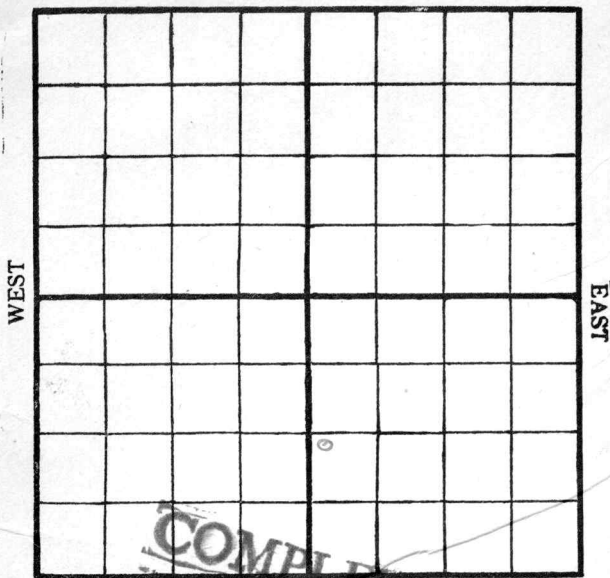

SOUTH

Location _____

Rig Up _____

Drilling Remarks:

Drilling Remarks:

COMPLETE

RECORD

Cased _____ in. _____ ft.

Sand _____

Gas _____

Oil _____

Total Depth _____

PRODUCTION

1st 24 hrs. Nat. _____

1st 24 hrs. after shot _____

Gas _____ cu. ft.

Dry Hole _____

Abandoned _____

Well No. 20-301-11-1

Kausler Company

Contractor

WEST

EAST

SOUTH

Location _____

Rig up _____

Drilling and Remarks:

RECORD

Cased_____in., _____ft.

Sand_____

Gas

Oil_____

Total Depth_____

PRODUCTION

1st 24 hrs. Nat. -----

1st 24 hrs. after shot-----

Gas.....Cu. Ft.

Dry Hole_____

Abandoned.....


Date _____

Date 6/11 191 J. C. Corder Scout

Date 6/11 191 J. C. Corder Scout

Map No. _____ Sec. 24 Twp. 36 R. 4Well No. 20 HarmonPamsey Petroleum CompanyLavis Drilling Co ContractorE. L. Dando NORTH

WEST

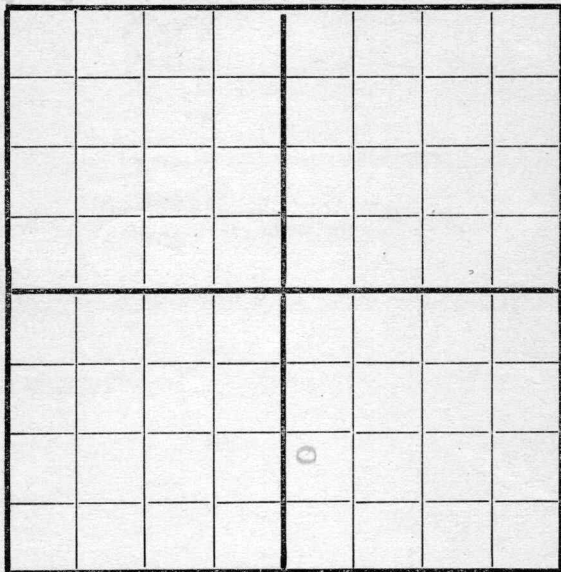

EAST

SOUTH

Location _____

Rig up _____

Drilling and Remarks:

Spudding

RECORD

Cased _____ in., _____ ft.

Sand _____

Gas _____

Oil _____

Total Depth _____

PRODUCTION

1st 24 hrs. Nat. _____

1st 24 hrs. after shot _____

Gas _____ Cu. Ft.

Dry Hole _____


Abandoned _____

Date

6/26 1918 E. L. Dando Scout

Map No. _____ Sec. 34 Twp. 26 R. 4Well No. 20 Ramsey_____
Ramsey Petro Company_____
Contractor

NORTH

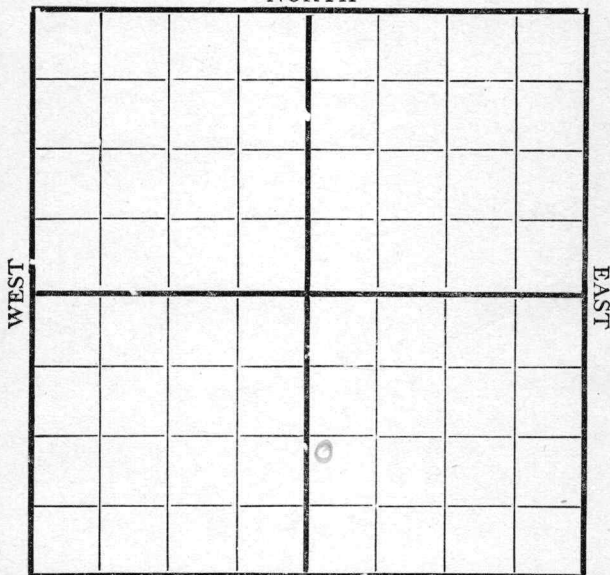

SOUTH

Location _____

Rig up _____

Drilling and Remarks:

RECORD

Cased _____ in., _____ ft.

Sand _____

Gas _____

Oil _____

Total Depth _____

PRODUCTION

1st 24 hrs. Nat. _____


1st 24 hrs. after shot _____

Gas _____ Cu. Ft.

Dry Hole _____

Abandoned _____

Date _____

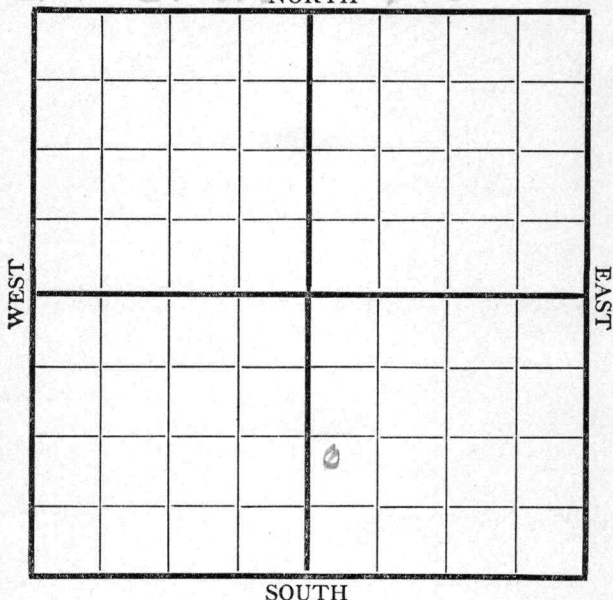Map No. _____ Sec. 24 Twp. 26 R. 4Well No. 20 J HarmonRamsay Petro CompanyDavis Drill Co ContractorC. J. Dwyer NORTH Ko

Location _____

Rig up _____

Drilling and Remarks:

840**RECORD**

Cased _____ in., _____ ft.

Sand _____

Gas _____

Oil _____

Total Depth _____

PRODUCTION

1st 24 hrs. Nat. _____

1st 24 hrs. after shot _____

Gas _____ Cu. Ft.


Dry Hole _____

Abandoned _____

Date

7/3 191 J. Condit Scout

Map No. _____ Sec. 24 Twp. 26 R. 4
 Well No. 20 _____
 _____ Company
 _____ Contractor

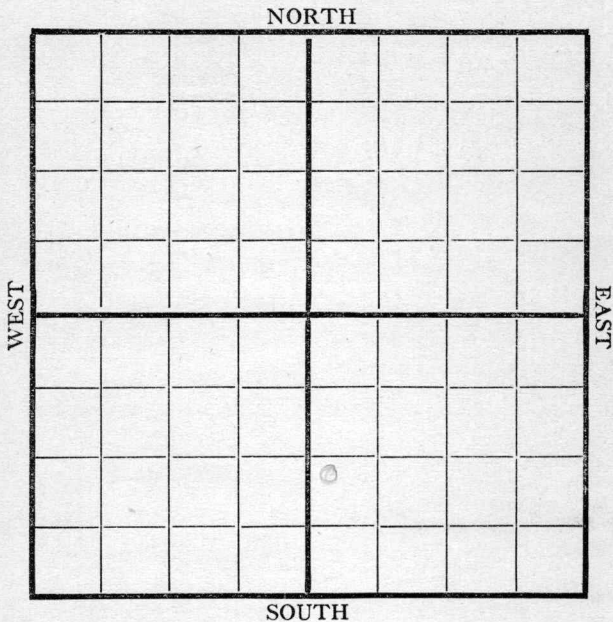


	RECORD
Location _____ Rig up _____ Drilling and Remarks: Fishing 840	Cased _____ in., _____ ft. Sand _____ Gas _____ Oil _____ Total Depth _____ PRODUCTION 1st 24 hrs. Nat. _____ 1st 24 hrs. after shot _____ Gas _____ Cu. Ft. Dry Hole _____ Abandoned _____

Date 7/10 1918 Scout

Map No. _____ Sec. 24 Twp. 26 R. 4Well No. 207 HornumConnie P. Co. Company_____
Contractor

NORTH

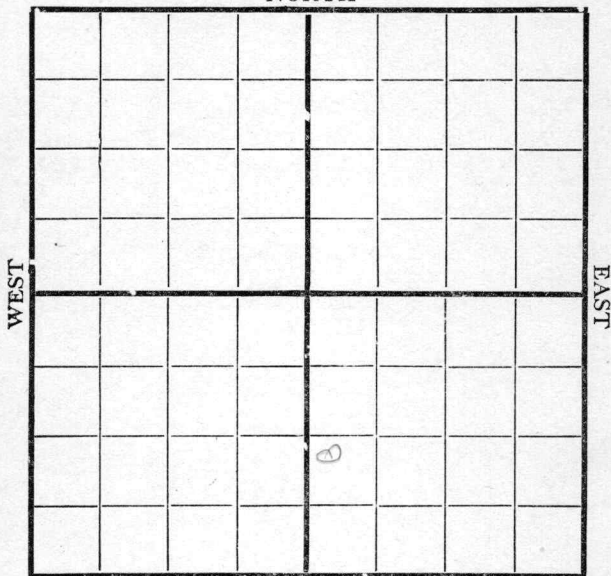

SOUTH

Location _____

Rig up _____

Drilling and Remarks:

*Fishing
skidded rig
spudding -
(old depth 840)*

RECORD

Cased _____ in., _____ ft.

Sand _____

Gas _____

Oil _____

Total Depth _____

PRODUCTION

1st 24 hrs. Nat. _____

1st 24 hrs. after shot _____

Gas _____ Cu. Ft.

Dry Hole _____

Abandoned _____

Date


7/24 191 800 Scout

Map No. _____ Sec. 24 Twp. 26 R. 4
 Well No. 20 Harmon
Ramsey Petro Company
 Contractor _____

NORTH

WEST

EAST

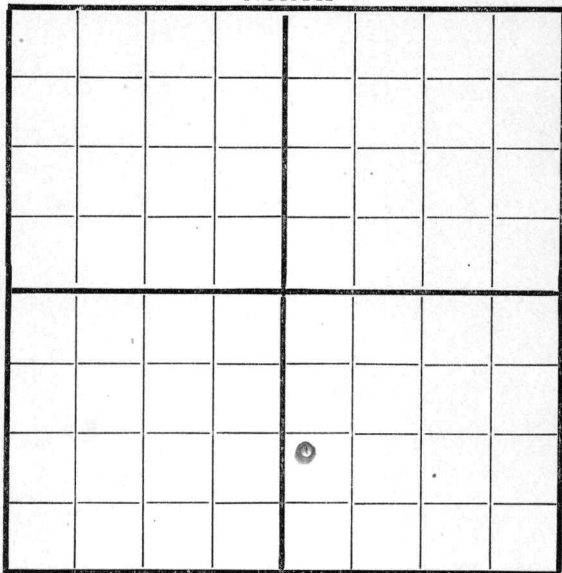

SOUTH

1120 17 S 24 E 200 1/4 L

Location _____

Rig up _____

Drilling and Remarks:

300

RECORD

Cased _____ in., _____ ft.

Sand _____

Gas _____

Oil _____

Total Depth _____

PRODUCTION

1st 24 hrs. Nat. _____

1st 24 hrs. after shot _____

Gas _____ Cu. Ft.

Dry Hole _____

Abandoned _____

Date

7/31 191 8 Candy Scout


Map No. _____ Sec. 24 Twp. 26 R. 4Well No. 20 HarmonRemsey Petro Company

Contractor _____

NORTH

WEST

EAST

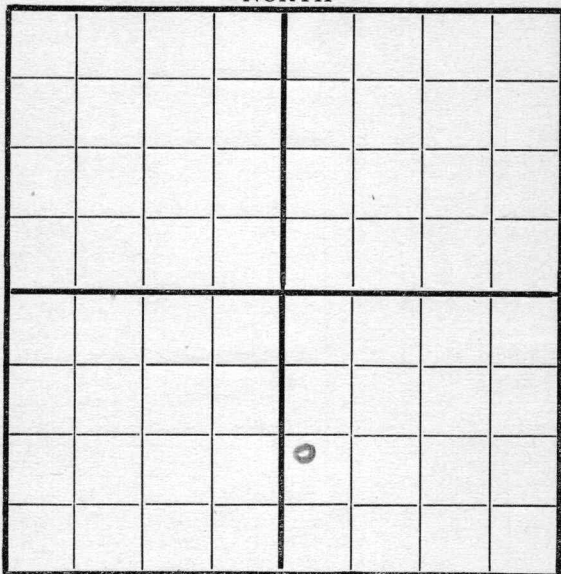

SOUTH

Location 1120 S
200 W

Rig up _____

Drilling and Remarks:

SD
800'

RECORD

Cased _____ in., _____ ft.

Sand _____

Gas _____

Oil _____

Total Depth _____

PRODUCTION

1st 24 hrs. Nat. _____

1st 24 hrs. after shot _____

Gas _____ Cu. Ft.

Dry Hole _____

Abandoned _____

Date

7/2 191 8 Canaday Scout

Map No. _____ Sec. 24 Twp. 26 R. 4

Well No. 20 Harmon


Harmon Bros Company

Contractor _____

NORTH

WEST

EAST

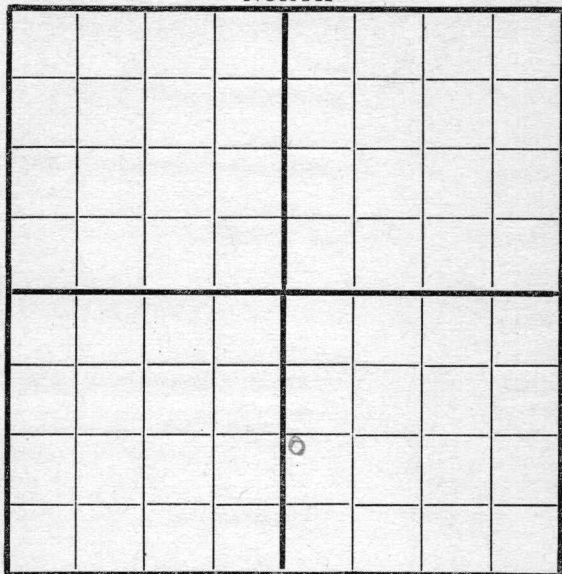

SOUTH

Location 200 N

Rig up _____

Drilling and Remarks:

D. W. for
water @
900'

RECORD

Cased _____ in., _____ ft.

Sand _____

Gas _____

Oil _____

Total Depth _____

PRODUCTION

1st 24 hrs. Nat. _____

1st 24 hrs. after shot _____

Gas _____ Cu. Ft.

Dry Hole _____

Abandoned _____

Date


8/5 1918 Cyle Scout

Map No. _____ Sec. 24 Twp. 26 R. 4Well No. 20 HornumPennsylvania Petroleum Company_____
Contractor

NORTH

WEST

EAST

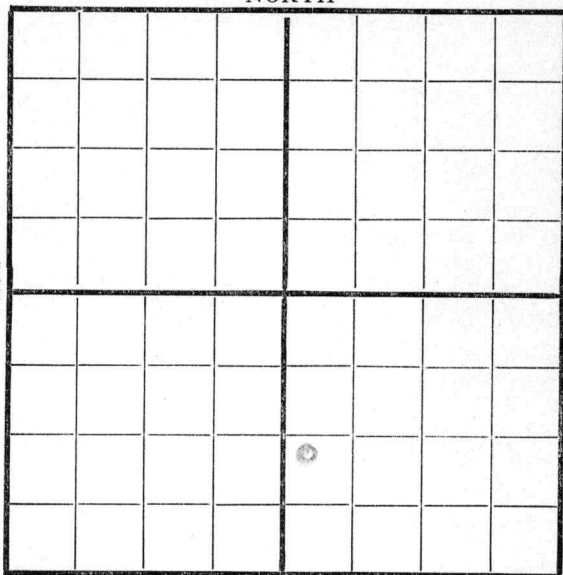

SOUTH

Location _____

Rig up _____

Drilling and Remarks:

1300'

RECORD

Cased _____ in., _____ ft.

Sand _____

Gas _____

Oil _____

Total Depth _____

PRODUCTION

1st 24 hrs. Nat. _____

1st 24 hrs. after shot _____

Gas _____ Cu. Ft.

Dry Hole _____

Abandoned _____

Date

8/23

191

Pyle

Scout


Map No. K14 Sec. 24 Twp. 26 R. 4Well No. 30 HarmonRamsay Pitts Company

Contractor

NORTH

WEST

EAST

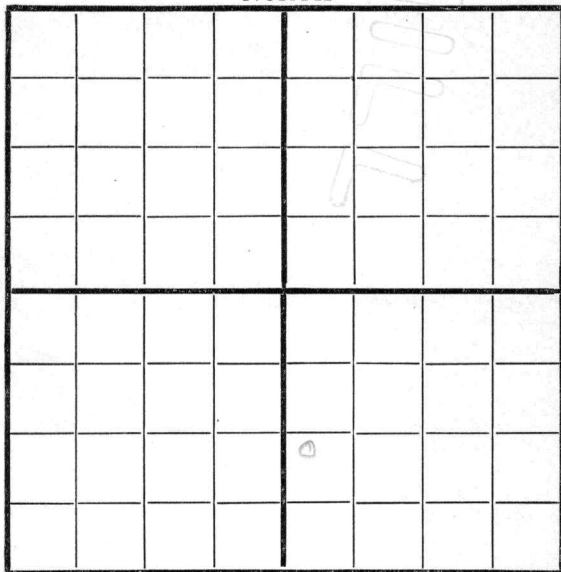

SOUTH

1120 S 200 W

Location _____

Rig up _____

Drilling and Remarks:

1800

RECORD

Cased _____ in., _____ ft.

Sand _____

Gas _____

Oil _____

Total Depth _____

PRODUCTION

1st 24 hrs. Nat. _____

1st 24 hrs. after shot _____

Gas _____ Cu. Ft.

Dry Hole _____

Abandoned _____

Date

8/28 J. C. Cady


Map No. 1514 Sec. 24 Twp. 26 R. 4

Well No. 20 Harmon
Ramsey Petro Company
 Contractor

NORTH

WEST

EAST

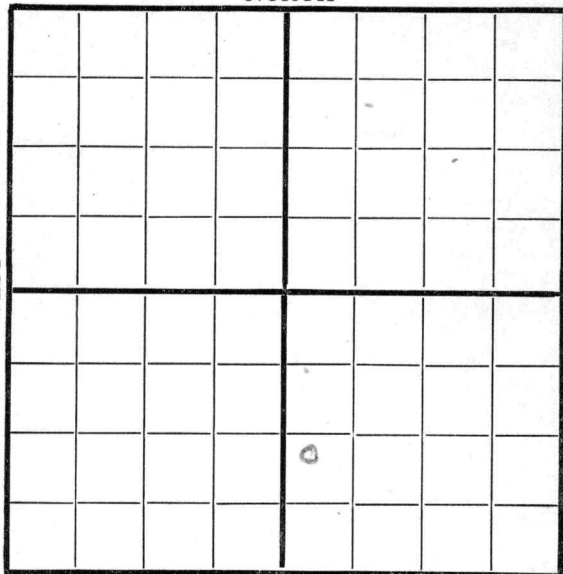

SOUTH

1120 S 200 W

Location _____

Rig up _____

Drilling and Remarks:

2240

RECORD

Cased _____ in., _____ ft.

Sand _____

Gas _____

Oil _____

Total Depth _____

PRODUCTION

1st 24 hrs. Nat. _____

1st 24 hrs. after shot _____

Gas _____ Cu. Ft.

Dry Hole _____

Abandoned _____

Date


9/4 191 S. C. Cady Scout

Map No. 1514 Sec. 24 Twp. 26 R. 4Well No. 20 Harmon
Ramsey Petro Company
Contractor

NORTH

WEST

EAST

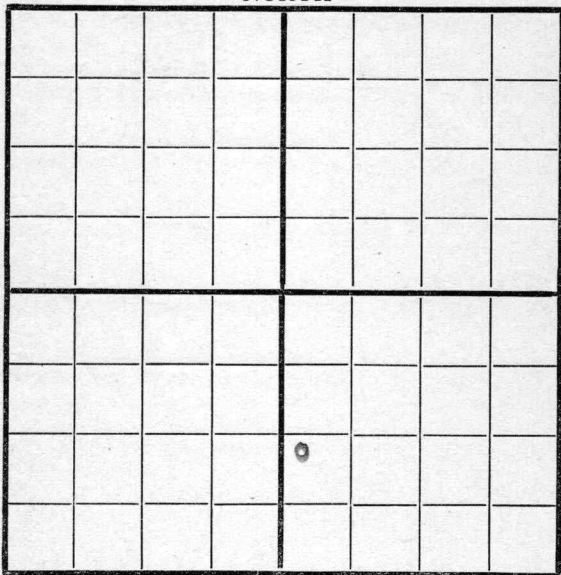

SOUTH

1120 S-200 W-

Location _____

Rig up _____

Drilling and Remarks:

2630

RECORD

Cased _____ in., _____ ft.

Sand _____

Gas _____

Oil _____

Total Depth _____

PRODUCTION

1st 24 hrs. Nat. _____

1st 24 hrs. after shot _____

Gas _____ Cu. Ft.

Dry Hole _____

Abandoned _____

Date

9/11 191 8 C. C. C. Scout


Map No. 1514 Sec. 24 Twp. 26 R. 4

Well No. 20 Thompson
Running Petro Company
Contractor

NORTH

WEST

EAST

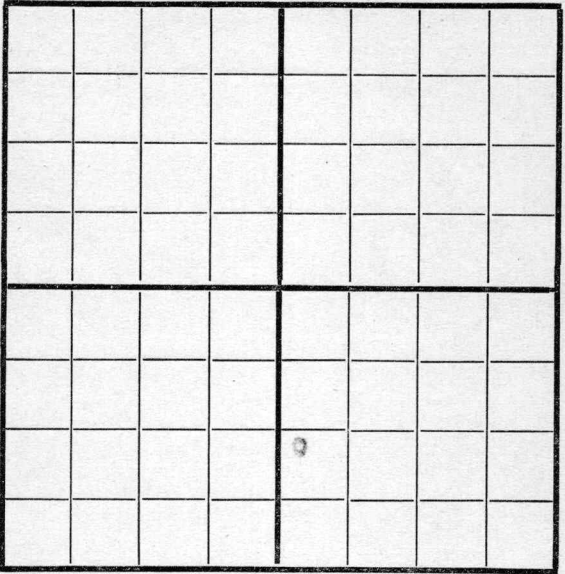

SOUTH

1120 S-200 W-

RECORD

Location

Cased.....in.,ft.

Rig up.....

Sand.....

Drilling and Remarks:

Gas.....

Oil.....

Total Depth.....

PRODUCTION

1st 24 hrs. Nat.

1st 24 hrs. after shot

Gas.....Cu. Ft.

Dry Hole.....

Abandoned.....

Date

9/1/8 191 S. C. Cardiff Scout


Map No. 1514 Sec. 24 Twp. 26 R. 4

Well No. 20 Hammer

Roussy Petro Company

Louis Drilling Co Contractor

Eldorado NORTH 14

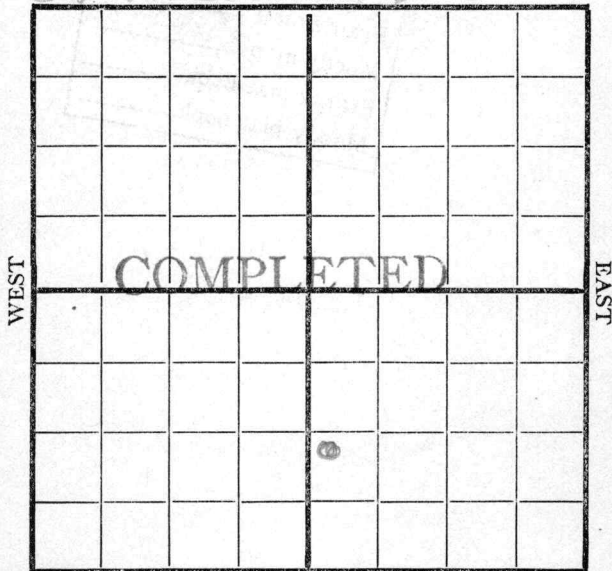

SOUTH

1120 S - 200 W

Location _____

Rig up _____

Drilling and Remarks:

Est at
80 Bbl

RECORD

Cased _____ in., _____ ft.

Sand 2630-2648

Gas _____

Oil _____

Total Depth _____

PRODUCTION

1st 24 hrs. Nat. _____

1st 24 hrs. after shot _____

Gas _____ Cu. Ft.

Dry Hole _____

Abandoned _____

Date

9/25 191 8 Cordry Scout