


Butler

KANSAS

Section 20 Township 26 Range 7-E

Well No. #1 Johnson

Company Rex & Morris

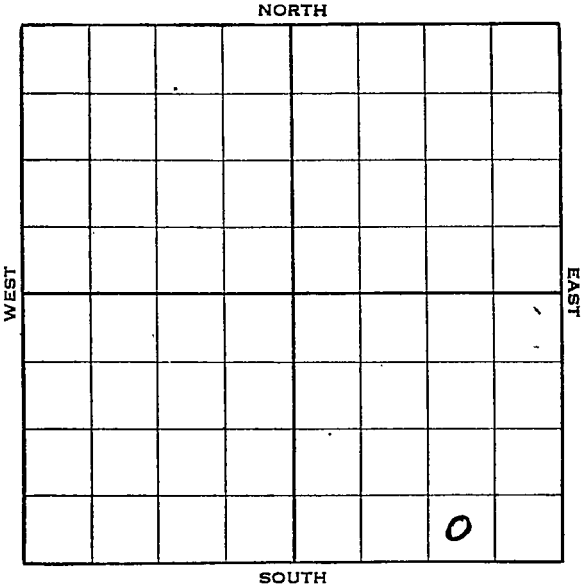


KANSAS

Butler

Sec. 20 Twp. 26 R. 7-EWell No. #1 Johnson FarmRex & Morris Company Ft. from N. Line330 Ft. from S. Line990 Ft. from E. Line Ft. from W. Line

Elev. 1467

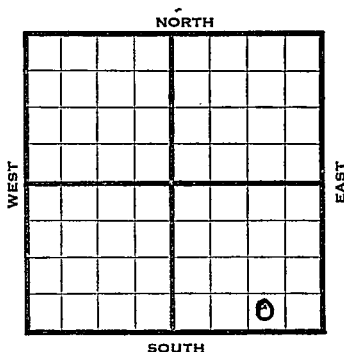

1938

REPORT

3/23

Drlg. 800'.

4/1

12" @ 817'. Drlg. 1540'.

4/8

10" @ 1618'. K.C. 2080'.

T.D. 2201'. S.O.

8" @ 2193'. WOG.

4/15

Pay 2196'. T.D. 2208'.

600' oil 12 hrs.

4/20

8" @ 2193'.

K.C. 2080'.

T.D. 2208'.

2000 acid.

Potential 65 bbls.

COMPLETED


Map No. 15 Sec. 20 Twp. 26 R. 7EWell No. 1 JohnsonRex & Morris Company

Contractor

FIRST REPORT

SW SE SE

SECTION PLAT

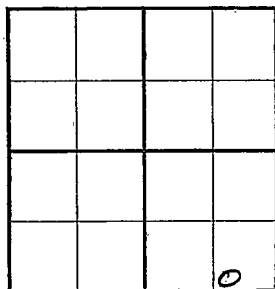 Ft. from N. Line330 Ft. from S. Line990 Ft. from E. Line Ft. from W. LineLocation Rig up

Drilling and Remarks:

DRIG. 800

RECORD

Cased in., ft.Sand Gas Oil Total Depth

PRODUCTION

1st 24 hrs. Nat. 1st 24 hrs. after shot Gas Cu. Ft.Dry Hole Abandoned

Date

H. D. Hatfield

Scout

MAR 23 1938

19

Butler

KANSAS

Map No. 15 Sec. 20 Twp. 26 R. 7EWell No. 1 JohnsonRex & Morris CompanyContractor

COMPLETED

SW SE SE

SECTION PLAT

			0

 Ft. from N. Line330 Ft. from S. Line990 Ft. from E. Line Ft. from W. LineLocation Rig up

Drilling and Remarks:

*2000 acid**POT 65*

RECORD

Cased 8 in., 2193 ft.Sand KC. 2080Gas Oil Total Depth 2208

PRODUCTION

1st 24 hrs. Nat. 1st 24 hrs. after shot Gas Cu. Ft.Dry Hole Abandoned

Date

APR 20 1938

19

G. D. Hatfield Scout