

Map No. _____ Sec. 11 Twp. 26 E. 4Well No. 19 Cardy _____ Farm __________
Company

NORTH

WEST



EAST

SOUTH

Location _____

Rig Up _____

Drilling Remarks:

Drilling Remarks:

RECORD

Cased _____ in. _____ ft.

Sand _____

Gas _____

Oil _____

Total Depth _____

PRODUCTION

1st 24 hrs. Nat. _____

1st 24 h.s. after shot _____

Gas _____ cu. ft


Dry Hole _____

Abandoned _____

Map No. K14 Sec. 11 Twp. 26 R. 4
 Well No. 19 Carley Farm
Empire Gas & Fuel Company

NORTH

WEST

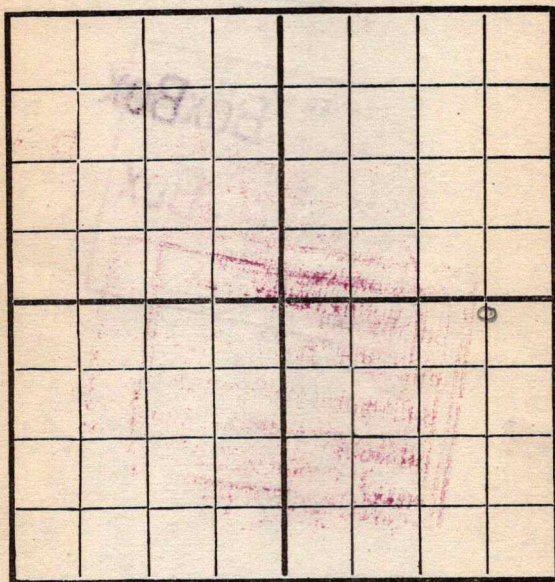

EAST

SOUTH

Location -----

Rig Up ☒ -----

Drilling and remarks

RECORD

Cased ----- in. ----- Ft.

Sand -----

Gas -----

Oil -----

Total Depth -----

PRODUCTION

1st 24 hrs. Nat. -----

1st 24 hrs. after shot -----

Gas ----- Cu. Ft.

Dry Hole -----

Abandoned -----

Date


1/2, 1918, Carley Scout

First Report

Map No. _____ Sec. 11 Twp. 26 R. 4Well No. 19 Cordy Farm _____Cummins Company _____

NORTH

WEST

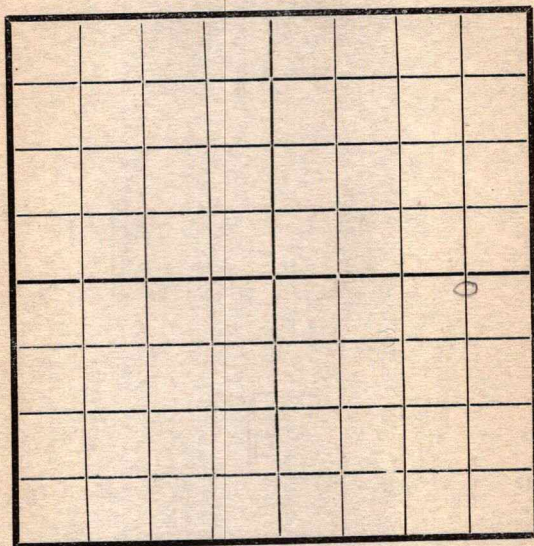

EAST

SOUTH

Location _____

Rig Up _____

Drilling and remarks

RECORD

Cased _____ in. _____ Ft.

Sand _____

Gas _____

Oil _____

Total Depth _____

PRODUCTION

1st 24 hrs. Nat. _____

1st 24 hrs. after shot _____

Gas _____ Cu. Ft.

Dry Hole _____

Abandoned _____

Date


3/6, 1918 Cordy Scout _____

Map No. _____ Sec. 11 Twp. 26 R. 4

Well No. 19 _____ Farm _____
Empire _____ Company _____

NORTH

WEST

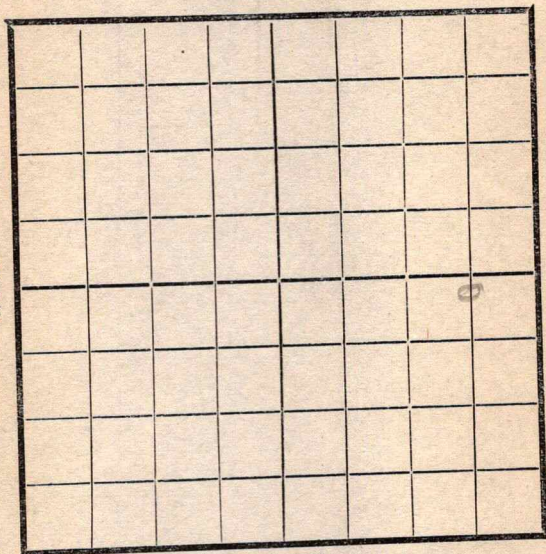

EAST

SOUTH

RECORD

Location _____

Rig Up _____

Drilling and remarks

SD 700

Cased _____ in. _____ Ft.

Sand _____

Gas _____

Oil _____

Total Depth _____

PRODUCTION

1st 24 hrs. Nat. _____

1st 24 hrs. after shot _____

Gas _____ Cu. Ft.

Dry Hole _____


Abandoned _____

Date

3/13, 1911 S. Cardy Scout

Map No. _____ Sec. 11 Twp. 26 R. 4
Well No. 19 Candy
Enterprise Company

NORTH

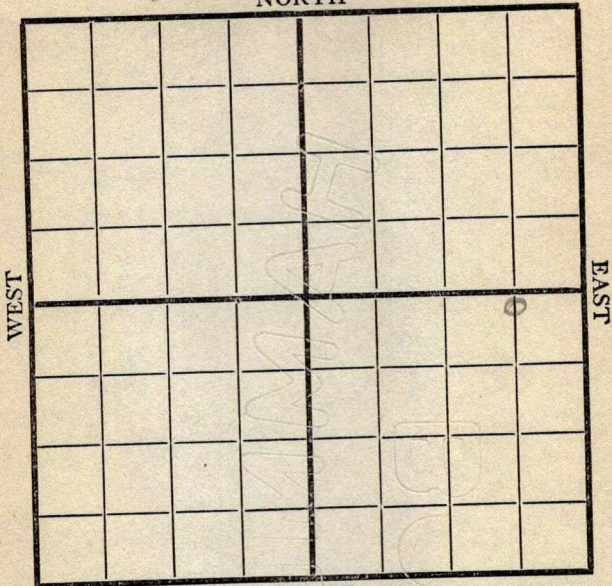

SOUTH

Location _____

Rig up _____

Drilling and Remarks:

1700

RECORD

Cased _____ in., _____ ft.

Sand _____

Gas _____

Oil _____

Total Depth _____

PRODUCTION

1st 24 hrs. Nat. _____

1st 24 hrs. after shot _____

Gas _____ Cu. Ft.

Dry Hole _____

Abandoned _____

Date

APR 3 1918

191

Candy Scout

Map No. _____ Sec. 11 Twp. 26 R. 4Well No. 19 Candy Farm _____
Engine Company _____

NORTH

WEST

EAST

SOUTH

Location _____

Rig Up _____

Drilling and remarks

1950

RECORD

Cased _____ in. _____ Ft.

Sand _____

Gas _____

Oil _____

Total Depth _____

PRODUCTION

1st 24 hrs. Nat. _____

1st 24 hrs. after shot _____

Gas _____ Cu. Ft.

Dry Hole _____

Abandoned _____

Date

4/10, 1918 S. Candy Scout

Map No. _____ Sec. 11 Twp. 26 R. 4Well No. 19 Candy Farm _____Candy Company _____

NORTH

WEST

EAST

SOUTH

Location _____

Rig Up _____

Drilling and remarks

RECORD

Cased _____ in. _____ Ft.

Sand _____

Gas _____

Oil _____

Total Depth _____

PRODUCTION

1st 24 hrs. Nat. _____

1st 24 hrs. after shot _____

Gas _____ Cu. Ft.

Dry Hole _____

Abandoned _____

Date

3/27, 1911 Candy Scout

Map No. _____ Sec. 11 Twp. 26 R. 4Well No. 19 Candy Farm _____

Company _____

NORTH

WEST

EAST

SOUTH

Location _____

Rig Up _____

Drilling and remarks

RECORD

Cased _____ in. _____ Ft.

Sand _____

Gas _____

Oil _____

Total Depth _____

PRODUCTION

1st 24 hrs. Nat. _____

1st 24 hrs. after shot _____

Gas _____ Cu. Ft.

Dry Hole _____

Abandoned _____


Date

4/12, 1911 S. Candy Scout

Map No. _____ Sec. 11 Twp. 26 R. 4
 Well No. 19 Candy Farm _____
Empire Company _____

NORTH

WEST

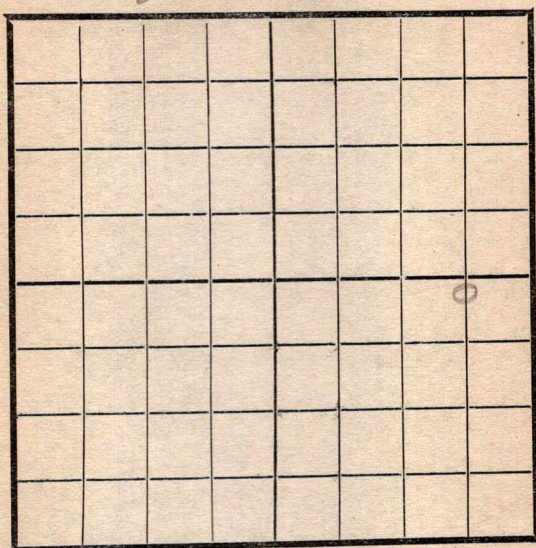

EAST

SOUTH

Location _____
 Rig Up _____
 Drilling and remarks

2180

RECORD

Cased _____ in. _____ Ft.
 Sand _____
 Gas _____
 Oil _____
 Total Depth _____

PRODUCTION

1st 24 hrs. Nat. _____
 1st 24 hrs. after shot _____
 Gas _____ Cu. Ft.
 Dry Hole _____
 Abandoned _____


Date

4/24, 1918 Candy Scout

Map No. _____ Sec. 11 Twp. 26 R. 4Well No. 19 Candy Farm _____
Engine Company _____

NORTH

WEST

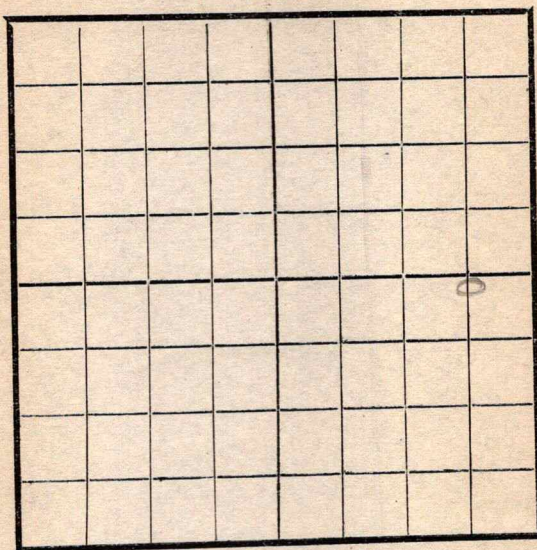

EAST

SOUTH

Location _____

Rig Up _____

Drilling and remarks

2300

RECORD

Cased _____ in. _____ Ft.

Sand _____

Gas _____

Oil _____

Total Depth _____

PRODUCTION

1st 24 hrs. Nat. _____

1st 24 hrs. after shot _____

Gas _____ Cu. Ft.

Dry Hole _____

Abandoned _____

Date


5/1, 1918 Candy Scout _____

Map No. 114 Sec. 11 Twp. 26 R. 4
Well No. 19 Candy Farm
Engineer Company

NORTH

WEST

EAST

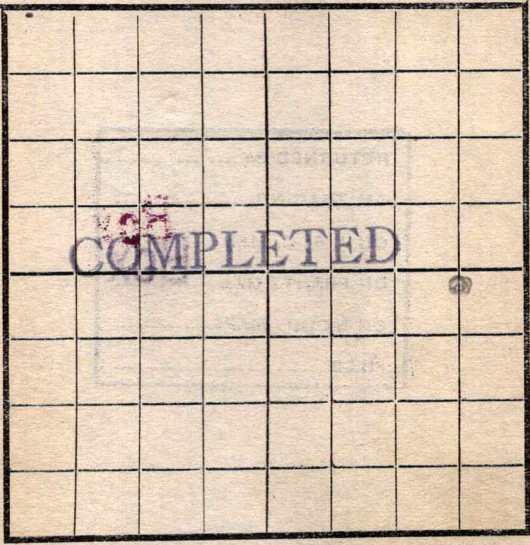

SOUTH

Location -----

Rig Up -----

Drilling and remarks

Est at
400 Bbl

RECORD

Cased _____ in. _____ Ft
Sand 2362-2402
Gas -----
Oil -----
Total Depth -----

PRODUCTION

1st 24 hrs. Nat. -----
1st 24 hrs. after shot -----
Gas ----- Cu. Ft.
Dry Hole -----
Abandoned -----

Date 5/8, 1918 Candy Scout