


Map No. _____ Sec. 24 Twp. 26 R. 4

Well No. 21 Harmon Farm

Ramsay Ref. Company

NORTH

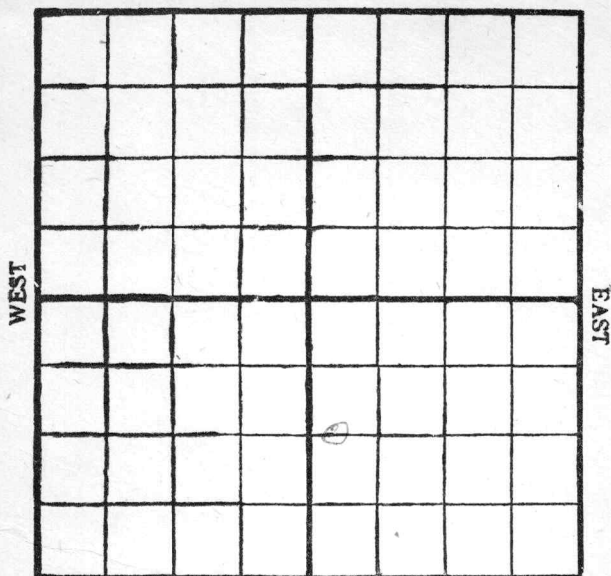

SOUTH

Location -----

Drilling Remarks:

Rig Up -----

Drilling Remarks:

RECORD

Cased----- in.----- ft.

Sand -----

Gas -----

Oil_____

Total Depth -----

PRODUCTION

1st 24 hrs. Nat.-----

1st 24 hrs. after shot-----

Gas ----- cu. ft.

Dry Hole -----

Abandoned -----

Map No. 1514 Sec. 24 Twp. 26 R. 4Well No. 21 KarmanPansey Peter Company

Contractor

NORTH

WEST

EAST

SOUTH

Location _____

Rig up ☒

Drilling and Remarks:

FIRST REPORT**RECORD**

Cased _____ in., _____ ft.

Sand _____

Gas _____

Oil _____

Total Depth _____

PRODUCTION

1st 24 hrs. Nat. _____

1st 24 hrs. after shot _____

Gas _____ Cu. Ft.


Dry Hole _____

Abandoned _____

Date

10/24 191 J. C. Canby Scout

Map No. K14 Sec. 24 Twp. 26 R. 4
 Well No. 21 Harmon
Rumsey Petroleum Company
 Contractor

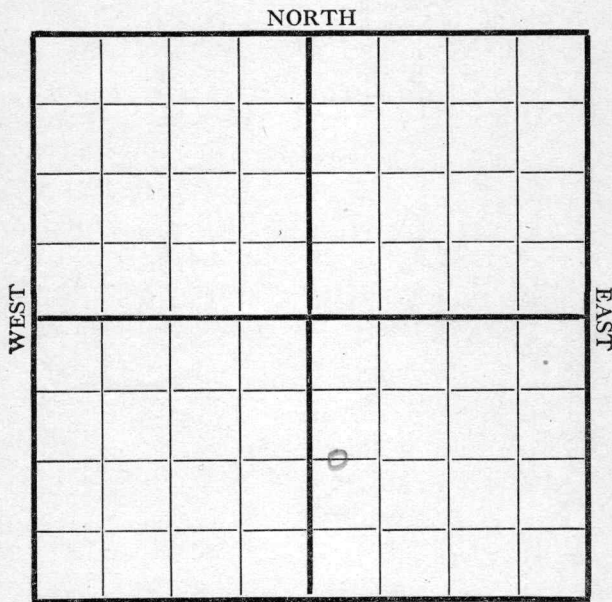

1520 S-200 W

Location _____
 Rig up ☒
 Drilling and Remarks:

RECORD

Cased _____ in., _____ ft.
 Sand _____
 Gas _____
 Oil _____
 Total Depth _____

PRODUCTION

1st 24 hrs. Nat. _____
 1st 24 hrs. after shot _____
 Gas _____ Cu. Ft.
 Dry Hole _____
 Abandoned _____

Date 10/30 191 8 Landry Scout


Map No. K14 Sec. 24 Twp. 26 R. 4Well No. 21 HarmonRunway Pette Company

Contractor

NORTH

WEST

EAST

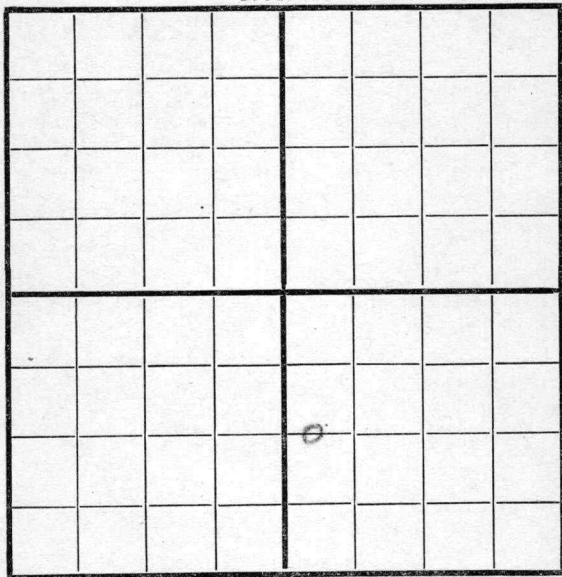

SOUTH

1320 S-200 W

Location _____

Rig up ☒

Drilling and Remarks:

RECORD

Cased _____ in., _____ ft.

Sand _____

Gas _____

Oil _____

Total Depth _____

PRODUCTION

1st 24 hrs. Nat. _____

1st 24 hrs. after shot _____

Gas _____ Cu. Ft.

Dry Hole _____

Abandoned _____

Date

11/6191S. C. Caudill

Scout

Map No. 1514 Sec. 24 Twp. 26 R. 4Well No. 21 HarmonRamsay Petro Company

Contractor

NORTH

WEST

EAST

SOUTH

Location 1320 N 200 WRig up ☒

Drilling and Remarks:

RECORD

Cased _____ in., _____ ft.

Sand _____

Gas _____

Oil _____

Total Depth _____

PRODUCTION

1st 24 hrs. Nat. _____

1st 24 hrs. after shot _____

Gas _____ Cu. Ft.

Dry Hole _____

Abandoned _____

Date


11/13 191 8 Cady Scout

Map No. K14 Sec. 24 Twp. 26 R. 4Well No. 21 Hamm
Kearney Peto Company
Contractor

NORTH

WEST

EAST

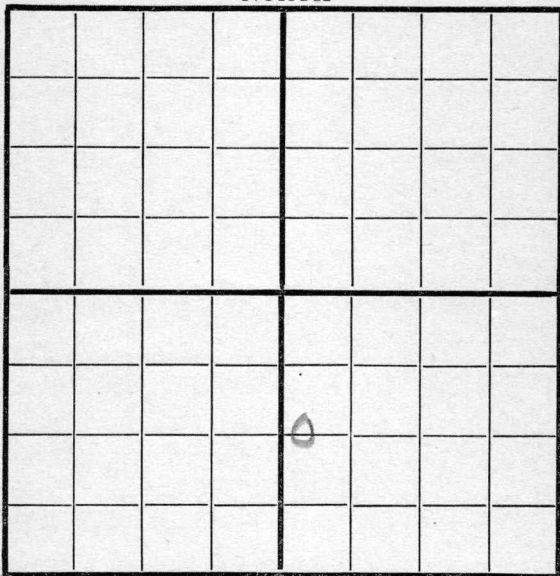

SOUTH

Location _____

Rig up ☒ _____

Drilling and Remarks:

RECORD

Cased _____ in., _____ ft.

Sand _____

Gas _____

Oil _____

Total Depth _____

PRODUCTION

1st 24 hrs. Nat. _____

1st 24 hrs. after shot _____

Gas _____ Cu. Ft.

Dry Hole _____

Abandoned _____

Date


11/20 191 Scout

Map No. 114 Sec. 24 Twp. 36 R. 4Well No. 21 Harmon
Ramsay Peter Company
Contractor

NORTH

WEST

EAST

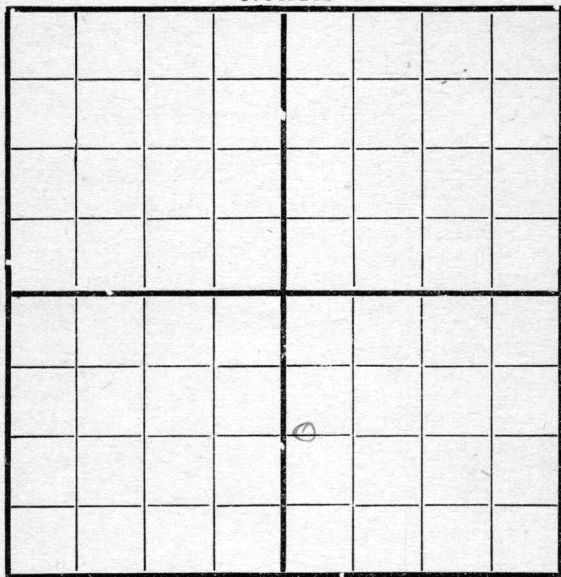

SOUTH

1320 S-200 W

Location _____

Rig up ☒ _____

Drilling and Remarks:

RECORD

Cased _____ in., _____ ft.

Sand _____

Gas _____

Oil _____

Total Depth _____

PRODUCTION

1st 24 hrs. Nat. _____

1st 24 hrs. after shot _____

Gas _____ Cu. Ft.

Dry Hole _____

Abandoned _____

Date

11/27 191 S. Caird Scout

Map No. K14 Sec. 24 Twp. 26 R. 4
 Well No. 21 Harmon
Runaway Petr Company
 Contractor

NORTH

WEST

EAST

SOUTH

Location _____

Rig up ✓ _____

Drilling and Remarks:

RECORD

Cased _____ in., _____ ft.

Sand _____

Gas _____

Oil _____

Total Depth _____

PRODUCTION

1st 24 hrs. Nat. _____

1st 24 hrs. after shot _____

Gas _____ Cu. Ft.

Dry Hole _____

Abandoned _____

Date

12/4

191

Scout

Map No. 114 Sec. 24 Twp. 26 R. 4Well No. 21 HarmonRamsey Petros CompanyFrost Drilling Co ContractorEl Dorado NORTH Kan

WEST

EAST

SOUTH

Location _____

Rig up _____

Drilling and Remarks:

Fishing
525

RECORD

Cased _____ in., _____ ft.

Sand _____

Gas _____

Oil _____

Total Depth _____

PRODUCTION

1st 24 hrs. Nat. _____

1st 24 hrs. after shot _____

Gas _____ Cu. Ft.

Dry Hole _____

Abandoned _____

Date

12/11 1918 Candy Scout


Map No. K14 Sec. 24 Twp. 26 R. 4Well No. 21 HarmonRamsey Peter Company

Contractor

NORTH

WEST

EAST

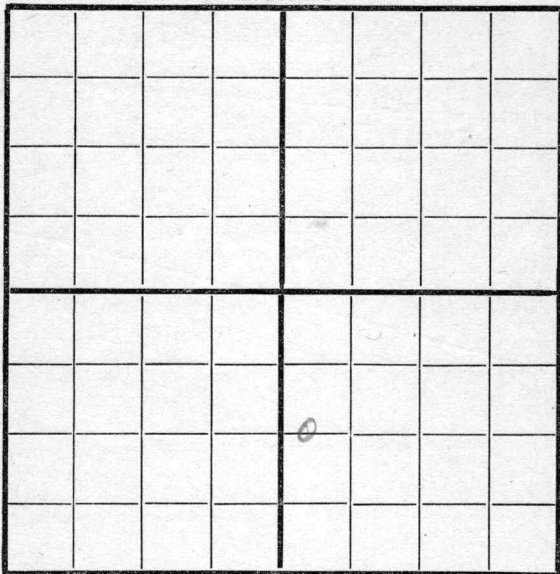

SOUTH

13302-200 W

Location _____

Rig up _____

Drilling and Remarks:

950

RECORD

Cased _____ in., _____ ft.

Sand _____

Gas _____

Oil _____

Total Depth _____

PRODUCTION

1st 24 hrs. Nat. _____

1st 24 hrs. after shot _____

Gas _____ Cu. Ft.

Dry Hole _____

Abandoned _____

Date

12/18 1918 Conroy Scout

Map No. K14 Sec. 24 Twp. 26 R. 4Well No. 21 HarmonRainsey Petr. Company

Contractor

NORTH

WEST

EAST

SOUTH

RECORD

Location _____

Cased _____ in., _____ ft.

Rig up _____

Sand _____

Drilling and Remarks:

Gas _____

Oil _____

Total Depth _____

PRODUCTION

1st 24 hrs. Nat. _____

1st 24 hrs. after shot _____

Gas _____ Cu. Ft.

Dry Hole _____

Abandoned _____

Date

191

Scout

Map No. 114 Sec. 24 Twp. 26 R. 4Well No. 21 HarmonCumsey Petro Company

Contractor

NORTH

WEST

EAST

SOUTH

RECORD

Location _____

Cased _____ in., _____ ft.

Rig up _____

Sand _____

Drilling and Remarks:

Gas _____

Oil _____

Total Depth _____

PRODUCTION

1st 24 hrs. Nat. _____

1st 24 hrs. after shot _____

Gas _____ Cu. Ft.

Dry Hole _____


Abandoned _____

Date

Map No. 1514 Sec. 24 Twp. 26 R. 4

Well No. 21 Harmon
Ramsey & Co. Company
 Contractor

NORTH

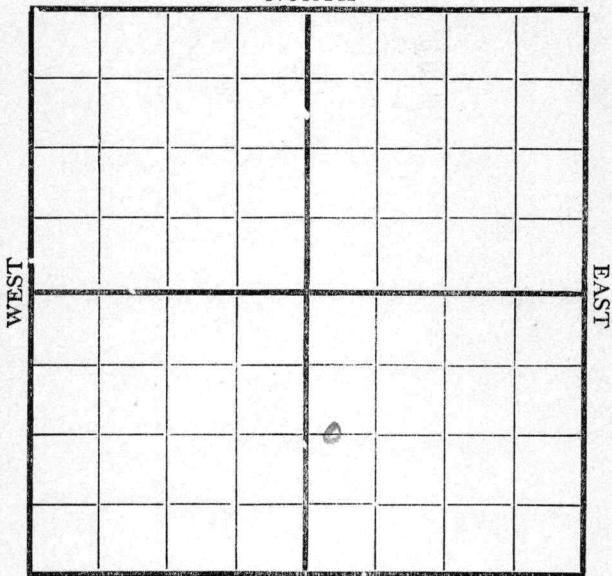

13 208 200 SOUTH W

Location _____

Rig up _____

Drilling and Remarks:

1500

RECORD

Cased _____ in., _____ ft.

Sand _____

Gas _____

Oil _____

Total Depth _____

PRODUCTION

1st 24 hrs. Nat. _____

1st 24 hrs. after shot _____

Gas _____ Cu. Ft.

Dry Hole _____

Abandoned _____

Date


1/8 191 P. Ramsey Scout

Map No. K14 Sec. 24 Twp. 26 R. 4
Well No. 21 Richards
Ramsay Peter Company
Contractor

NORTH

WEST

EAST

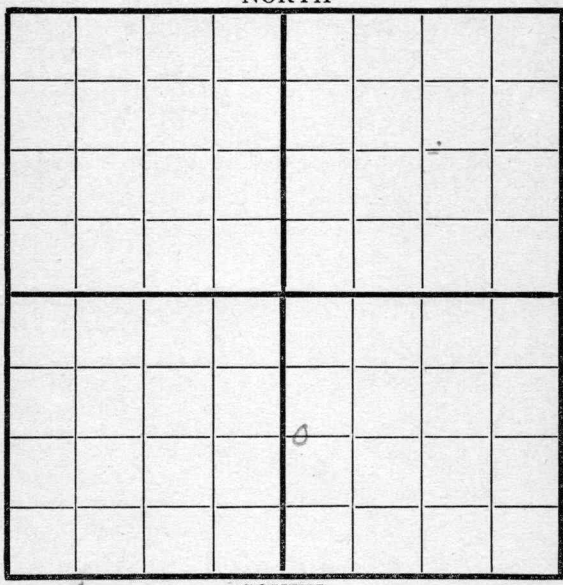

SOUTH

1520 ft 200 W

Location _____

Rig up _____

Drilling and Remarks:

1750

RECORD

Cased _____ in., _____ ft.

Sand _____

Gas _____

Oil _____

Total Depth _____

PRODUCTION

1st 24 hrs. Nat. _____

1st 24 hrs. after shot _____

Gas _____ Cu. Ft.

Dry Hole _____

Abandoned _____

Date

1/15 191 9 Conley Scout


Map No. K14 Sec. 24 Twp. 26 R. 4^S_EWell No. 21 HarmonRamsey Oil Company

Contractor

NORTH

WEST

EAST

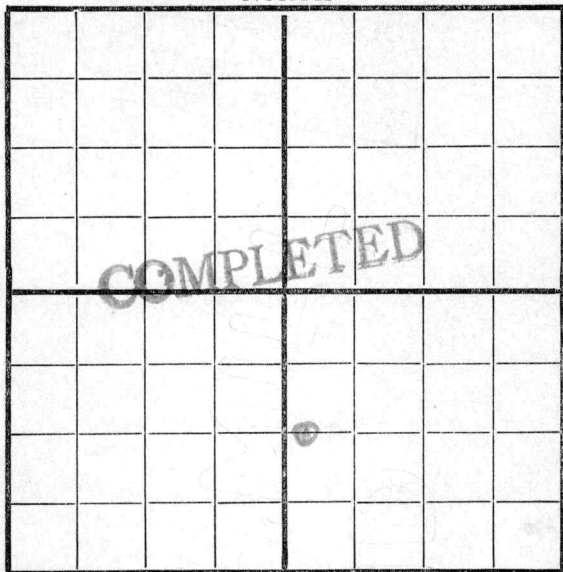

SOUTH

200 W1320 S

Location _____

Rig up _____

Drilling and Remarks:

RECORD

Cased _____ in., _____ ft.

Sand 2625 - 2648

Gas _____

Oil _____

Total Depth _____

PRODUCTION

1st 24 hrs. Nat. _____

1st 24 hrs. after shot 15 bbls

Gas _____ Cu. Ft.

Dry Hole _____

Abandoned _____

Date

3/241919

Pyle

Scout