

Map No. 1514 Sec. 24 Twp. 26 R. 4Well No. 22Ramsey Petro Company

Contractor

NORTH

WEST

EAST

SOUTH

Location _____

Rig up ☒ _____

Drilling and Remarks:

RECORD

Cased _____ in., _____ ft.

Sand _____

Gas _____

Oil _____

Total Depth _____

PRODUCTION

1st 24 hrs. Nat. _____

1st 24 hrs. after shot _____

Gas _____ Cu. Ft.

Dry Hole _____

Abandoned _____

FIRST REPORT

Date


4/26 191 P. Condit Scout

Map No. _____ Sec. 24 Twp. 26 R. 4Well No. 23 HarmonRamsey Petro Company_____
Contractor

NORTH

WEST

EAST

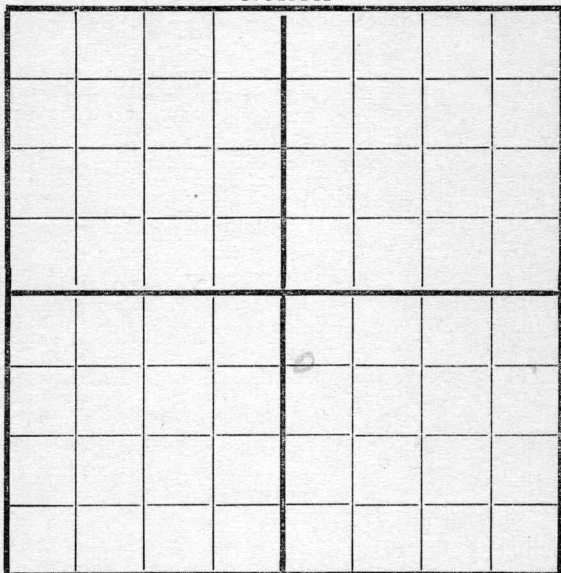

SOUTH

Location _____

Rig up _____

Drilling and Remarks:

RECORD

Cased _____ in., _____ ft.

Sand _____

Gas _____

Oil _____

Total Depth _____

PRODUCTION

1st 24 hrs. Nat. _____

1st 24 hrs. after shot _____

Gas _____ Cu. Ft.


Dry Hole _____

Abandoned _____

Date

6/26 1918 C. Condy Scout

Map No. _____ Sec. 24 Twp. 26 R. 4
Well No. 22 Harmon
Roussy, Pelu Company
Contractor

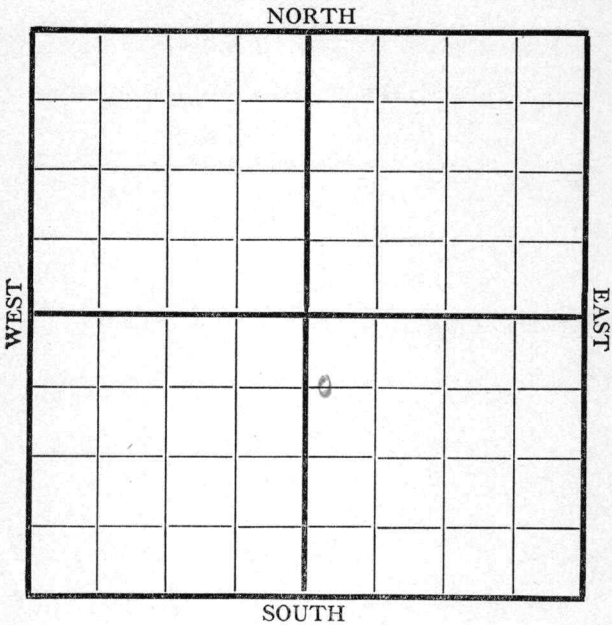


Location _____ Rig up _____ Drilling and Remarks:	RECORD
	Cased _____ in., _____ ft.
	Sand _____
	Gas _____
	Oil _____
	Total Depth _____
	PRODUCTION
	1st 24 hrs. Nat. _____
	1st 24 hrs. after shot _____
	Gas _____ Cu. Ft.
	Dry Hole _____
	Abandoned _____

Date 7/3 191 8 Aug Scout

Map No. _____ Sec. 24 Twp. 26 R. 4
Well No. 22 Johnson
Ramsey Petroleum Company

Contractor

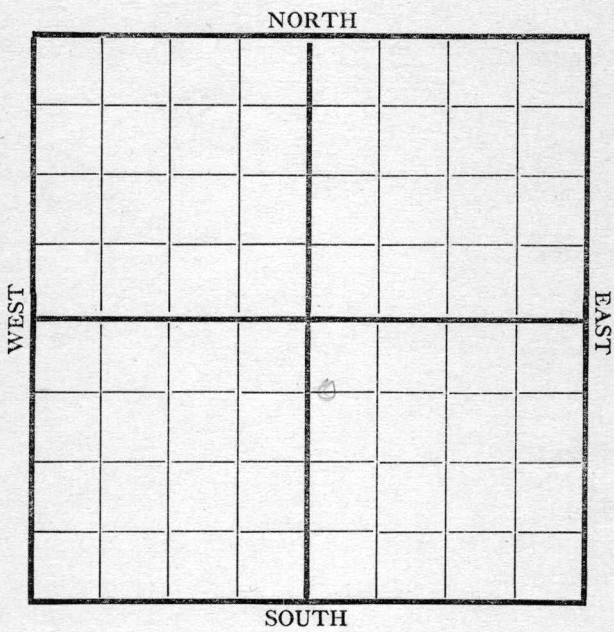


	RECORD
Location _____	Cased _____ in., _____ ft.
Rig up _____	Sand _____
Drilling and Remarks:	Gas _____
	Oil _____
	Total Depth _____
	PRODUCTION
	1st 24 hrs. Nat. _____
	1st 24 hrs. after shot _____
	Gas _____ Cu. Ft.
	Dry Hole _____
	Abandoned _____

Date 7/10 1918 J. C. Cady Scout

Map No. _____ Sec. 24 Twp. 26 R. 4Well No. 22_____
Parmer P. Co. Company_____
Contractor

NORTH

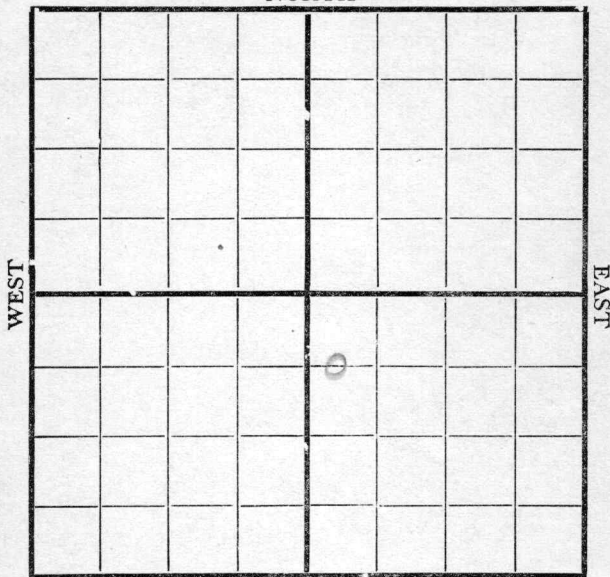

SOUTH

Location _____

Rig up. ☒ _____

Drilling and Remarks:

RECORD

Cased _____ in., _____ ft.

Sand _____

Gas _____

Oil _____

Total Depth _____

PRODUCTION

1st 24 hrs. Nat. _____

1st 24 hrs. after shot _____

Gas _____ Cu. Ft.

Dry Hole _____

Abandoned _____

Date

2/17 1918 Scout

Map No. _____ Sec. 24 Twp. 26 R. 4Well No. 22Company Thompson P. Co.Contractor First Drilling Co.

NORTH

WEST

EAST

SOUTH

Location _____

Rig up _____

Drilling and Remarks:

570

RECORD

Cased _____ in., _____ ft.

Sand _____

Gas _____

Oil _____

Total Depth _____

PRODUCTION

1st 24 hrs. Nat. _____

1st 24 hrs. after shot _____

Gas _____ Cu. Ft.

Dry Hole _____

Abandoned _____

Date

7/24 191 8 Cordery Scout


Map No. _____ Sec. 24 Twp. 26 R. 4Well No. 22 HarmonRamsey Bldg Company

Contractor

NORTH

WEST

EAST

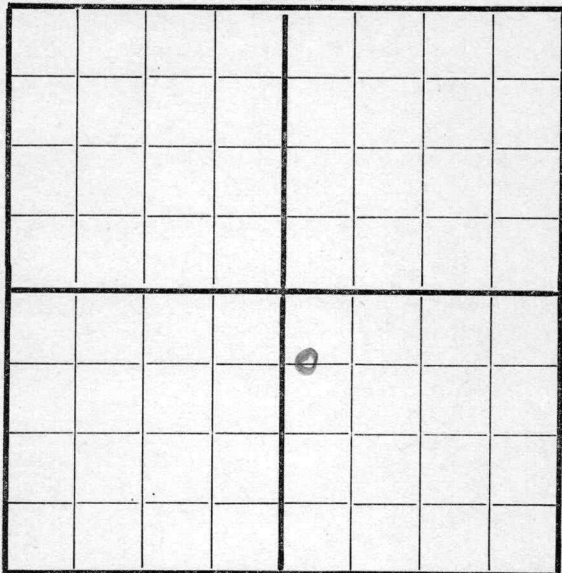

SOUTH

660 ~~574~~ 2 x 200 ~~574~~ 102

Location _____

Rig up _____

Drilling and Remarks:

Fishing 850

RECORD

Cased _____ in., _____ ft.

Sand _____

Gas _____

Oil _____

Total Depth _____

PRODUCTION

1st 24 hrs. Nat. _____

1st 24 hrs. after shot _____

Gas _____ Cu. Ft.

Dry Hole _____

Abandoned _____

Date

7/31 191 8 Cordry Scout


Map No. _____ Sec. 24 Twp. 26 R. 4Well No. 22 HarmonRamsey Peltier Company

Contractor

NORTH

WEST

EAST

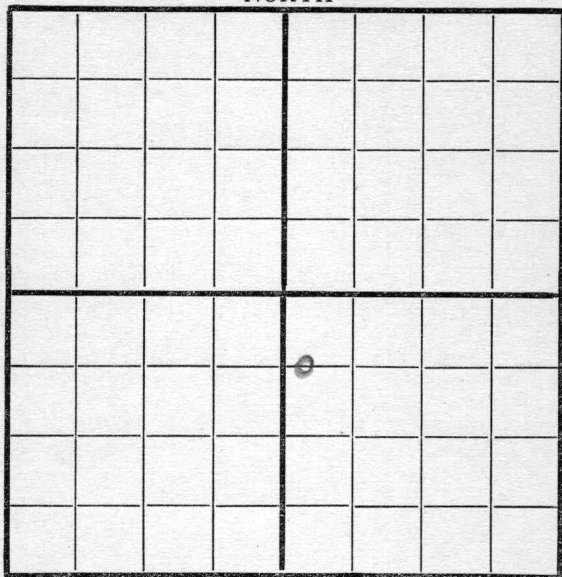

SOUTH

660 NLocation 200 W

Rig up _____

Drilling and Remarks:

Fishing 850

RECORD

Cased _____ in., _____ ft.

Sand _____

Gas _____

Oil _____

Total Depth _____

PRODUCTION

1st 24 hrs. Nat. _____

1st 24 hrs. after shot _____

Gas _____ Cu. Ft.

Dry Hole _____

Abandoned _____

Date

8/71918Candy


Scout

Map No. _____ Sec. 24 Twp. 26 R. 4Well No. 22 JohnsonRamsey Petroleum Company_____
Contractor

NORTH

WEST

EAST

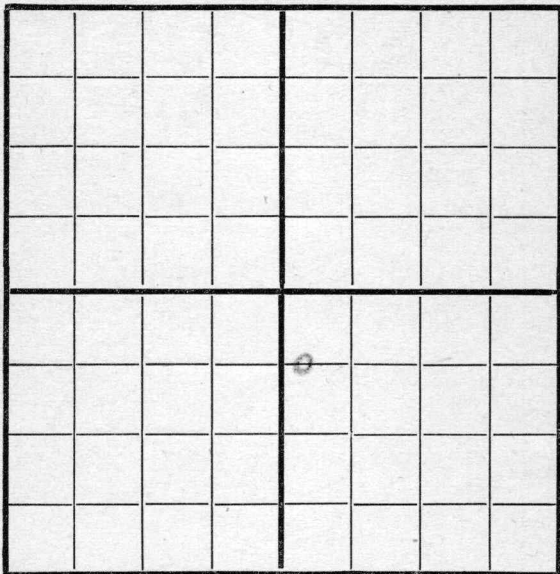

SOUTH

Location 660 N 200 W

Rig up _____

Drilling and Remarks:

fishing
@
800'

RECORD

Cased _____ in., _____ ft.

Sand _____

Gas _____

Oil _____

Total Depth _____

PRODUCTION

1st 24 hrs. Nat. _____

1st 24 hrs. after shot _____

Gas _____ Cu. Ft.

Dry Hole _____

Abandoned _____

Date


8/15 1918 C. y. h. Scout

Map No. _____ Sec. 24 Twp. 26 R. 4Well No. 2274Ramsey Petroleum Company_____
Contractor

NORTH

WEST

EAST

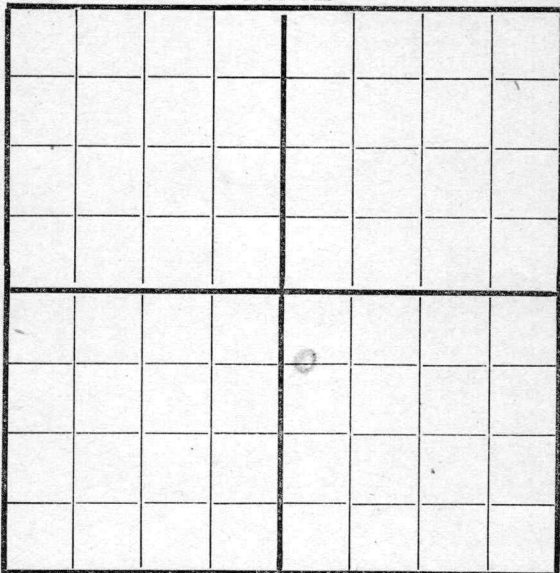

SOUTH

Location _____

Rig up _____

Drilling and Remarks:

Skid rig

RECORD

Cased _____ in., _____ ft.

Sand _____

Gas _____

Oil _____

Total Depth _____

PRODUCTION

1st 24 hrs. Nat. _____

1st 24 hrs. after shot _____

Gas _____ Cu. Ft.

Dry Hole _____

Abandoned _____

Date

8/23 1918Pyle

Scout

Map No. 174 Sec. 24 Twp. 26 R. 4

Well No. 22 Harmon
Ramsey Peto Company
 Contractor

NORTH

WEST

EAST

SOUTH

660 x 200 ft

Location _____

Rig up _____

Drilling and Remarks:

Spudding

RECORD

Cased _____ in., _____ ft.

Sand _____

Gas _____

Oil _____

Total Depth _____

PRODUCTION

1st 24 hrs. Nat. _____

1st 24 hrs. after shot _____

Gas _____ Cu. Ft.

Dry Hole _____

Abandoned _____

Date

8/38 8 191

Scout


Scout

Map No. 1514 Sec. 24 Twp. 26 R. 4Well No. 22 Hammer
Ramsay Petro Company
Contractor

NORTH

WEST

EAST

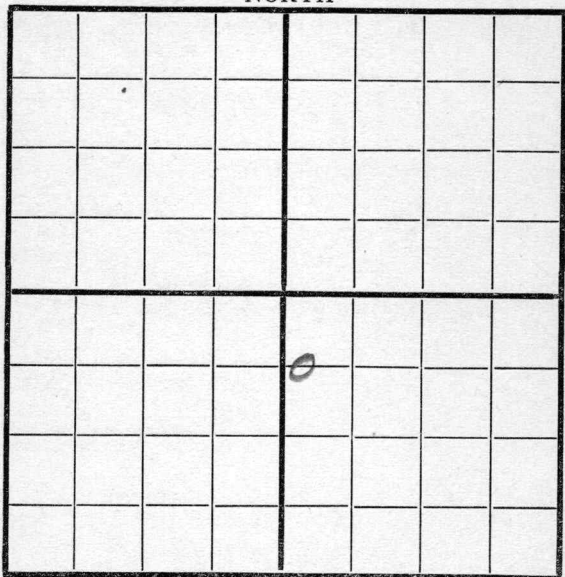

SOUTH

660 N - 200 W -

Location _____

Rig up _____

Drilling and Remarks:

1250

RECORD

Cased _____ in., _____ ft.

Sand _____

Gas _____

Oil _____

Total Depth _____

PRODUCTION

1st 24 hrs. Nat. _____

1st 24 hrs. after shot _____

Gas _____ Cu. Ft.


Dry Hole _____

Abandoned _____

Date

9/11 1911 J. Conley Scout

Map No. 1514 Sec. 24 Twp. 26 R. 4
Well No. 22 Hammer
Running Poles Company
Contractor

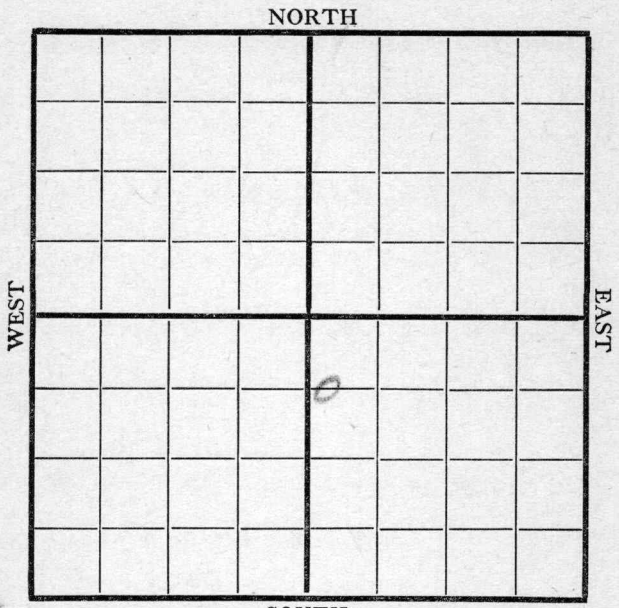

660X-300LV-

Location _____
Rig up _____
Drilling and Remarks:

1500

RECORD.


Cased _____ in., _____ ft.
Sand _____
Gas _____
Oil _____
Total Depth _____

PRODUCTION

1st 24 hrs. Nat. _____
1st 24 hrs. after shot _____
Gas _____ Cu. Ft.
Dry Hole _____
Abandoned _____

Date 9/18 1918 8 C. C. C. C. Scout

Map No. 1514 Sec. 24 Twp. 26 R. 4
Well No. 22 Herman
Bourne Petro Company
Contractor

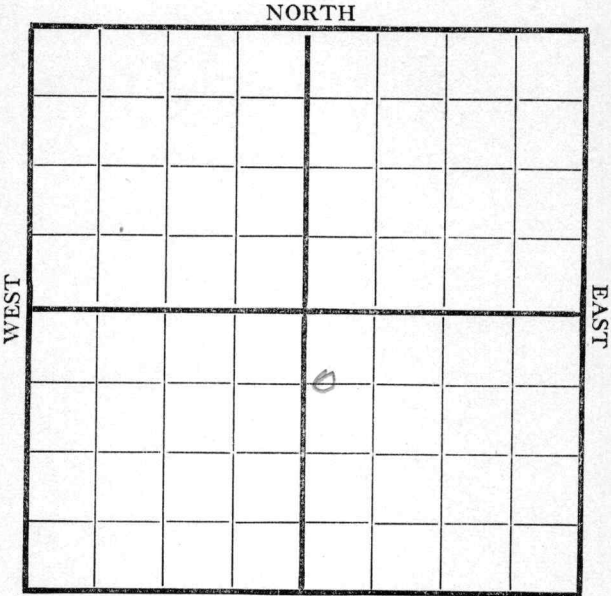

660A-200 W

Location _____ Rig up _____ Drilling and Remarks: <u>1780</u>	RECORD Cased _____ in., _____ ft. Sand _____ Gas _____ Oil _____ Total Depth _____
	PRODUCTION 1st 24 hrs. Nat. _____ 1st 24 hrs. after shot _____ Gas _____ Cu. Ft. Dry Hole _____ Abandoned _____

Date 9/25 1918 S. Cordy Scout

Map No. 1514 Sec. 24 Twp. 26 R. 4Well No. 22 HarmonBarney Peters Company

Contractor

NORTH									
WEST									EAST
SOUTH									

Location _____

Rig up _____

Drilling and Remarks:

2100**RECORD**

Cased _____ in., _____ ft.

Sand _____

Gas _____

Oil _____

Total Depth _____

PRODUCTION

1st 24 hrs. Nat. _____

1st 24 hrs. after shot _____

Gas _____ Cu. Ft.

Dry Hole _____

Abandoned _____

Date

10/2

191

8 Carley


Scout

Map No. K14 Sec. 24 Twp. 26 R. 4Well No. 22 Harmon
Roussy & Co. Company
Contractor

NORTH

WEST

EAST

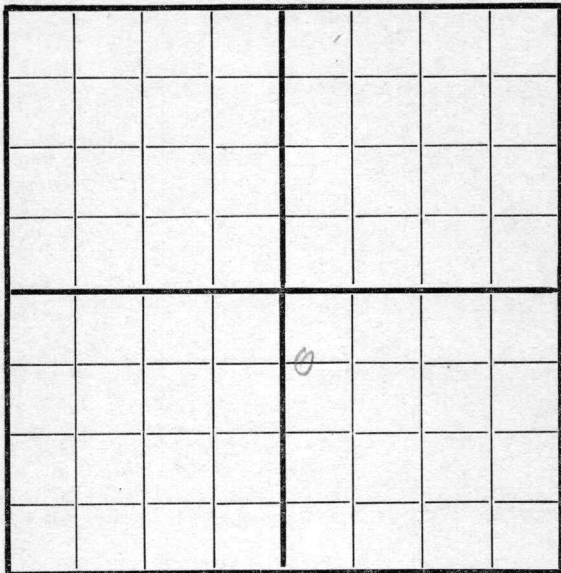

SOUTH

6608 300W

Location _____

Rig up _____

Drilling and Remarks:

2520

RECORD

Cased _____ in., _____ ft.

Sand _____

Gas _____

Oil _____

Total Depth _____

PRODUCTION

1st 24 hrs. Nat. _____

1st 24 hrs. after shot _____

Gas _____ Cu. Ft.

Dry Hole _____

Abandoned _____

Date

10/9 191 J. C. Condry Scout

Map No. K14 Sec. 24 Twp. 26 R. 4Well No. 22 Harmon
Running Petro Company
Frank Dilling Co Contractor

NORTH

WEST

EAST

COMPLETED

SOUTH

660' N - 200' W

Location _____

Rig up _____

Drilling and Remarks:

Est it
✓50 Blue

RECORD

Cased _____ in., _____ ft.

Sand 2631-2638

Gas _____

Oil _____

Total Depth _____

PRODUCTION

1st 24 hrs. Nat. _____

1st 24 hrs. after shot _____

Gas _____ Cu. Ft.

Dry Hole _____

Abandoned _____

Date

10/16 191 8 Carley Scout