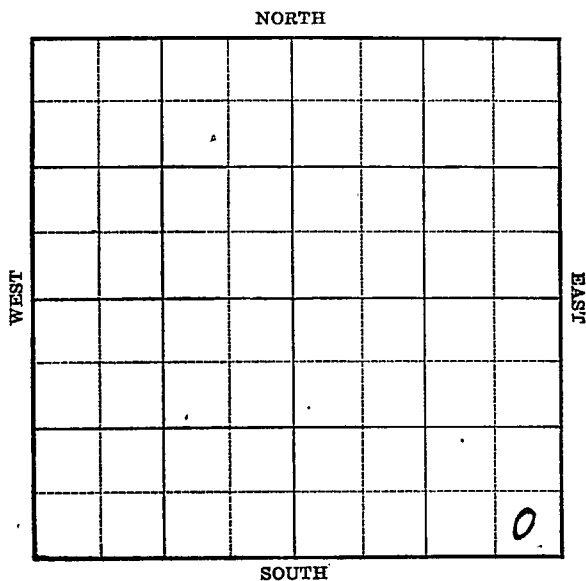



Section 20 Township 26 Range 7-EWell No. 2 JohnsonCompany Rex & Morris et al

KANSAS

Butler

Sec. 20 Twp. 26 R. 7-EWell No. #2 Johnson FarmRex & Morris et al

Company

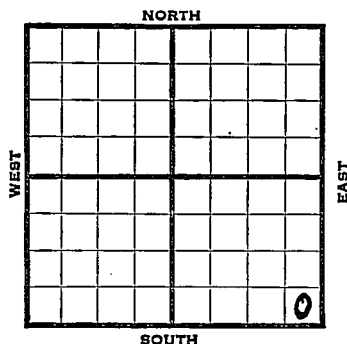 Ft. from N. Line330 Ft. from S. Line330 Ft. from E. Line Ft. from W. Line

Elev. 1457

1938	REPORT
11/30	Location
12/9	Spud.
12/15	12" - 788'. Drlg. 1270'.
12/23	10" - 1600'. Drlg. 1800'.
12/30	K. C. 2185 ²⁰⁶⁵ T. D. 2193'.
	8" - 2185'. C. O.
1939	
1/6	" " " "
1/13	K. C. 2185 ²⁰⁶⁵ (Corrected)
	Pay 2185-91'. T. D. 2195'.
	Dr lg. cement.
1/20	T. D. 2195'. 2000 acid.
	Pump 20 oil in 24 hrs.
1/25	8" - 2185'.
	K. C. 2065' (Corrected)
	T. D. 2195'.
	2000 acid.
	Potential 30 oil.
	COMPLETED

Butler

KANSAS

Map No. 15 Sec. 20 Twp. 26 R. 7EWell No. 2 JohnsonRex & Morris etal

Company

Contractor

FIRST REPORT

SE/C

 Ft. from N. Line330 Ft. from S. Line330 Ft. from E. Line Ft. from W. Line

SECTION PLAT

			0

Location XRig up

Drilling and Remarks:

RECORD

Cased in., ft.Sand Gas Oil Total Depth

PRODUCTION

1st 24 hrs: Nat. 1st 24 hrs. after shot Gas Cu. Ft.Dry Hole Abandoned

Date

NOV 30 1938 19

H. D. Hatfield Scout

Butler **KANSAS**Map No. 15 Sec. 20 Twp. 26 R. 7EWell No. 2 JohnsonRex & Morris etal Company

Contractor

COMPLETED**SE/C** Ft. from N. Line330 Ft. from S. Line330 Ft. from E. Line Ft. from W. Line**GUENTHER POOL****SECTION PLAT**

2			0

Location Rig up

Drilling and Remarks:

*2000 Acid**Pot 30 oil***RECORD**Cased 8 in., 2185 ft.Sand K C 2065Gas (Corrected)Oil Total Depth 2195**PRODUCTION**1st 24 hrs. Nat. 1st 24 hrs. after shot Gas Cu. Ft.Dry Hole Abandoned

Date

JAN 25 1932

19

H. D. Hatfield Scout