

KANSAS

Form 51—5M—7-39—Palace

Butler

Section 20 Township 26 Range 7-E

Well No. #3 Johnson

Company Rex & Morris et al

NORTH

Guenther Pool

WEST									EAST

0

SOUTH

KANSAS


Butler

Sec. 20 Twp. 26 R. 7-EWell No. #3 Johnson FarmRex & Morris et al Company

(Guenther)

 Ft. from N. Line990 Ft. from S. Line330 Ft. from E. Line Ft. from W. Line

Elev. 1458

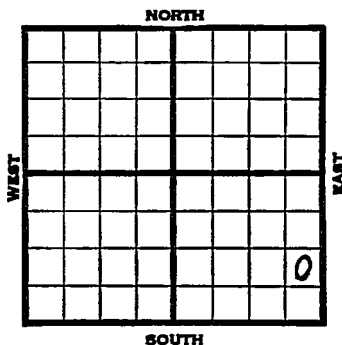

1939

REPORT

10/4

Location

10/12

Machine.

10/19

Drig. 585'

10/26

12" - 832' Drig. 1612'

11/2

K. C. 2065' 8" - 2176'

T.D. 2189' WOC. P.B.P.

11/8

K. C. 2065'

8" - 2176'

T.D. 2189'

2000 acid.

30 bbls. oil.

COMPLETED

Butler

KANSAS

Map No. 15 Sec. 20 Twp. 26 R. 7EWell No. 3 JohnsonRex & Morris etal

Company

Contractor

FIRST REPORT

NE SE SE

SECTION PLAT

			o

 Ft. from N. Line990 Ft. from S. Line330 Ft. from E. Line Ft. from W. Line

GUENTHER POOL

Location X

RECORD

Cased in., ft.Sand Gas Oil Total Depth 4

PRODUCTION

1st 24 hrs. Nat. 1st 24 hrs. after shot Gas Cu. Ft.Dry Hole Abandoned

Drilling and Remarks:

Date

OCT 4 1939 19S. J. LEWIS Scout

Butler

KANSAS

Map No. 15 Sec. 20 Twp. 26 R. 7EWell No. 3 JohnsonRex & Morris etal Company

Contractor

COMPLETED

NE SE SE

SECTION PLAT

			o

 Ft. from N. Line990 Ft. from S. Line330 Ft. from E. Line Ft. from W. Line

GUENTHER POOL

Location

RECORD

Cased in., ft.Sand Gas Oil Total Depth 2189

PRODUCTION

1st 24 hrs. Nat. 1st 24 hrs. after shot Gas Cu. Ft.Dry Hole Abandoned Rig up

Drilling and Remarks:

*KC 2065**8" C2176**2000 acal**30 ft*

Date

NOV 9 1939 19

J. J. LEWIS Scout