

KANSAS

Butler

Form 51-5M-7-39-Palace

Section 20 Township 26 Range 7-E

Well No. #5 Johnson

Company Rex & Morris

NORTH Miscellaneous

							0

WEST

EAST

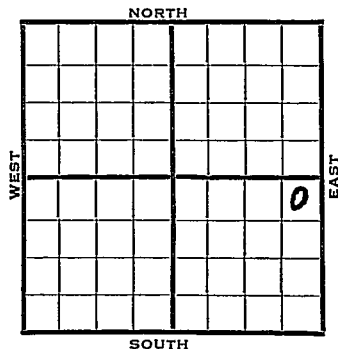
SOUTH

KANSAS

Butler

Sec. 20 Twp. 26 R. 7-EWell No. #5 Johnson FarmRex & Morris Company

(Misc.)

330 Ft. from N. Line Ft. from S. Line490 Ft. from E. Line Ft. from W. LineElev. 1471

1940	REPORT
5/15	Machine.
5/23	12" - 810'
5/29	10" - 1607'
	Drlg. 1670'
6/6	8" - 2192' Drlg. 2555'
6/13	Miss. 2740' 7" - 2740'
	T.D. 2768' S.O. 2000 acid.
6/29	" " " " " "
6/26	Miss. 2740'
	7" - 2740'
	T.D. 2768'
	2000 acid.
	35 bbls.
	COMPLETED

Map No. 15 Sec. 20 Twp. 26 R. 7EWell No. 5 JohnsonRex & Morris

Company

Contractor

FIRST REPORT

NE SE

330 Ft. from N. Line Ft. from S. Line490 Ft. from E. Line Ft. from W. Line

MISCELLANEOUS

SECTION PLAT

			0

Location Rig up

Drilling and Remarks:

Machine

RECORD

Cased in., ft.Sand Gas Oil Total Depth

PRODUCTION

1st 24 hrs. Nat. 1st 24 hrs. after shot Gas Cu. Ft.Dry Hole Abandoned

Date

MAY 15 1940

19

S. J. LEWIS Scout

Map No. 15 Sec. 20 Twp. 26 R. 7EWell No. 5 JohnsonRex & Morris

Company

Contractor

COMPLETED

NE SE

330 Ft. from N. Line Ft. from S. Line490 Ft. from E. Line Ft. from W. Line**SECTION PLAT**

			o

MISCELLANEOUSLocation Rig up

Drilling and Remarks:

*Mix 2740**7" @ 2740**2000 acid**358 ft***RECORD**Cased in., ft.Sand Gas Oil Total Depth 2768**PRODUCTION**1st 24 hrs. Nat. 1st 24 hrs. after shot Gas Cu. Ft.Dry Hole Abandoned

Date

JUN 26 1940 19S. J. LEWIS Scout