

KANSAS


Form 51-5M-11-38-Palace

Butler

Section 20 Township 26 Range 7-E

Well No. #4 Johnson

Company Rex & Morris et al

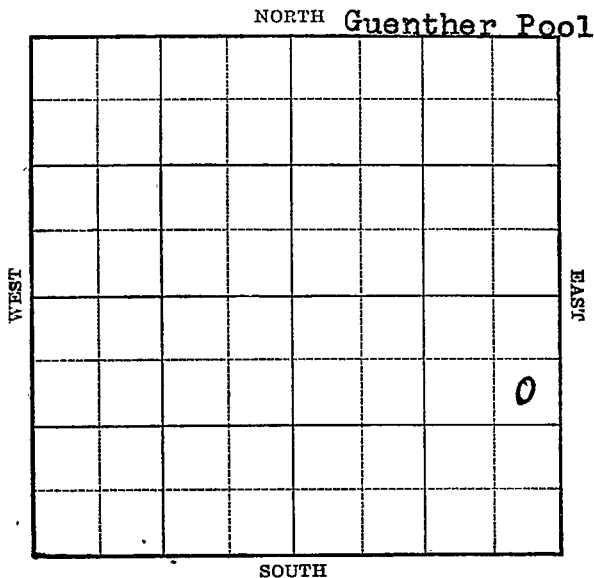


Sec. 20 Twp. 26 R. 7 EWell No. #4 Johnson FarmRex & Morris et al Company

(Guenther)

990 Ft. from N. Line Ft. from S. Line330 Ft. from E. Line Ft. from W. Line

Elev. 1466

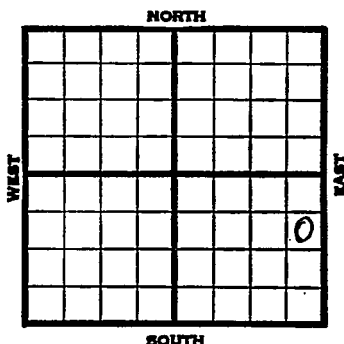

1939	REPORT
11/8	Material.
11/16	Drlg. 605'
11/23	12" - 807' 10" - 1616' Drlg. 1795'
11/29	K. C. 2190' drlg.
12/7	7" - 2737' WOC.
12/14	Miss. 2740' 7" - 2739' T.D. 2777' WOC.
12/21	TD 2777' SD.
12/27	Miss. 2740'
	7" - 2739'
	T.D. 2777'
	2000 acid.
	35 bbls. oil.
	COMPLETED

Butler

KANSAS

Map No. 15 Sec. 20 Twp. 26 R. 7EWell No. 4 JohnsonRex & Morris etal

Company

Contractor

FIRST REPORT

SE NE SE

990 Ft. from N. Line Ft. from S. Line330 Ft. from E. Line Ft. from W. Line**SECTION PLAT**

			o

GUENTHER POOLLocation Rig up

Drilling and Remarks:

Material**RECORD**Cased in., ft.Sand Gas Oil Total Depth **PRODUCTION**1st 24 hrs. Nat. 1st 24 hrs. after shot Gas Cu. Ft.Dry Hole Abandoned

Date

NOV 8 1939

19

Scout

Map No. 15 Sec. 20 Twp. 26 R. 7EWell No. 4 JohnsonRex & Morris etal Company

Contractor

COMPLETED**SE NE SE****SECTION PLAT**

			o

990 Ft. from N. Line Ft. from S. Line330 Ft. from E. Line Ft. from W. Line**GUENTHER POOL**Location Rig up

Drilling and Remarks:

*Miss 2740**7" @ 2739**2000 and**35 5/8***RECORD**Cased in., ft.Sand Gas Oil Total Depth 2777**PRODUCTION**1st 24 hrs. Nat. 1st 24 hrs. after shot Gas Cu. Ft.Dry Hole Abandoned

Date

DEC 27 1939 19S. J. LEWIS Scout