


Section 20 Township 26 Range 7E

Well No. #1 Johnson

Company J. E. Morris & Eldorado Ref.

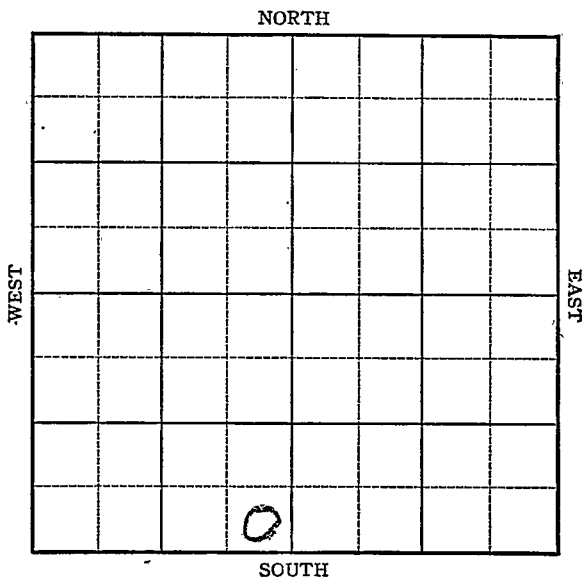


Sec. 20 Twp. 26 R. 7EWell No. #1 Johnson FarmJ. E. Morris & Eldorado Ref. Company

Miscellaneous

         Ft. from N. Line330 Ft. from S. Line330 Ft. from E. Line         Ft. from W. Line

SE SW

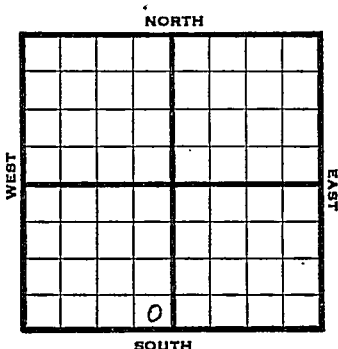

1946 Elev. 1474' REPORT

1/9 RUR

1/17 857' run 12".

1/24 12" - 920' 1650' run 10"

1/31 10" - 1612' 8" - 2264'

Drlg. 2450'

2/6 Miss. 2758

6" @ 2758

TD 2851'

ABANDONED

KANSAS


Kansas Pool Name MiscellaneousMap No. 15 Sec. 20 Twp. 26 R. 7EWell No. 1 JohnsonJ. E. Morris and Eldorado Ref. Company

## FIRST REPORT

Contractor

SE SW

## SECTION PLAT

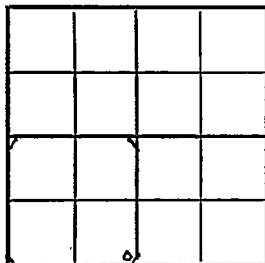

Ft. from N. Line

330

Ft. from S. Line

330

Ft. from E. Line

Ft. from W. Line

Butler County

Location

Rig up

Drilling and Remarks:

RUR

## RECORD

Cased \_\_\_\_\_ in. \_\_\_\_\_ ft.

Sand \_\_\_\_\_

Gas \_\_\_\_\_

Oil \_\_\_\_\_

Total Depth \_\_\_\_\_

## PRODUCTION

1st 24 hrs. Nat. \_\_\_\_\_

1st 24 hrs. after shot \_\_\_\_\_

Gas \_\_\_\_\_ Cu. Ft.

Dry Hole \_\_\_\_\_

Abandoned \_\_\_\_\_

Date

JAN 9 1946 19 S. J. LEWIS Scout

**KANSAS** Kansas Pool Name Miscellaneous  
 Map No. 12 Sec. 20 Twp. 26 R. 7E

Well No. 1 Johnson


J.D. Morris and Eldorado Ref. Company

**ABANDONED**

Contractor

Se SW

E11474  
**SECTION PLAT**

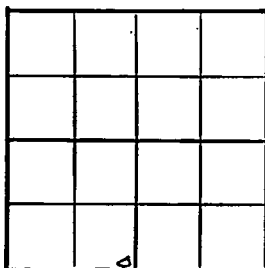

       Ft. from N. Line

330 Ft. from S. Line

330 Ft. from E. Line

       Ft. from W. Line

Butler County

Location                                 

Rig up                                 

Drilling and Remarks:

*Misc 208*  
*6" @ 275'*

**RECORD**

Cased            in.,            ft.

Sand                                 

Gas                                 

Oil                                 

Total Depth 285'

**PRODUCTION**

1st 24 hrs. Nat.                                 

1st 24 hrs. after shot                                 

Gas                                  Cu. Ft.

Dry Hole                                 

Abandoned                                 

Date

FEB 6 1946 19

S. J. LEWIS Scout