

Butler

Section 21 Township 26 Range 7^EWell No. 1 AllenCompany Rex & Morris

NORTH

Miscellaneous

0							

WEST

EAST

SOUTH


KANSAS**Butler**Sec. 21 Twp. 26 R. 7 EWell No. #1 Allen FarmRex & Morris Company

(Miscellaneous)

 Ft. from N. Line990 Ft. from S. Line Ft. from E. Line330 Ft. from W. Line

Elev. 1456 Gr.

1459 Est Floor

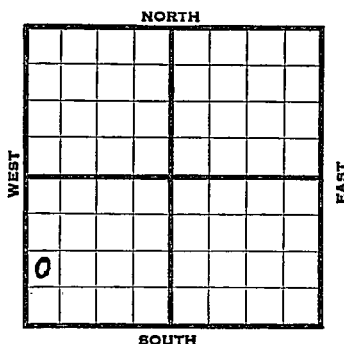

1939	REPORT
4/12	Location
4/21	"
4/28	"
5/5	"
5/12	"
5/19	Spud & SD.
5/26	Drlg. 230'
6/1	12" - 782' Drlg. 1235'
6/8	10" @ 1625'
	Lansing 1765'
	Drlg. 1810'
6/16	Miss. 2733' T.D. Run 6".
6/23	T.D. 2757' 6" - 2735' WOC.
6/28	Miss. 2733'
	6" - 2725'
	T.D. 2757'
	2000 acid.
	Pump 40 oil & 10 water in.
	COMPLETED

Map No. 15 Sec. 21 Twp. 26 R. 7EWell No. 1 AllenRex & Morris Company

Contractor

FIRST REPORT

NW SW SW

 Ft. from N. Line990 Ft. from S. Line Ft. from E. Line330 Ft. from W. Line

SECTION PLAT

0			

MISCELLANEOUS

Location XRig up

Drilling and Remarks:

RECORD

Cased in., ft.Sand Gas Oil Total Depth

PRODUCTION

1st 24 hrs. Nat. 1st 24 hrs. after shot Gas Cu. Ft.Dry Hole Abandoned

Date

APR 12 1939 19 H. D. Hatfield Scout

Butler

KANSAS

Map No. 15 Sec. 21 Twp. 26 R. 7EWell No. 1 AllenRex & Morris etal

Company

Contractor

COMPLETED

NW SW SW

 Ft. from N. Line990 Ft. from S. Line Ft. from E. Line330 Ft. from W. Line

SECTION PLAT

0			

MISCELLANEOUS

Location Rig up

Drilling and Remarks:

*Miss 2733**6" @ 2725**2000 acid**Pump 40 oil**10 Water*

RECORD

Cased in., ft.Sand Gas Oil Total Depth 2752

PRODUCTION

1st 24 hrs. Nat. 1st 24 hrs. after shot Gas Cu. Ft.Dry Hole Abandoned

Date

JUN 28 1939

19

S. J. LEWIS

Scout