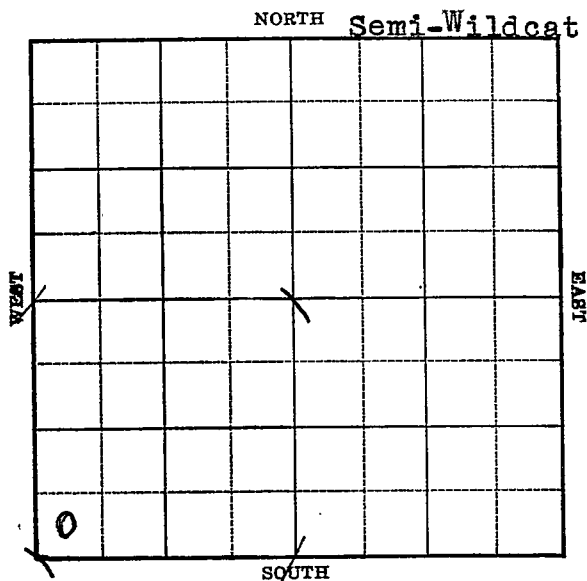


Butler

KANSAS

Section 23 Township 26 Range 7-EWell No. 1 DunneCompany Adair & Morton

Map No. 15 Sec. 23 Twp. 26 R. 7EWell No. 1 DunneAdair & Morton


Company

Contractor

FIRST REPORT

SW/C

SECTION PLAT

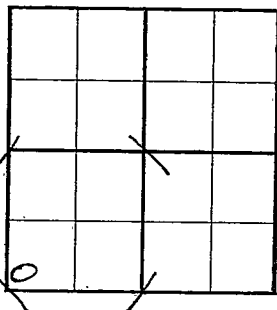 Ft. from N. Line330 Ft. from S. Line Ft. from E. Line330 Ft. from W. Line

SEMI-WILDCAT

Location Rig up

Drilling and Remarks:

12" - 912

Drlg. 915

RECORD

Cased in., ft.Sand Gas Oil Total Depth

PRODUCTION

1st 24 hrs. Nat. 1st 24 hrs. after shot Gas Cu. Ft.Dry Hole Abandoned

Date

MAR 1 - 1939

19

H. D. Hatfield

Scout

Butler

KANSAS

Map No. 15 Sec. 23 Twp. 26 R. 7EWell No. 1 Dunne

Adair & Morton

Company

Contractor

ABANDONED

SW/C

____ Ft. from N. Line

330 Ft. from S. Line

____ Ft. from E. Line

330 Ft. from W. Line

SEMI-WILDCAT

SECTION PLAT

Location _____

Rig up _____

Drilling and Remarks:

RECORD

Cased 6 in., 2741 ft.Sand MISS 2739

Gas _____

Oil _____

Total Depth 2775

PRODUCTION

1st 24 hrs. Nat. _____

1st 24 hrs. after shot _____

Gas _____ Cu. Ft.

Dry Hole _____

Abandoned _____

Date

APR 12 1939

19

H. D. Hatfield

Scout