

KANSAS


FORM 51 IOM 12-46 PETROL

Butler county
Miscellaneous

Section 24 Township 26 Range 4E

Well No. 3 "B" Harmon

Company Harmon Oil

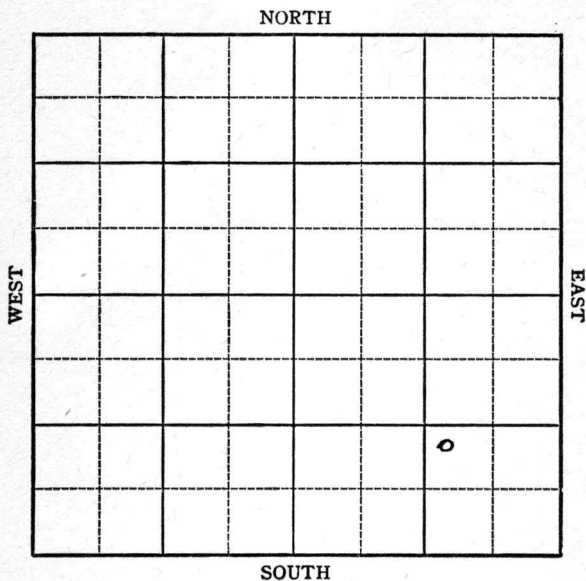


KANSAS

Butler

Sec. 24 Twp. 26 R. 4-E

Well No. #3 "B" Harmon (twin well) Farm
Harmon Oil Company

 Ft. from N. Line
1035 Ft. from S. Line
1120 Ft. from E. Line
 Ft. from W. Line

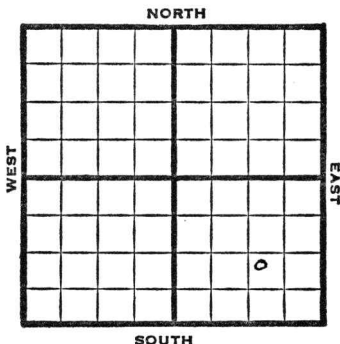

NW SE SE

REPORT

1947

4/23 12" @ 231'
10" @ 1707'
Land 1885'
Drlg 1925'

4/29 KC 2090
8" @ 2330'
Arb 2654
7" @ 2655
WOC

5/7 Arb 2654
7" @ 2655
1000 Acid
Pump 20 Pot
Grav. 38
TD 2660'

COMPLETED

Map No. K 14 Sec. 24 Twp. 26 R. 4E

Well No. 3 "B" Harmon

Harmon Oil Company

FIRST REPORT

Contractor

NW SE SE

SECTION PLAT

			o

 Ft. from N. Line

1035 Ft. from S. Line

1120 Ft. from E. Line

 Ft. from W. Line

Butler County

Location

Rig up

Drilling and Remarks:

twin well

12" @ 231

10" @ 1807

Lans. 1885

drlg. 1925

RECORD

Cased in., ft.

Sand

Gas

Oil

Total Depth

PRODUCTION

1st 24 hrs. Nat.

1st 24 hrs. after shot

Gas Cu. Ft.

Dry Hole

Abandoned

Date

APR 23 1947

19

S. J. LEWIS

Scout

KANSAS

Miscellaneous

Form 26 200 Bks. 10-46 Petrol

Kansas

Map No. K 14 Sec. 24 Twp. 26 R. 4EWell No. 3 "B" HarmonHarmon Oil CompanyCOMPLETE Contractor

NW SE SE

SECTION PLAT

			△

 Ft. from N. Line1035 Ft. from S. Line1120 Ft. from E. Line Ft. from W. LineButler CountyLocation Rig up

Drilling and Remarks:

See 2654
7102655
1000 acid
Pump. 20 Bx

380 4

RECORD

Cased in., ft.Sand Gas Oil Total Depth 2660

PRODUCTION

1st 24 hrs. Nat. 1st 24 hrs. after shot Gas Cu. Ft.Dry Hole Abandoned

Date

MAY 7 1947 19 S. J. LEWIS Scout