

Section 25 Township 26 Range 7 EWell No. # 1 FilmoreCompany John C. Graves

NORTH

WEST

EAST


SOUTH

Butler

KANSAS

Sec. 25 Twp. 26 R. 7EWell No. #1 Filmore FarmJohn C. Graves. CompanyRex & Morris Contractor
Wildcat. Ft. from N. Line330 Ft. from S. Line Ft. from E. Line330 Ft. from W. Line

SW SW SE

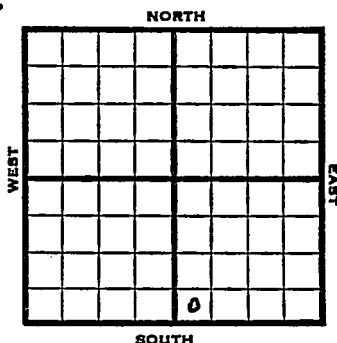

1953

Elev. 1505'

REPORT

6/17

Loc.

7/15

Spud 6-21-53

D&A

TD 2794

8" @ 109

KC 2085, B KC 2254, Bart 2693, Miss
2781

TD 2794

5" @ 2767

CO to 2730, 40/2694-2706, VSSO


St-frac 2½ bwph

D&A

ABANDONED

J. G. McGEHEE

County Butler State Kansas
 Sec. 25 (Blk. Twp.) 26 (Sur. Rge.) 7E Map No. _____
 Operator John C. Graves
 Well No. 1 Farm Filmore
 Elev. 1505 Location SW SW SE

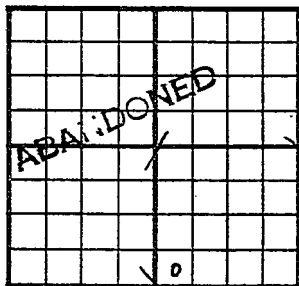

330 Ft. From S Line SE
330 Ft. From W Line Quarter

1st. Report

Completion JUL 15 1953

Remarks Wildcat
Rex & Morris - Contr.

Spudding Date 6-21-53

Drig. Data D & A TD 2794

8" @ 109 KC 2085 B KC 2254

Bart. 2693 Miss. 2781 TD 2794

5" @ 2767 CO to 2730 40/ 2694-2706

VSSO st-frac $2\frac{1}{2}$ bwph

D & A

J. G. McGEHEE