

Map No. _____ Sec. 13 Twp. 26 R. 4
 Well No. 8, Mobry Farm _____
Lulby Company _____

NORTH

WEST



EAST

SOUTH

Location _____

Rig Up _____

Drilling Remarks:

Drilling Remarks:

RECORD

Cased _____ in. _____ ft.

Sand _____

Gas _____

Oil _____

Total Depth _____

PRODUCTION

1st 24 hrs. Nat. _____

1st 24 h.s. after shot _____

Gas _____ cu. ft

Dry Hole _____


Abandoned _____

Map No. _____ Sec. 13 Twp. 26 R. 4Well No. 8 Mabry Farm _____

_____ Company _____

NORTH

WEST

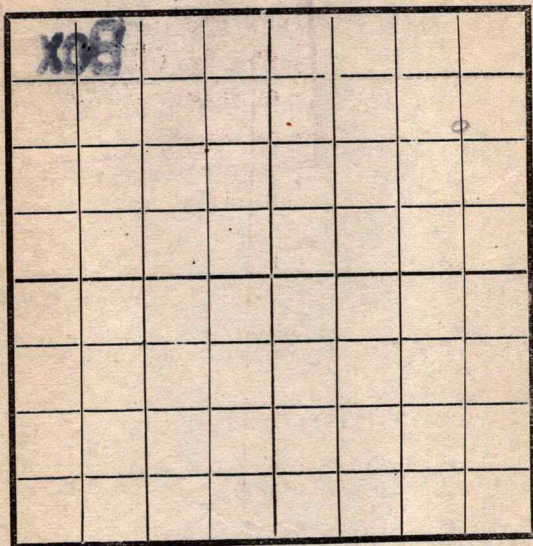

EAST

SOUTH

Location _____

Rig Up _____

Drilling and remarks _____

RECORD

Cased _____ in. _____ Ft.

Sand _____

Gas _____

Oil _____

Total Depth _____

PRODUCTION

1st 24 hrs. Nat. _____

1st 24 hrs. after shot _____

Gas _____ Cu. Ft.

Dry Hole _____

Abandoned _____

First Report

Date

11/28, 1917 Condy Scout _____

Map No. _____ Sec. 13 Twp. 26 R. 4Well No. 82206 Farm _____

_____ Company _____

NORTH

WEST

EAST

SOUTH

RECORD

Location _____

Cased _____ in. _____ Ft.

Rig Up _____

Sand _____

Drilling and remarks

Gas _____

Oil _____

Total Depth _____

PRODUCTION

1st 24 hrs. Nat. _____

1st 24 hrs. after shot _____

Gas _____ Cu. Ft.

Dry Hole _____

Abandoned _____


Date

12/5, 1917 Conley Scout _____

Map No. _____ Sec. 13 Twp. 26 R. 4
 Well No. 8 Crosby Farm _____
Selby Oil Company _____

NORTH

WEST

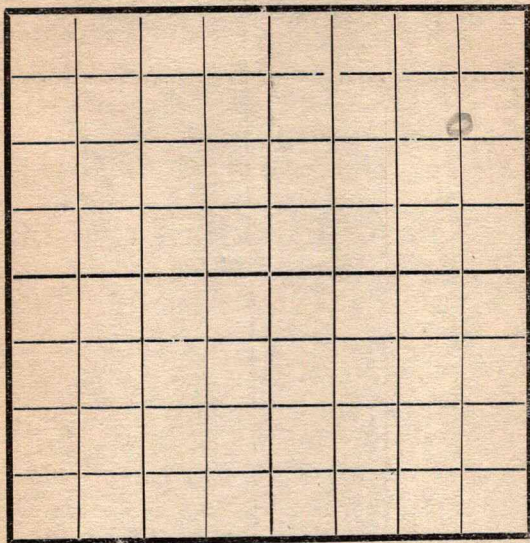

EAST

SOUTH

Location _____

Rig Up _____

Drilling and remarks

1400

RECORD

Cased _____ in. _____ Ft.

Sand _____

Gas _____

Oil _____

Total Depth _____

PRODUCTION

1st 24 hrs. Nat. _____

1st 24 hrs. after shot _____

Gas _____ Cu. Ft.

Dry Hole _____


Abandoned _____

Date

1/2, 1918 Crosby Scout

Map No. _____ Sec. 13 Twp. 26 R. 4
Well No. 8 _____ Farm _____
Sally Oil _____ Company _____

NORTH

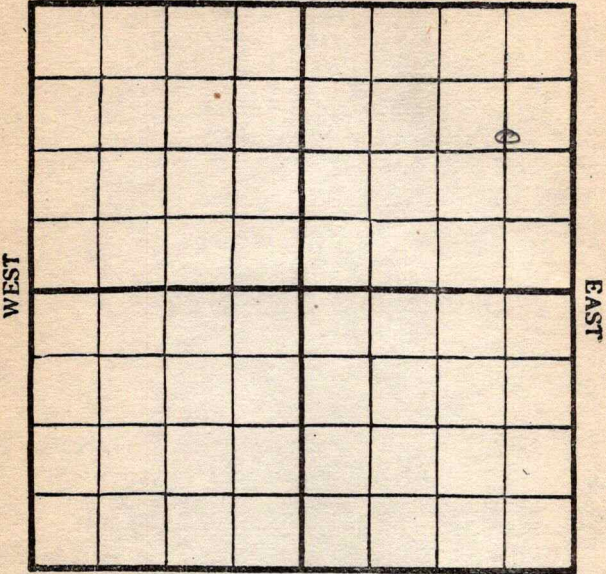

SOUTH

Location _____
Rig Up _____
Drilling and remarks _____

1670

RECORD

Cased _____ in. _____ Ft.
Sand _____
Gas _____
Oil _____
Total Depth _____

PRODUCTION

1st 24 hrs. Nat. _____
1st 24 hrs. after shot _____
Gas _____ Cu. Ft.
Dry Hole _____
Abandoned _____

Date 1/16, 1918, Carney Scout

Map No. _____ Sec. 13 Twp. 26 R. 4Well No. 8 Mubury Farm _____Selby Oil Company _____

NORTH

WEST

EAST

SOUTH

RECORD

Location _____

Cased _____ in. _____ Ft.

Rig Up _____

Sand _____

Drilling and remarks

Gas _____

Oil _____

Total Depth _____

PRODUCTION

1st 24 hrs. Nat. _____

1st 24 hrs. after shot _____

Gas _____ Cu. Ft.

Dry Hole _____

Abandoned _____

Date

1/23, 1918 Candey Scout

Map No. _____ Sec. 13 Twp. 26 R. 4Well No. S Mabry Farm _____Selby Company _____

NORTH

WEST

EAST

SOUTH

Location _____

Rig Up _____

Drilling and remarks

Isling
1670

RECORD

Cased _____ in. _____ Ft.

Sand _____

Gas _____

Oil _____

Total Depth _____

PRODUCTION

1st 24 hrs. Nat. _____

1st 24 hrs. after shot _____

Gas _____ Cu. Ft.

Dry Hole _____

Abandoned _____

Date

1/30, 1918 C. C. C. C. Scout _____

Form 143A-12-17-55 DKS 3745

Map No. _____ Sec. 13 Twp. 26 R. 4
Well No. 8 Ruby Farm _____
Selby Company _____
Date Started _____ Ft. from N _____ S _____ E _____ W _____ line
NORTH

WEST								
								EAST
SOUTH								

Cased _____ In. _____ Ft. _____
Sand _____
Pay { Gas _____
 Oil _____
Total Depth _____

Production Remarks

Condition of Well on this date _____

Fishing 1670


Cordell

Scout

Map No. _____ Sec. 13 Twp. 26 R. 4Well No. 8 Murphy FarmSellyo Company

NORTH

WEST

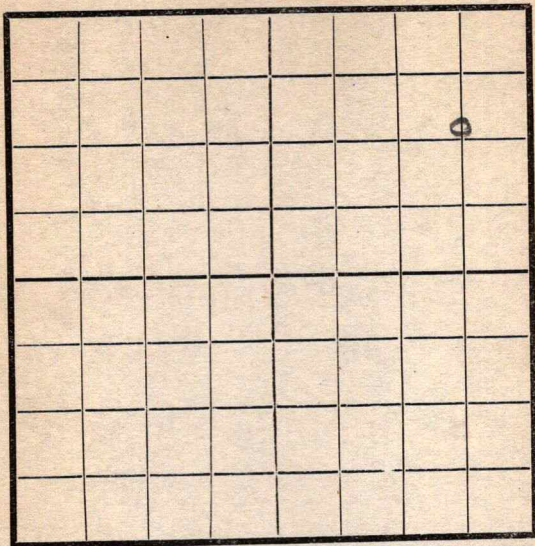

EAST

SOUTH

Location _____

Rig Up _____

Drilling and remarks

Shut down1670

RECORD

Cased _____ in. _____ Ft.

Sand _____

Gas _____

Oil _____

Total Depth _____

PRODUCTION

1st 24 hrs. Nat. _____

1st 24 hrs. after shot _____

Gas _____ Cu. Ft.

Dry Hole _____

Abandoned _____

Date


2/13, 1918 Conroy Scout

Map No. _____ Sec. 13 Twp. 26 R. 4
Well No. 8 _____ Farm _____
Selby _____ Company _____

NORTH

WEST

EAST

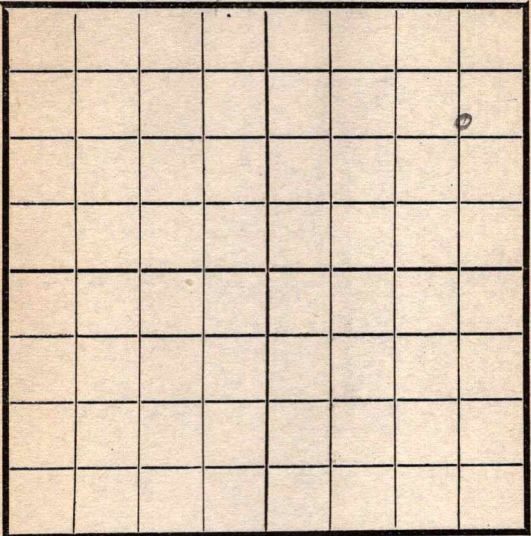

SOUTH

RECORD	
Location _____	Cased _____ in. _____ Ft.
Rig Up _____	Sand _____
Drilling and remarks	Gas _____
	Oil _____
	Total Depth _____
	PRODUCTION
Skidded Rig	1st 24 hrs. Nat. _____
	1st 24 hrs. after shot _____
	Gas _____ Cu. Ft.
	Dry Hole _____
	Abandoned _____

Date 2/20, 1918 Selby Scout

Map No. _____ Sec. 13 Twp. 26 R. 14Well No. S 2nd Farm _____

Company _____

NORTH

WEST

EAST

SOUTH

Location _____

Rig Up _____

Drilling and remarks

UR 1670

RECORD

Cased _____ in. _____ Ft.

Sand _____

Gas _____

Oil _____

Total Depth _____

PRODUCTION

1st 24 hrs. Nat. _____

1st 24 hrs. after shot _____

Gas _____ Cu. Ft.

Dry Hole _____

Abandoned _____


Date

7-27, 1918 S. Conder Scout

Map No. _____ Sec. 13 Twp. 26 R. 4
 Well No. 8 Mobley Farm _____
Selby Company _____

NORTH

WEST

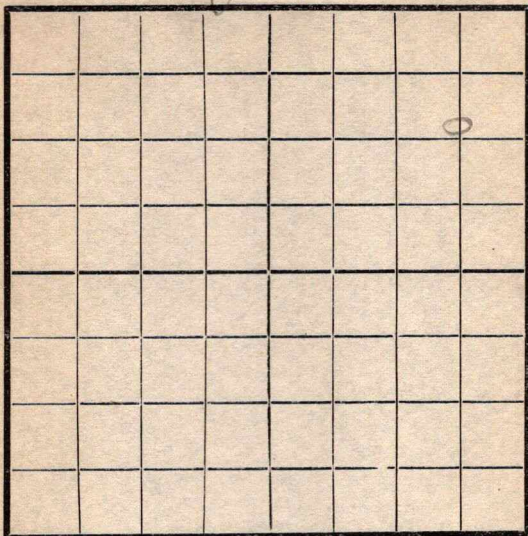

EAST

SOUTH

Location _____
 Rig Up _____
 Drilling and remarks

WR 1670

RECORD

Cased _____ in. _____ Ft.
 Sand _____
 Gas _____
 Oil _____
 Total Depth _____

PRODUCTION

1st 24 hrs. Nat. _____
 1st 24 hrs. after shot _____
 Gas _____ Cu. Ft.
 Dry Hole _____
 Abandoned _____

Date


3/6, 1918 E. Condey Scout _____

Map No. _____ Sec. 13 Twp. 26 R. 4Well No. 8 _____ Farm _____

_____ Company _____

NORTH

WEST

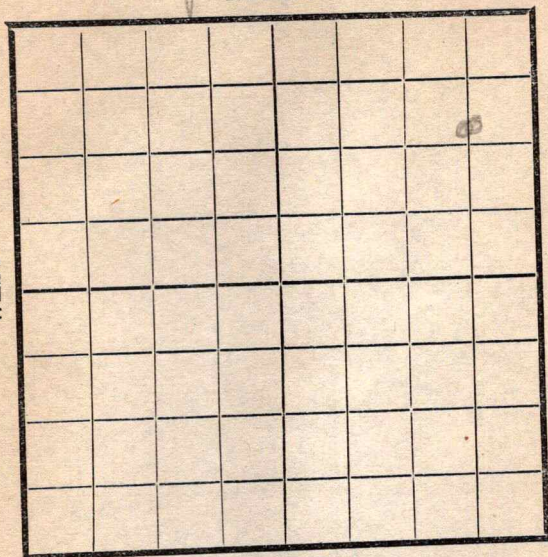

EAST

SOUTH

Location _____

Rig Up _____

Drilling and remarks

WR 1670

RECORD

Cased _____ in. _____ Ft.

Sand _____

Gas _____

Oil _____

Total Depth _____

PRODUCTION

1st 24 hrs. Nat. _____

1st 24 hrs. after shot _____

Gas _____ Cu. Ft.

Dry Hole _____

Abandoned _____


Date

5/13, 1918 Scout

Map No. _____ Sec. 13 Twp. 26 R. 4Well No. 8 Farm _____Sally Oil Company _____

NORTH

WEST

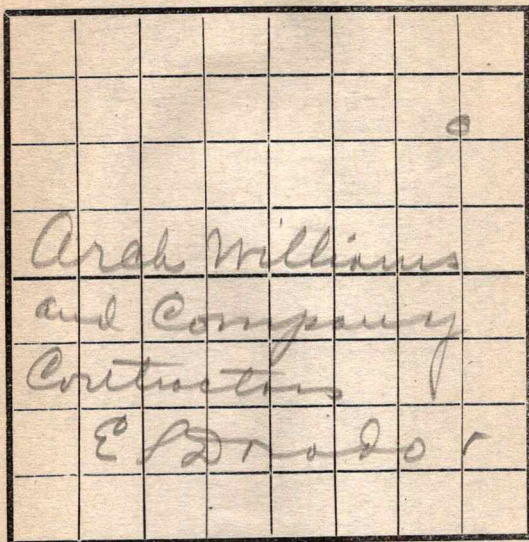

EAST

SOUTH

Location _____

Rig Up _____

Drilling and remarks

Skidded rig
from old hole
which is abandoned
at 1670

RECORD

Cased _____ in. _____ Ft.

Sand _____

Gas _____

Oil _____

Total Depth _____

PRODUCTION

1st 24 hrs. Nat. _____

1st 24 hrs. after shot _____

Gas _____ Cu. Ft.

Dry Hole _____

Abandoned _____


Date

3/30, 1911 S. Conroy Scout

Map No. _____ Sec. 13 Twp. 26 R. 4Well No. 8 moby Farm _____Delby Company _____

NORTH

WEST

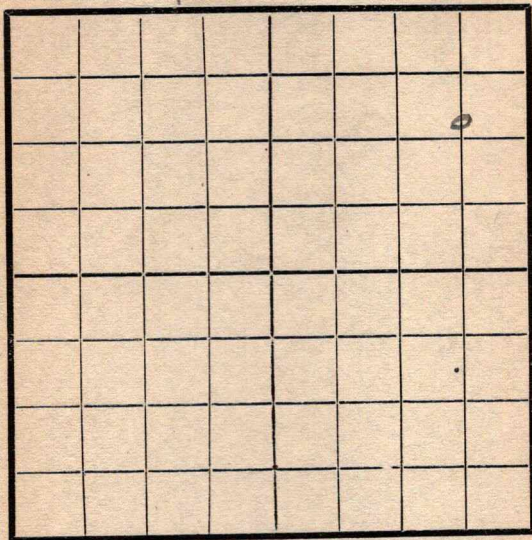

EAST

SOUTH

Location _____

Rig Up _____

Drilling and remarks

Spilling

RECORD

Cased _____ in. _____ Ft.

Sand _____

Gas _____

Oil _____

Total Depth _____

PRODUCTION

1st 24 hrs. Nat. _____

1st 24 hrs. after shot _____

Gas _____ Cu. Ft.

Dry Hole _____

Abandoned _____

Date


3/27, 1911 Scout

Map No. _____ Sec. 13 Twp. 26 R. 4
 Well No. 8 Trubey
Selby Company

NORTH

WEST

EAST

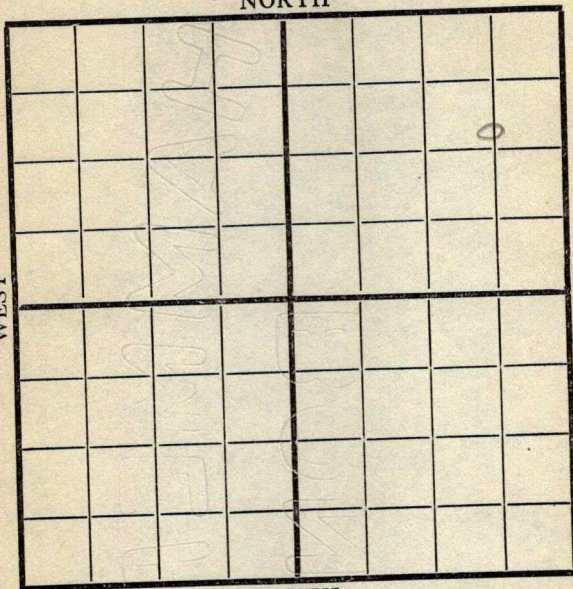

SOUTH

Location _____

Rig up _____

Drilling and Remarks:

RECORD

Cased _____ in., _____ ft.

Sand _____

Gas _____

Oil _____

Total Depth _____

PRODUCTION

1st 24 hrs. Nat. _____

1st 24 hrs. after shot _____

Gas _____ Cu. Ft.

Dry Hole _____

Abandoned _____

Date

4/3

191

P. Candey

Scout

Map No. _____ Sec. 13 Twp. 26 R. 4Well No. 8 Farm _____Silby oil Company _____

NORTH

WEST

EAST

SOUTH

Location _____

Rig Up _____

Drilling and remarks

9.20

RECORD

Cased _____ in. _____ Ft.

Sand _____

Gas _____

Oil _____

Total Depth _____

PRODUCTION

1st 24 hrs. Nat. _____

1st 24 hrs. after shot _____

Gas _____ Cu. Ft.

Dry Hole _____

Abandoned _____


Date

4/10, 1918 S. Condit Scout _____

Map No. _____ Sec. 13 Twp. 26 R. 4
 Well No. S. Mobry Farm _____
Selby Company _____

NORTH

WEST

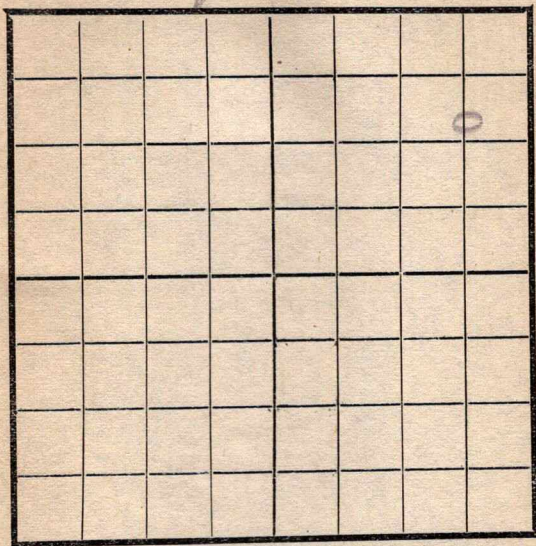

EAST

SOUTH

Location _____
 Rig Up _____
 Drilling and remarks

2200

RECORD

Cased _____ in. _____ Ft.
 Sand _____
 Gas _____
 Oil _____
 Total Depth _____

PRODUCTION

1st 24 hrs. Nat. _____
 1st 24 hrs. after shot _____
 Gas _____ Cu. Ft.
 Dry Hole _____
 Abandoned _____


Date

4/17, 1911 S. Conroy Scout

Map No. K14 Sec. 13 Twp. 26 R. 4Well No. 8 maby FarmSelby Company

NORTH

WEST

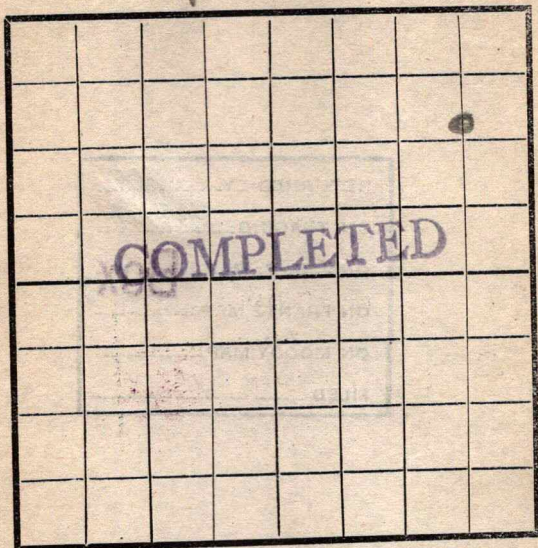

EAST

SOUTH

RECORD

Location -----

Cased ----- in. ----- Ft.

Rig Up -----

Sand 2463-25 1/2

Drilling and remarks -----

Gas -----

Oil -----

Total Depth -----

PRODUCTION

1st 24 hrs. Nat. -----

1st 24 hrs. after shot -----

Gas ----- Cu. Ft.

Dry Hole -----

Abandoned -----

Date

4/24, 1918 Scout