


Map No. 4 Sec. 24 Twp. 26 R. 4
Well No. 4 Harper Clark Farm
May & P. Co. Company

NORTH

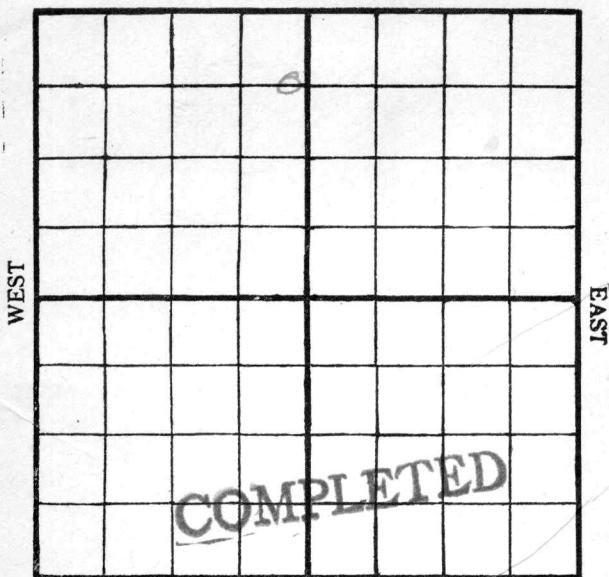

SOUTH

Location -----

Drilling Remarks:

Rig Up -----

Drilling Remarks:

RECORD

Cased ----- in. ----- ft.

Sand -----

Gas -----

Oil -----

Total Depth -----

PRODUCTION

1st 24 hrs. Nat. -----

1st 24 hrs. after shot -----

Gas ----- cu. ft.

Dry Hole -----

Abandoned -----

Map No. K14 Sec. 24 Twp. 26 R. 4Well No. 4 SargentMagnolia Company

Contractor

NORTH

WEST

EAST

SOUTH

Location _____

Rig up ☒

Drilling and Remarks:

FIRST REPORT

RECORD

Cased _____ in., _____ ft.

Sand _____

Gas _____

Oil _____

Total Depth _____

PRODUCTION

1st 24 hrs. Nat. _____

1st 24 hrs. after shot _____

Gas _____ Cu. Ft.

Dry Hole _____

Abandoned _____

Date

6/18 1918 S. C. Condit Scout

Map No. _____ Sec. 24 Twp. 26 R. 4Well No. 4 Sargent_____Wright Company_____Wright Contractor

NORTH

WEST

EAST

SOUTH

Location _____

Rig up ☒

Drilling and Remarks:

RECORD

Cased _____ in., _____ ft.

Sand _____

Gas _____

Oil _____

Total Depth _____

PRODUCTION

1st 24 hrs. Nat. _____

1st 24 hrs. after shot _____

Gas _____ Cu. Ft.

Dry Hole _____

Abandoned _____

Date

6-26 1918 Condiff Scout

Map No. _____ Sec. 24 Twp. 26 R. 4
Well No. 4 Sargent
Magnolia Company
Contractor _____

NORTH							
WEST							
SOUTH							
EAST							

Location _____
Rig up ☒
Drilling and Remarks:

RECORD


Cased _____ in., _____ ft.
Sand _____
Gas _____
Oil _____
Total Depth _____

PRODUCTION

1st 24 hrs. Nat. _____
1st 24 hrs. after shot _____
Gas _____ Cu. Ft.
Dry Hole _____
Abandoned _____

Date 7/3 1911 J. C. Conroy Scout


Map No. _____ Sec. 24 Twp. 26 R. 4
 Well No. 4 Sargent
Sargent Company
 _____ Contractor

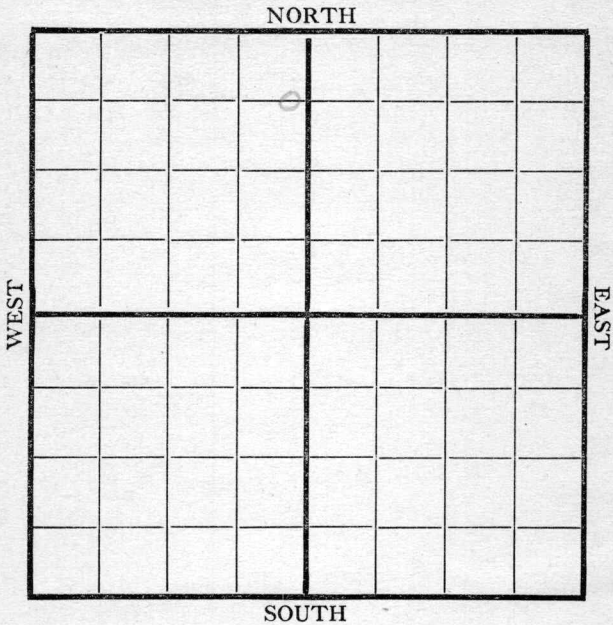

	RECORD
Location _____	Cased _____ in., _____ ft.
Rig up _____	Sand _____
Drilling and Remarks:	Gas _____
	Oil _____
	Total Depth _____
	PRODUCTION
	1st 24 hrs. Nat. _____
	1st 24 hrs. after shot _____
	Gas _____ Cu. Ft.
	Dry Hole _____
	Abandoned _____

Date 7/10 1911 C. C. Sargent Scout

Map No. _____ Sec. 24 Twp. 26 R. 4
Well No. 4 Sargent
Magnolia Company
Contractor _____

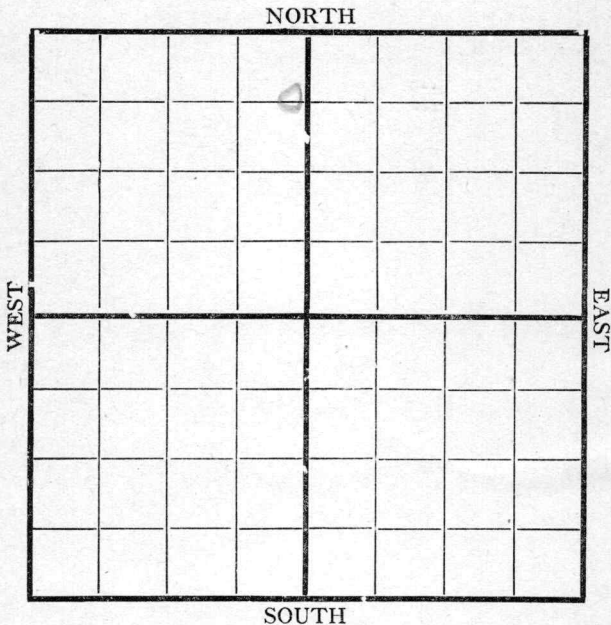

	RECORD
Location _____	Cased _____ in., _____ ft.
Rig up _____	Sand _____
Drilling and Remarks:	Gas _____
	Oil _____
	Total Depth _____
	PRODUCTION
	1st 24 hrs. Nat. _____
	1st 24 hrs. after shot _____
	Gas _____ Cu. Ft.
	Dry Hole _____
	Abandoned _____

Date 7/17 1918 Candry Scout

Map No. _____ Sec. 24 Twp. 26 R. 4Well No. 4 _____

_____ Company

_____ Contractor

NORTH

WEST

EAST

SOUTH

Location _____

Rig up _____

Drilling and Remarks:

RECORD

Cased _____ in., _____ ft.

Sand _____

Gas _____

Oil _____

Total Depth _____

PRODUCTION

1st 24 hrs. Nat. _____

1st 24 hrs. after shot _____

Gas _____ Cu. Ft.

Dry Hole _____

Abandoned _____

Date

7/24 1918 Cordiff Scout

Map No. 814 Sec. 24 Twp. 26 R. 4Well No. 4 Dargent ClarkMagnolia Petroleum Company

Contractor

NORTH

WEST

EAST

CHANGE FEE NAME

SOUTH

Location _____

Rig up _____

Drilling and Remarks:

Change from
Dargent to
Clark

RECORD

Cased _____ in., _____ ft.

Sand _____

Gas _____

Oil _____

Total Depth _____

PRODUCTION

1st 24 hrs. Nat. _____

1st 24 hrs. after shot _____

Gas _____ Cu. Ft.

Dry Hole _____

Abandoned _____

Date

7/31

191

J. Condy

Scout


Map No. _____ Sec. 24 Twp. 26 R. 4Well No. 4 ClarkMagnolia Petroleum Company

Contractor _____

NORTH

WEST

EAST

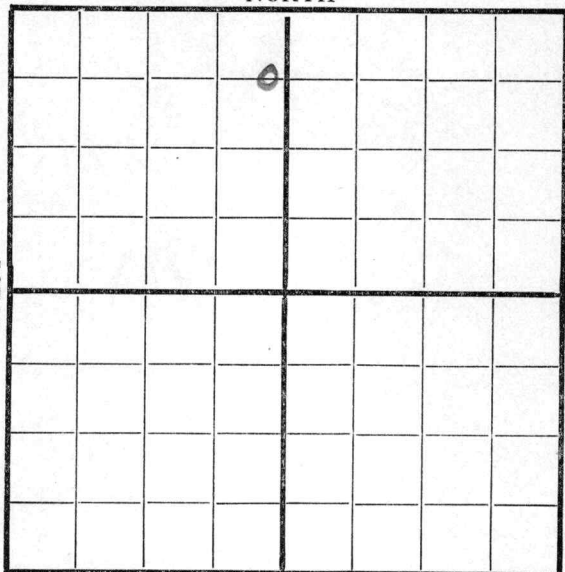

SOUTH

200 W 7 E L x 660 S 7 N L

Location _____

Rig up _____

Drilling and Remarks:

750

RECORD

Cased _____ in., _____ ft.

Sand _____

Gas _____

Oil _____

Total Depth _____

PRODUCTION

1st 24 hrs. Nat. _____

1st 24 hrs. after shot _____

Gas _____ Cu. Ft.

Dry Hole _____

Abandoned _____

Date

7/31

191

J. Candy

Scout

SOUTH

Scout

Map No. _____ Sec. 24 Twp. 26 R. 4Well No. 4 Clark


_____ Company

_____ Contractor

NORTH

WEST

EAST

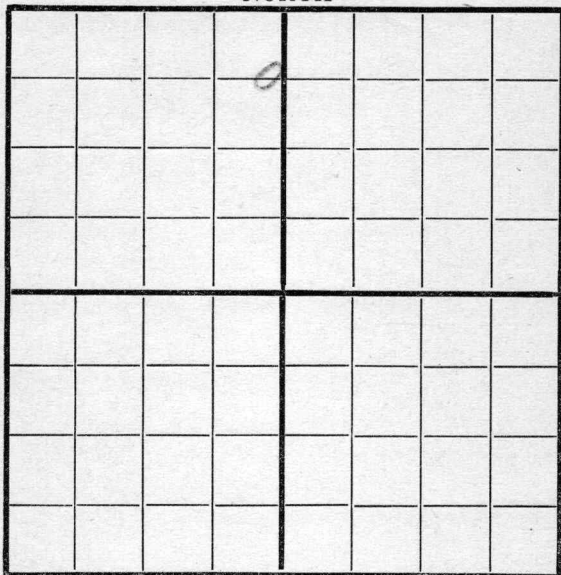

SOUTH

Location 2008

Rig up _____

Drilling and Remarks:

10" @ 1100'

RECORD

Cased _____ in., _____ ft.

Sand _____

Gas _____

Oil _____

Total Depth _____

PRODUCTION

1st 24 hrs. Nat. _____

1st 24 hrs. after shot _____

Gas _____ Cu. Ft.

Dry Hole _____

Abandoned _____

Date


8/15 1918 Pyle Scout

Map No. _____ Sec. 24 Twp. 26 R. 4Well No. 4 ClintonMagnolia Petroleum Company_____
Contractor

NORTH

WEST

EAST

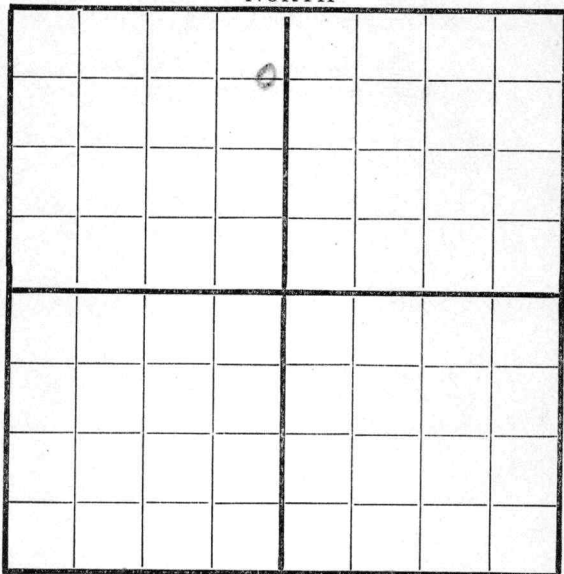

SOUTH

Location _____

Rig up _____

Drilling and Remarks:

1300'

RECORD

Cased _____ in., _____ ft.

Sand _____

Gas _____

Oil _____

Total Depth _____

PRODUCTION

1st 24 hrs. Nat. _____

1st 24 hrs. after shot _____

Gas _____ Cu. Ft.

Dry Hole _____

Abandoned _____

Date

8/221918Pyle

Scout


Map No. 1514 Sec. 24 Twp. 26 R. 4Well No. 41 @ Clark

_____ Company

_____ Contractor

NORTH

WEST

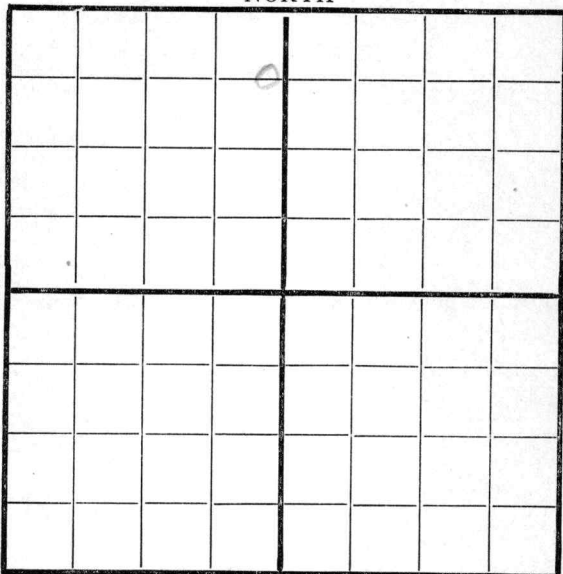

EAST

SOUTH

RECORD

Location _____

Cased _____ in., _____ ft.

Rig up _____

Sand _____

Drilling and Remarks:

Gas _____

Oil _____

Total Depth _____

PRODUCTION

1st 24 hrs. Nat. _____

1st 24 hrs. after shot _____

Gas _____ Cu. Ft.

Dry Hole _____

Abandoned _____

Date

8/38 191 8 Clark Scout

Map No. 1514 Sec. 24 Twp. 26 R. 4Well No. 41 ClarkMagnolia Company

Contractor

NORTH

WEST

EAST

SOUTH

Location _____

Rig up _____

Drilling and Remarks:

7340

RECORD

Cased _____ in., _____ ft.

Sand _____

Gas _____

Oil _____

Total Depth _____

PRODUCTION

1st 24 hrs. Nat. _____

1st 24 hrs. after shot _____

Gas _____ Cu. Ft.

Dry Hole _____

Abandoned _____

Date


9/4

191

J. C. Caudy

Scout

Map No. 1514 Sec. 24 Twp. 25 R. 4
 Well No. 4015
Magnolia Company
 Contractor

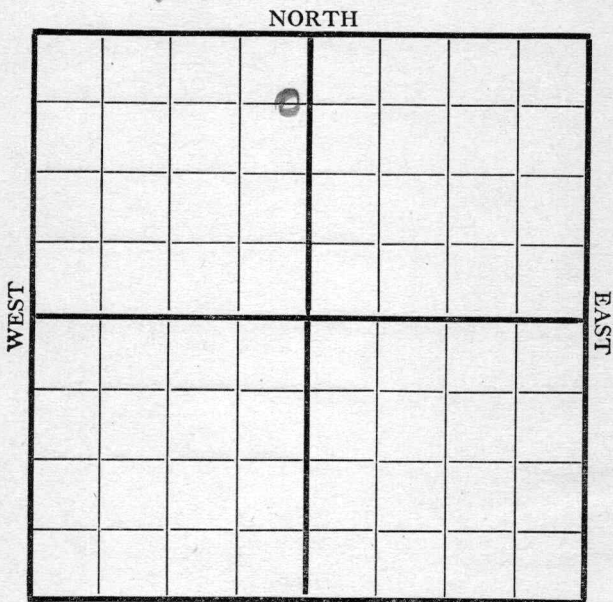

Location _____

Rig up _____

Drilling and Remarks:

2520

RECORD

Cased _____ in., _____ ft.

Sand _____

Gas _____

Oil _____

Total Depth _____

PRODUCTION

1st 24 hrs. Nat. _____

1st 24 hrs. after shot _____

Gas _____ Cu. Ft.

Dry Hole _____

Abandoned _____

Date

9/11 28 8 County 191 Scout


Map No. 1514 Sec. 24 Twp. 26 R. 4Well No. 4 C. 15Company Drummond

Contractor _____

NORTH

WEST

EAST

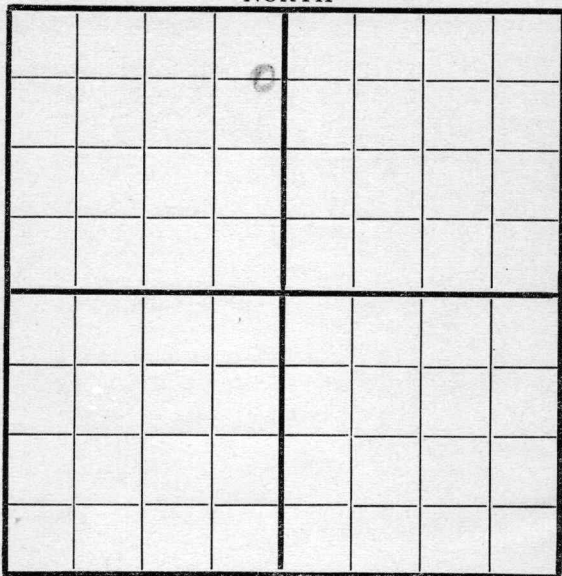

SOUTH

660 N-300 E

Location _____

Rig up _____

Drilling and Remarks:

W R
25m

RECORD

Cased _____ in., _____ ft.

Sand _____

Gas _____

Oil _____

Total Depth _____

PRODUCTION

1st 24 hrs. Nat. _____

1st 24 hrs. after shot _____

Gas _____ Cu. Ft.

Dry Hole _____

Abandoned _____

Date


9/18 1918 C. 15 Scout

Map No. 1514 Sec. 34 Twp. 26 R. 4Well No. 4 Clark
Magnolia Company
Contractor

NORTH

WEST

EAST

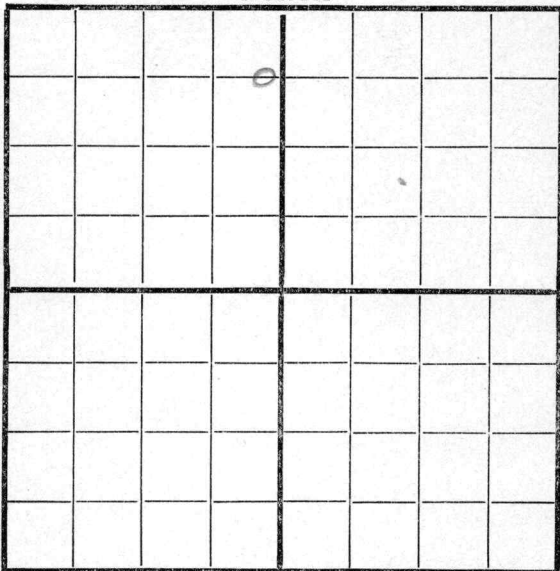

SOUTH

6608500

Location _____

Rig up _____

Drilling and Remarks:

Top sand
26.17

RECORD

Cased _____ in., _____ ft.

Sand _____

Gas _____

Oil _____

Total Depth _____

PRODUCTION

1st 24 hrs. Nat. _____

1st 24 hrs. after shot _____

Gas _____ Cu. Ft.

Dry Hole _____

Abandoned _____

Date

9/23 191 8 Candy Scout

Map No. 1514 Sec. 24 Twp. 26 R. 4Well No. 4 ClarkCompany MarysvilleContractor Company Tools

NORTH

WEST

EAST

COMPLETED

SOUTH

Location _____

Rig up _____

Drilling and Remarks:

Top sand
2617
Dry & abandoned
2660

RECORD

Cased _____ in., _____ ft.

Sand _____

Gas _____

Oil _____

Total Depth _____

PRODUCTION

1st 24 hrs. Nat. _____

1st 24 hrs. after shot _____

Gas _____ Cu. Ft.

Dry Hole _____

Abandoned _____

Date

10/1 1918 Curly Scout

Butler
 K14 KANSAS MAP NO. 24 SEC. 76S TWP. 4E
 WELL NO. Clark
Magnolia COMPANY
 CONTRACTOR

ABANDONED

SECTION PLAT

	●		

_____ FT. FROM N. LINE
 _____ FT. FROM S. LINE
 _____ FT. FROM E. LINE
 _____ FT. FROM W. LINE

LOCATION _____
 RIG UP _____
 DRILLING AND REMARKS:

RECORD

CASED _____ IN. _____ FT.
 SAND _____
 GAS _____
 OIL _____
 TOTAL DEPTH 7634

PRODUCTION

1ST 24 HRS. NAT. _____
 1ST 24 HRS. AFTER SHOT _____
 GAS _____ CU. FT.
 DRY HOLE ✓
 ABANDONED ✓

DATE

10/9 1928 SCOUT