


Map No. _____ Sec. 13 Twp. 26 R. 4Well No. 9 Mary Farm _____Selby Company _____

NORTH

WEST

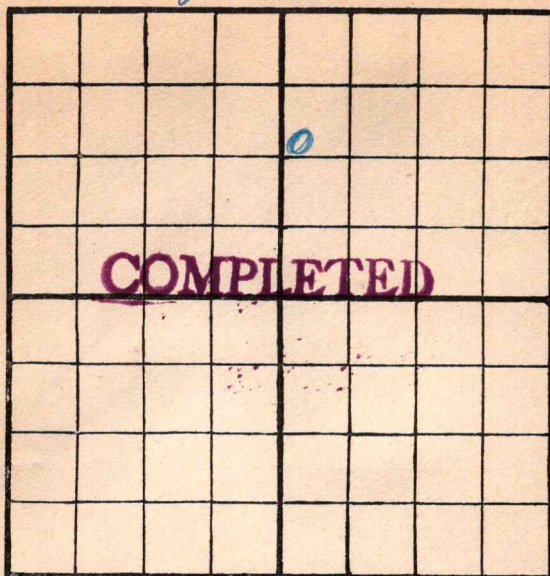

EAST

SOUTH

Location _____

Rig Up _____

Drilling Remarks:

Drilling Remarks:

RECORD

Cased _____ in. _____ ft.

Sand _____

Gas _____

Oil _____

Total Depth _____

PRODUCTION

1st 24 hrs. Nat. _____

1st 24 hrs. after shot _____

Gas _____ cu. ft.

Dry Hole _____

Abandoned _____

Map No. K14 Sec. 13 Twp. 26 R. 4Well No. 920000 FarmSeely Company

NORTH

WEST

EAST

SOUTH

Location -----

Rig Up -----

Drilling and remarks

600

RECORD

Cased ----- in. ----- Ft.

Sand -----

Gas -----

Oil -----

Total Depth -----

PRODUCTION

1st 24 hrs. Nat. -----

1st 24 hrs. after shot -----

Gas ----- Cu. Ft.

Dry Hole -----

Abandoned -----

Date


7/20/8 191 Seely Scout

Map No. 114 Sec. 13 Twp. 26 R. 4
 Well No. 9 Farm _____
Selby Company _____

NORTH

WEST

EAST

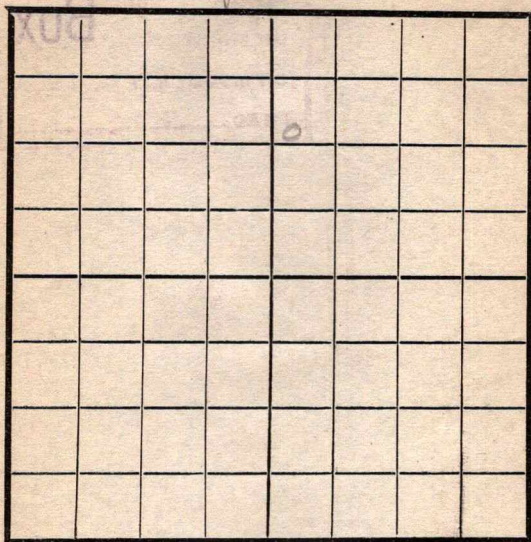

SOUTH

Location _____
 Rig Up _____
 Drilling and remarks _____

RECORD

Cased _____ in. _____ Ft.
 Sand _____
 Gas _____
 Oil _____
 Total Depth _____

PRODUCTION

1st 24 hrs. Nat. _____
 1st 24 hrs. after shot _____
 Gas _____ Cu. Ft.
 Dry Hole _____
 Abandoned _____


Date

2/27, 1918 C. Selby Scout

Map No. 114 Sec. 13 Twp. 26 R. 4Well No. 9 McAvery Farm
Delby Company

NORTH

WEST

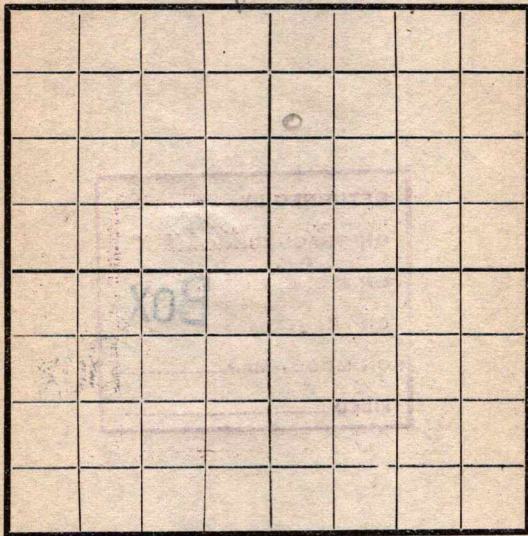

EAST

SOUTH

Location -----

Rig Up -----

Drilling and remarks

RECORD

Cased ----- in. ----- Ft.

Sand -----

Gas -----

Oil -----

Total Depth -----

PRODUCTION

1st 24 hrs. Nat. -----

1st 24 hrs. after shot -----

Gas ----- Cu. Ft.

Dry Hole -----

Abandoned -----


Date

3/6, 1918 Scout

Map No. 174 Sec. 13 Twp. 26 R. 4
 Well No. 9 Mabry Farm
Delby Company

NORTH

WEST

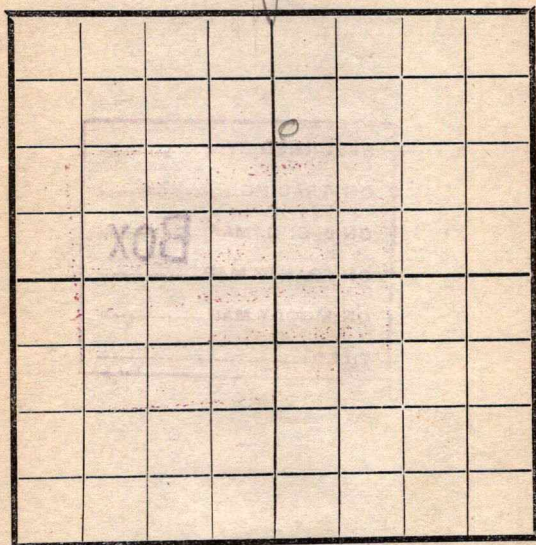

EAST

SOUTH

Location -----
 Rig Up -----
 Drilling and remarks -----

RECORD

Cased ----- in. ----- Ft.
 Sand -----
 Gas -----
 Oil -----
 Total Depth -----

PRODUCTION

1st 24 hrs. Nat. -----
 1st 24 hrs. after shot -----
 Gas ----- Cu. Ft.
 Dry Hole -----
 Abandoned -----


Date

3/13, 1918 J. Condy Scout

Map No. 174 Sec. 13 Twp. 26 R. 4Well No. 9 Mabry FarmSelby Oil Company

NORTH

WEST

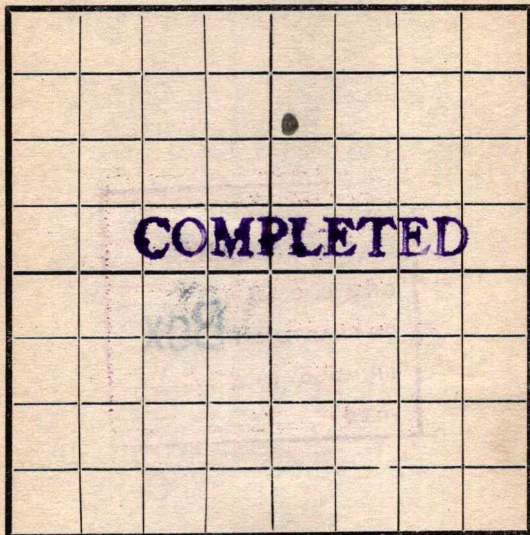

EAST

SOUTH

Location -----

Rig Up -----

Drilling and remarks

Estimated
at 150
Bbls

RECORD

Cased ----- in. ----- Ft.

Sand 2505-2555

Gas -----

Oil -----

Total Depth -----

PRODUCTION

1st 24 hrs. Nat. -----

1st 24 hrs. after shot -----

Gas ----- Cu. Ft.

Dry Hole -----

Abandoned -----

Date

3/20, 1918 Cordiff Scout