


Map No. _____ Sec. 13 Twp. 26 R. 4
 Well No. 4 Tague Farm _____
Empire Company _____

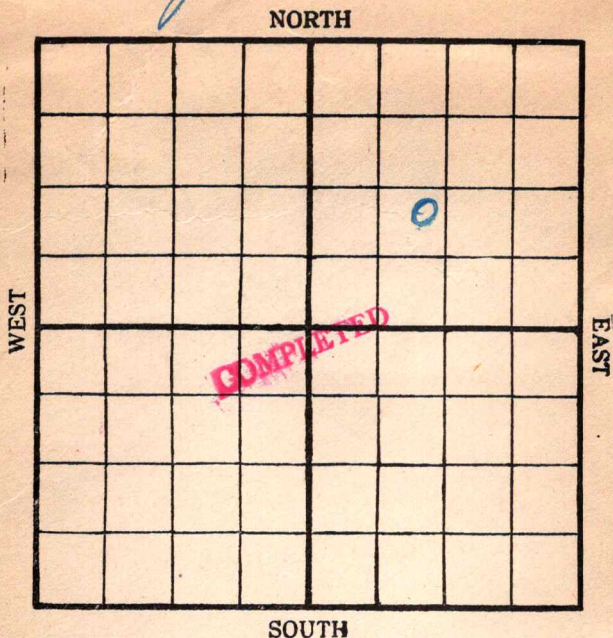

Location _____

Rig Up _____

Drilling Remarks:

Drilling Remarks:

RECORD

PRODUCTION

Cased _____ in. _____ ft.

1st 24 hrs. Nat. _____

Sand _____

1st 24 hrs. after shot _____

Gas _____

Gas _____ cu. ft.

Oil _____

Dry Hole _____


Total Depth _____

Abandoned _____

Map No. K74 Sec. 13 Twp. 26 R. 4Well No. 4 Tague Farm
Engine Company

NORTH

WEST

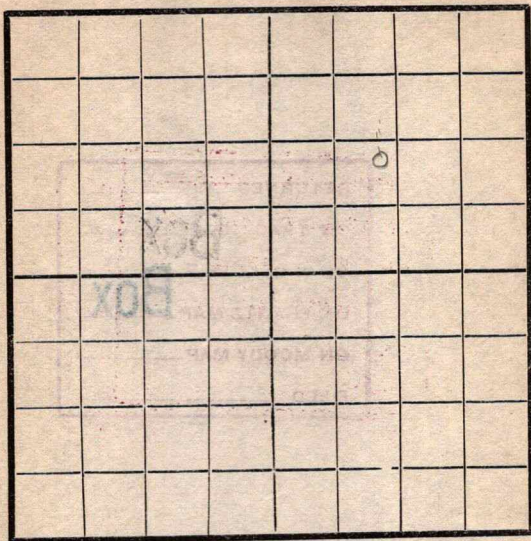

EAST

SOUTH

Location ✓Rig Up ✓

Drilling and remarks

FIRST REPORT**RECORD**

Cased _____ in. _____ Ft.

Sand _____

Gas _____

Oil _____

Total Depth _____

PRODUCTION

1st 24 hrs. Nat. _____

1st 24 hrs. after shot _____

Gas _____ Cu. Ft.

Dry Hole _____

Abandoned _____

Date

3/13, 1918 Candey Scout

Map No. _____ Sec. 13 Twp. 26 R. 4Well No. 4 Taylor Farm __________Cummins Company

NORTH

WEST

EAST

SOUTH

Location _____

Rig Up _____

Drilling and remarks

Rigging up
McJunkins &
Lamar
E. P. Dnadoski

RECORD

Cased _____ in. _____ Ft.

Sand _____

Gas _____

Oil _____

Total Depth _____

PRODUCTION

1st 24 hrs. Nat. _____

1st 24 hrs. after shot _____

Gas _____ Cu. Ft.

Dry Hole _____

Abandoned _____

Date

4/17, 1918 C. Corbett Scout

Map No. _____ Sec. 13 Twp. 26. R. 4Well No. 4 Tague Farm __________
Company _____

NORTH

WEST

EAST

SOUTH

Location _____

Rig Up _____

Drilling and remarks

300

RECORD

Cased _____ in. _____ Ft.

Sand _____

Gas _____

Oil _____

Total Depth _____

PRODUCTION

1st 24 hrs. Nat. _____

1st 24 hrs. after shot _____

Gas _____ Cu. Ft.

Dry Hole _____

Abandoned _____

Date


4/24, 1918 Scout

Map No. _____ Sec. 13 Twp. 26 R. 4Well No. 4 _____ Farm _____

_____ Company _____

NORTH

WEST

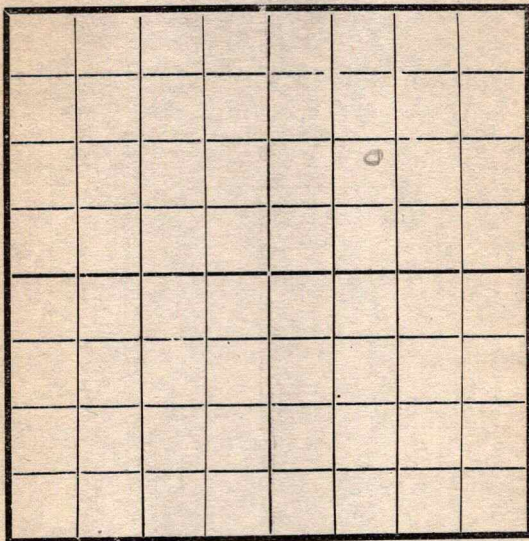

EAST

SOUTH

Location _____

Rig Up _____

Drilling and remarks

670

RECORD

Cased _____ in. _____ F

Sand _____

Gas _____

Oil _____

Total Depth _____

PRODUCTION

1st 24 hrs. Nat. _____

1st 24 hrs. after shot _____

Gas _____ Cu. F

Dry Hole _____

Abandoned _____


Date

5/1, 1918 J. Cardy Scout

Map No. _____ Sec. 13 Twp. 26 R. 4
 Well No. 4 Taguel Farm _____
Empire Company _____

NORTH

WEST

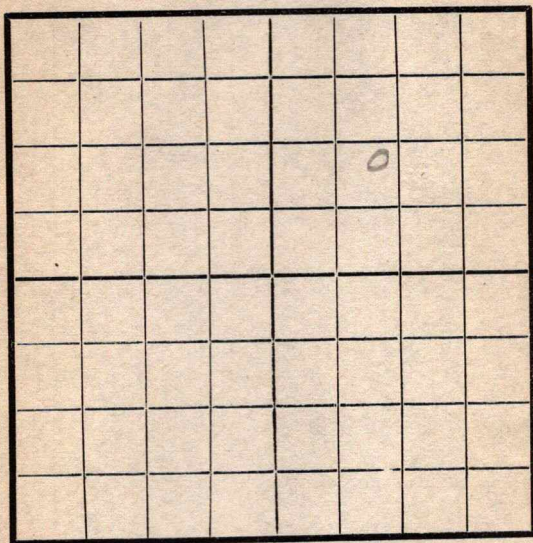

EAST

SOUTH

Location _____

Rig Up _____

Drilling and remarks

910

RECORD

Cased _____ in. _____ Ft.

Sand _____

Gas _____

Oil _____

Total Depth _____

PRODUCTION

1st 24 hrs. Nat. _____

1st 24 hrs. after shot _____

Gas _____ Cu. Ft.

Dry Hole _____

Abandoned _____


Date

5/8, 1918 S. Condit Scout _____

Map No. _____ Sec. 13 Twp. 26 R. 4Well No. 4 Toym Farm _____
Engineering Company _____

NORTH

WEST

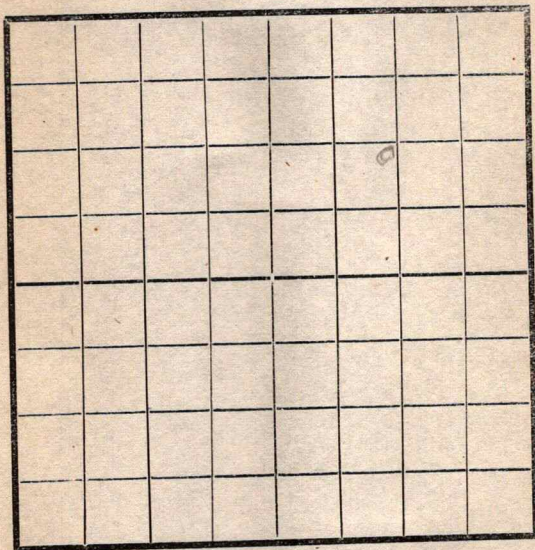

EAST

SOUTH

Location _____

Rig Up _____

Drilling and remarks

1025

RECORD

Cased _____ in. _____ Ft.

Sand _____

Gas _____

Oil _____

Total Depth _____

PRODUCTION

1st 24 hrs. Nat. _____

1st 24 hrs. after shot _____

Gas _____ Cu. Ft.

Dry Hole _____


Abandoned _____

Date

5/15, 1918 C. Conley Scout _____

Map No. _____ Sec. 13 Twp. 26 R. 4
Well No. 49092 _____ Farm _____
_____ Company _____

NORTH

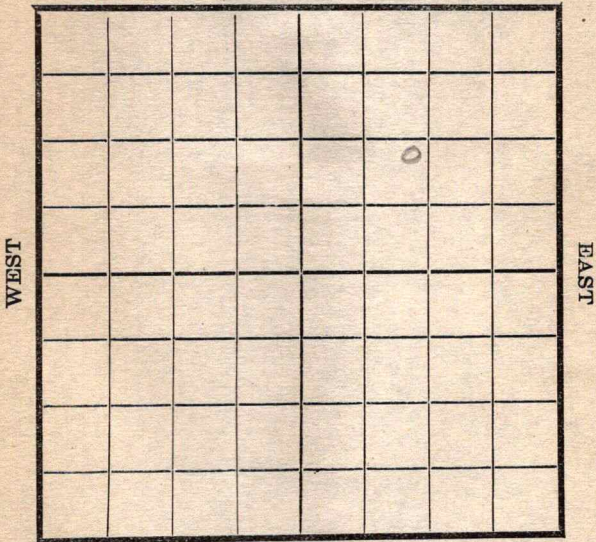

SOUTH

	RECORD
Location _____	Cased _____ in. _____ Ft.
Rig Up _____	Sand _____
Drilling and remarks	Gas _____
<u>1480</u>	Oil _____
	Total Depth _____
	PRODUCTION
	1st 24 hrs. Nat. _____
	1st 24 hrs. after shot _____
	Gas _____ Cu. Ft.
	Dry Hole _____
	Abandoned _____

Date 5/22/1918 _____ Scout Cand...

Map No. _____ Sec. 13 Twp. 26 R. 4Well No. 190 Farm __________
Company _____

NORTH

WEST

EAST

SOUTH

Location _____

Rig Up _____

Drilling and remarks

1685

RECORD

Cased _____ in. _____ Ft.

Sand _____

Gas _____

Oil _____

Total Depth _____

PRODUCTION

1st 24 hrs. Nat. _____

1st 24 hrs. after shot _____

Gas _____ Cu. Ft.

Dry Hole _____

Abandoned _____

Date

5/29, 1918 Scout

Map No. _____ Sec. 13 Twp. 26 R. 4Well No. 4709 Farm _____

_____ Company

NORTH

WEST

EAST

SOUTH

Location _____

Rig Up _____

Drilling and remarks

28 1685

RECORD

Cased _____ in. _____ Ft.

Sand _____

Gas _____

Oil _____

Total Depth _____

PRODUCTION

1st 24 hrs. Nat. _____

1st 24 hrs. after shot _____

Gas _____ Cu. Ft.

Dry Hole _____

Abandoned _____

Date


6/5, 1918C. C. Cuddy Scout

Map No. _____ Sec. 13 Twp. 26 R. 4
Well No. 47ague
Engine _____ Company _____
Contractor _____

NORTH

WEST

EAST

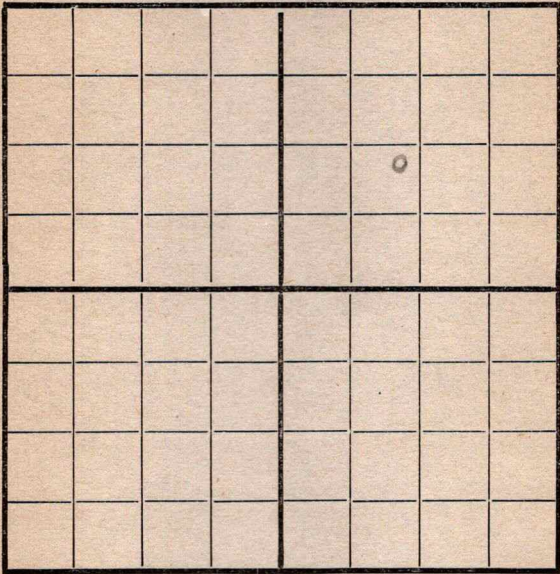

SOUTH

	RECORD
Location _____	Cased _____ in., _____ ft.
Rig up _____	Sand _____
Drilling and Remarks: <u>22 1685</u>	Gas _____
	Oil _____
	Total Depth _____
	PRODUCTION
	1st 24 hrs. Nat. _____
	1st 24 hrs. after shot _____
	Gas _____ Cu. Ft.
	Dry Hole _____
	Abandoned _____

Date 6/19 1918 O. Condy Scout

Map No. _____ Sec. 13 Twp. 26 R. 4Well No. 49 aguel Farm _____E. M. B. B. B. Company _____

NORTH

WEST

EAST

SOUTH

Location _____

Rig Up _____

Drilling and remarks

AD 1685

RECORD

Cased _____ in. _____ Ft.

Sand _____

Gas _____

Oil _____

Total Depth _____

PRODUCTION

1st 24 hrs. Nat. _____

1st 24 hrs. after shot _____

Gas _____ Cu. Ft.

Dry Hole _____

Abandoned _____

Date

6/19, 1918 Conley Scout _____

Map No. _____ Sec. 13 Twp. 26 R. 4Well No. 49ague
Engine _____ Company _____
_____ Contractor _____

NORTH

WEST

EAST

SOUTH

Location _____

Rig up _____

Drilling and Remarks:

Shut Down
1685

RECORD

Cased _____ in., _____ ft.

Sand _____

Gas _____

Oil _____

Total Depth _____

PRODUCTION

1st 24 hrs. Nat. _____

1st 24 hrs. after shot _____

Gas _____ Cu. Ft.

Dry Hole _____

Abandoned _____

Date

6/26 1918 Conley Scout

Map No. _____ Sec. 13 Twp. 26 R. 4Well No. 49 _____

Company _____

Contractor _____

NORTH

WEST

EAST

SOUTH

Location _____

Rig up _____

Drilling and Remarks:

RECORD

Cased _____ in., _____ ft.

Sand _____

Gas _____

Oil _____

Total Depth _____

PRODUCTION

1st 24 hrs. Nat. _____

1st 24 hrs. after shot _____

Gas _____ Cu. Ft.

Dry Hole _____

Abandoned _____

Date

191

Scout

Map No. _____ Sec. 13 Twp. 26 R. 4
 Well No. 4 Taggart
 _____ Company
 _____ Contractor

NORTH

WEST

EAST

SOUTH

Location _____

Rig up _____

Drilling and Remarks:

Fishing
1685-

RECORD

Cased _____ in., _____ ft.

Sand _____

Gas _____

Oil _____

Total Depth _____

PRODUCTION

1st 24 hrs. Nat. _____

1st 24 hrs. after shot _____

Gas _____ Cu. Ft.

Dry Hole _____

Abandoned _____

Date

191


Scout

Map No. _____ Sec. 13 Twp. 26 R. 4Well No. 49 Aguel

_____ Company

_____ Contractor

NORTH

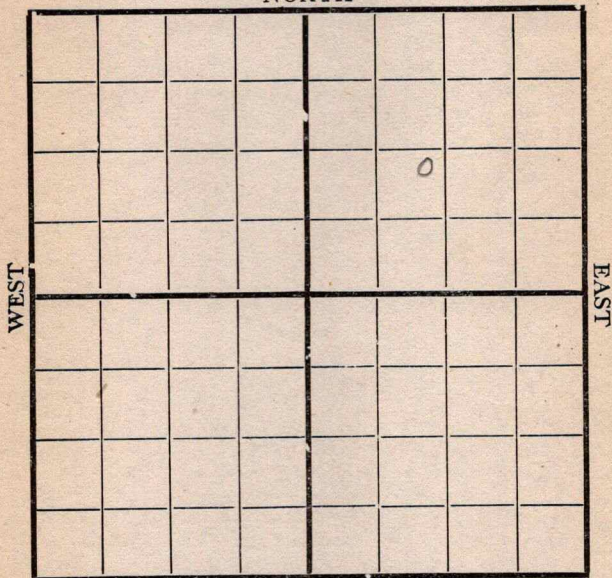

SOUTH

Location _____

Rig up _____

Drilling and Remarks:

Isle
1685

RECORD

Cased _____ in., _____ ft.

Sand _____

Gas _____

Oil _____

Total Depth _____

PRODUCTION

1st 24 hrs. Nat. _____

1st 24 hrs. after shot _____

Gas _____ Cu. Ft.

Dry Hole _____

Abandoned _____

Date

7/12 1918 Scout

Map No. _____ Sec. 13 Twp. 26 R. 4Well No. 49 _____

Company _____

Contractor _____

NORTH

WEST

EAST

SOUTH

Location _____

Rig up _____

Drilling and Remarks:

Fishing
1685

RECORD

Cased _____ in., _____ ft.

Sand _____

Gas _____

Oil _____

Total Depth _____

PRODUCTION

1st 24 hrs. Nat. _____

1st 24 hrs. after shot _____

Gas _____ Cu. Ft.

Dry Hole _____

Abandoned _____

Date

7/24


191

J. Cordery

Scout

Map No. _____ Sec. 13 Twp. 26 R. 4Well No. 4 Tague
Empire _____ Company
_____ Contractor

NORTH

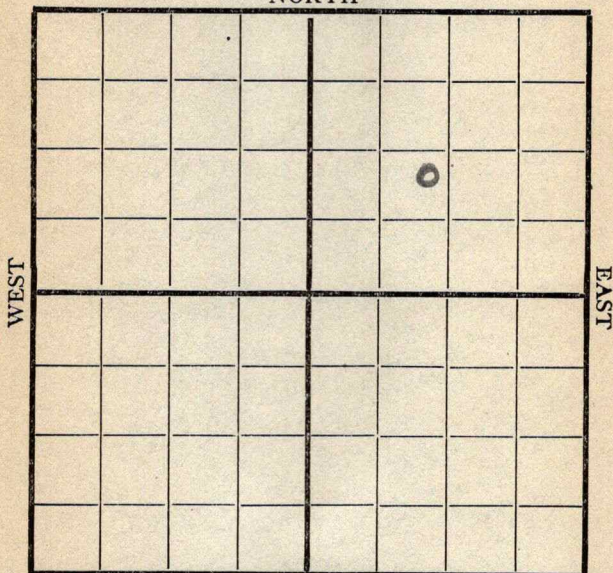

SOUTH

~~1520 S 7 1/2 x 1520 W 7 1/2 line~~

RECORD

Location _____

Cased _____ in., _____ ft.

Rig up _____

Sand _____

Drilling and Remarks:

Gas _____

Oil _____

Total Depth _____

PRODUCTION

1st 24 hrs. Nat. _____

1st 24 hrs. after shot _____

Gas _____ Cu. Ft.

Dry Hole _____

Abandoned _____

Date

7/31 1918 J. Condy Scout

Map No. _____ Sec. 13 Twp. 26 R. 4Well No. 49 Aggie


Company _____

Contractor _____

NORTH

WEST

EAST

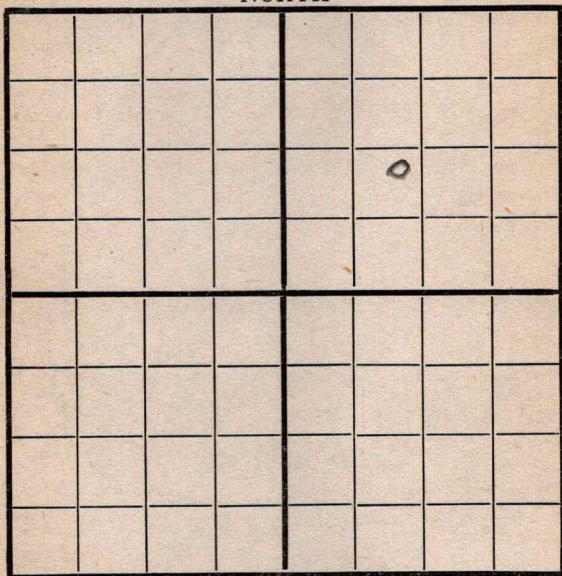

SOUTH

Location _____

Rig up _____

Drilling and Remarks:

Fishing
1685

RECORD

Cased _____ in., _____ ft.

Sand _____

Gas _____

Oil _____

Total Depth _____

PRODUCTION

1st 24 hrs. Nat. _____

1st 24 hrs. after shot _____

Gas _____ Cu. Ft.

Dry Hole _____

Abandoned _____

Date

8/7

191

J. C. Cuddy

Scout _____

Map No. _____ Sec. 13 Twp. 26 R. 4Well No. 492


Company _____

Contractor _____

NORTH

WEST

EAST

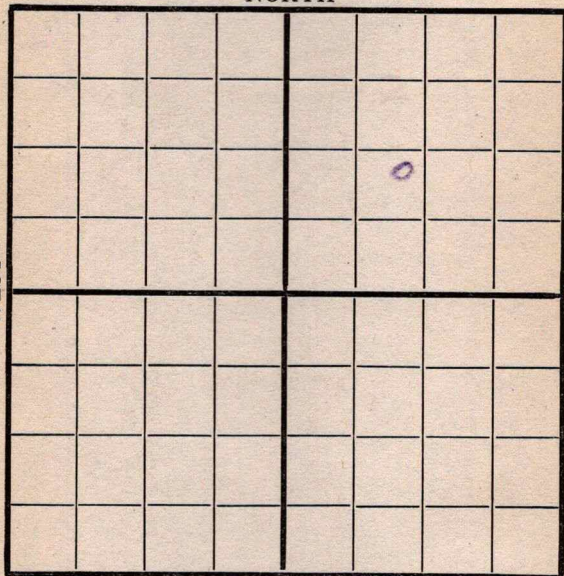

SOUTH

Location 1120 W

Rig up _____

Drilling and Remarks:

fishing
@
1685'

RECORD

Cased _____ in., _____ f

Sand _____

Gas _____

Oil _____

Total Depth _____

PRODUCTION

1st 24 hrs. Nat. _____

1st 24 hrs. after shot _____

Gas _____ Cu. F

Dry Hole _____

Abandoned _____

Date

8/5/18
191


Cyle
 Scout

Map No. _____ Sec. 13 Twp. 26 R. 4Well No. 4 Tagman_____E. Tagman Company__________ Contractor

NORTH

WEST

EAST

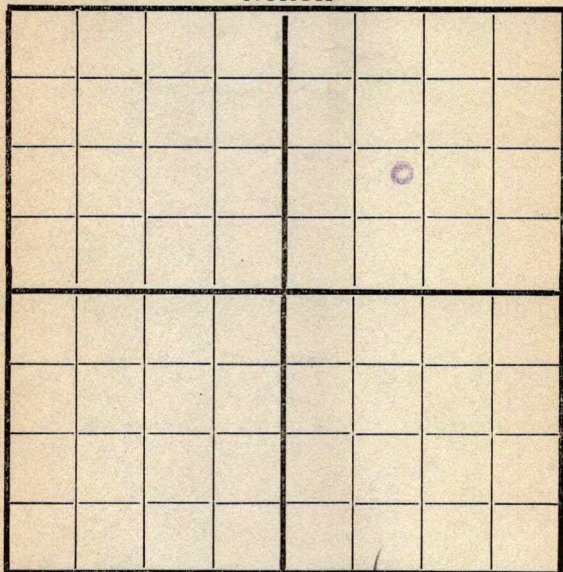

SOUTH

1120' D. - RW

Location _____

Rig up _____

Drilling and Remarks:

fish @
1685'

RECORD

Cased _____ in., _____ ft.

Sand _____

Gas _____

Oil _____

Total Depth _____

PRODUCTION

1st 24 hrs. Nat. _____

1st 24 hrs. after shot _____

Gas _____ Cu. Ft.

Dry Hole _____

Abandoned _____

Date

8/22
1918

Pyle

Scout

Map No. 14 Sec. 13 Twp. 26 R. 4

Well No. 4 Tague




NORTH

WEST

EAST

SOUTH

Location _____

Rig up-----

Drilling and Remarks:

Fishing
1685

1685-

RECORD

Cased_____in., _____f

Sand_____

Gas -----

Oil _____

Total Depth_____

PRODUCTION

1st 24 hrs. Nat. _____

1st 24 hrs. after shot-----

Gas_____Cu. F

Dry Hole.....

Abandoned.....

Date _____

8/28

191


Scot

Map No. 1514 Sec. 13 Twp. 25 R. 4Well No. 4 Tague
Engine Company _____ Contractor _____

NORTH

WEST

EAST

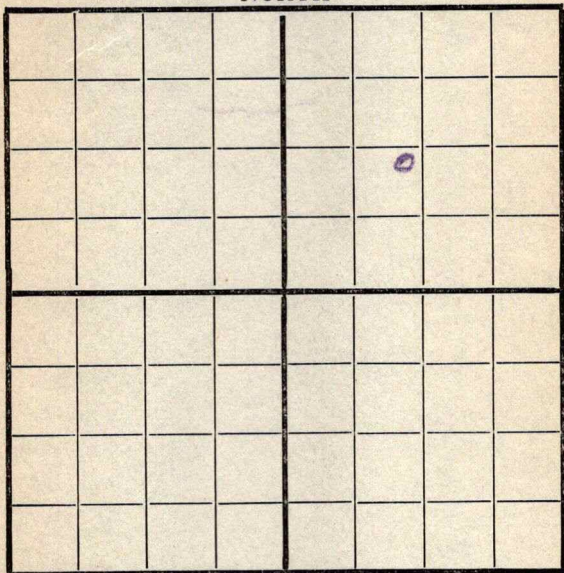

SOUTH

1120 542

RECORD

Location _____

Cased _____ in., _____ ft

Rig up _____

Sand _____

Drilling and Remarks:

Gas _____

Oil _____

Total Depth _____

PRODUCTION

1st 24 hrs. Nat. _____

1st 24 hrs. after shot _____

Gas _____ Cu. Ft

Dry Hole _____

Abandoned _____

Date

9/4

191

Scout


Map No. K14 Sec. 13 Twp. 26 R. 4

Well No. 4909
Engine Company
 Contractor

NORTH

WEST

EAST

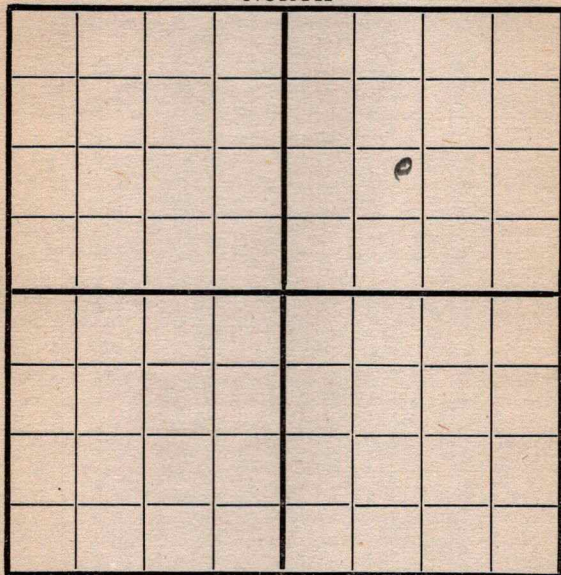

11208-W SOUTH

Location _____

Rig up _____

Drilling and Remarks:

Fishing
1683

RECORD

Cased _____ in., _____ ft.

Sand _____

Gas _____

Oil _____

Total Depth _____

PRODUCTION

1st 24 hrs. Nat. _____

1st 24 hrs. after shot _____

Gas _____ Cu. Ft.

Dry Hole _____

Abandoned _____

Date

2/11 1918 S. Conley Scout

Map No. K14 Sec. 13 Twp. 26 R. 4Well No. 4 Engine


Company

Contractor

NORTH

WEST

EAST

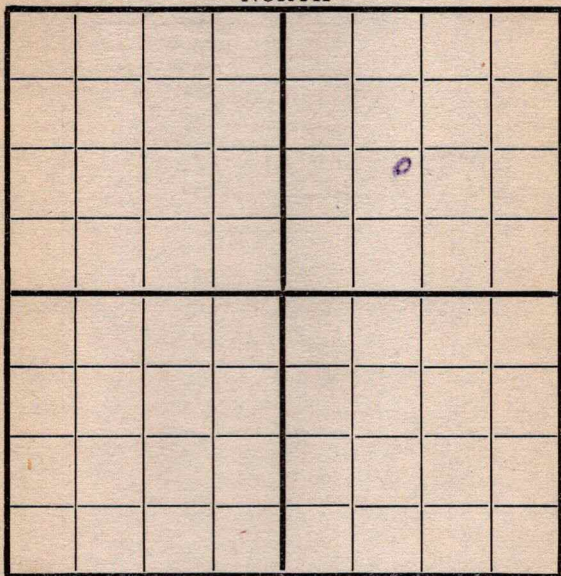

SOUTH

Location

Rig up

Drilling and Remarks:

Fishing
1685

RECORD

Cased _____ in., _____ ft.

Sand _____

Gas _____

Oil _____

Total Depth _____

PRODUCTION

1st 24 hrs. Nat. _____

1st 24 hrs. after shot _____

Gas _____ Cu. Ft.

Dry Hole _____

Abandoned _____

Date

9/18

191

8 *Conding* Scout

Map No. 1514 Sec. 13 Twp. 26 R. 4Well No. 4999


Company

Contractor

NORTH

WEST

EAST

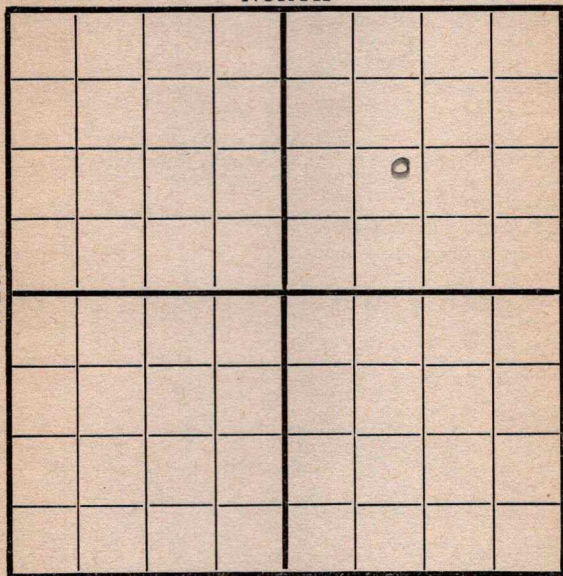

SOUTH

Location

Rig up

Drilling and Remarks:

Fishing
1685

RECORD

Cased _____ in., _____ ft.

Sand _____

Gas _____

Oil _____

Total Depth _____

PRODUCTION

1st 24 hrs. Nat. _____

1st 24 hrs. after shot _____

Gas _____ Cu. Ft.

Dry Hole _____

Abandoned _____

Date

9/25 *1918* *C. Condy* Scout

Map No. 1514 Sec. 13 Twp. 26 R. 4Well No. 4 Payne
Company _____ Contractor _____

NORTH

WEST

EAST

SOUTH

Location _____

Rig up _____

Drilling and Remarks:

Fishing
1685

RECORD

Cased _____ in., _____ ft.

Sand _____

Gas _____

Oil _____

Total Depth _____

PRODUCTION

1st 24 hrs. Nat. _____

1st 24 hrs. after shot _____

Gas _____ Cu. Ft.

Dry Hole _____

Abandoned _____


Date

10/2 191 P. B. B. B. Scout

Map No. K14 Sec. 13 Twp. 26 R. 4Well No. 4 TagueEngine Company

Contractor

NORTH

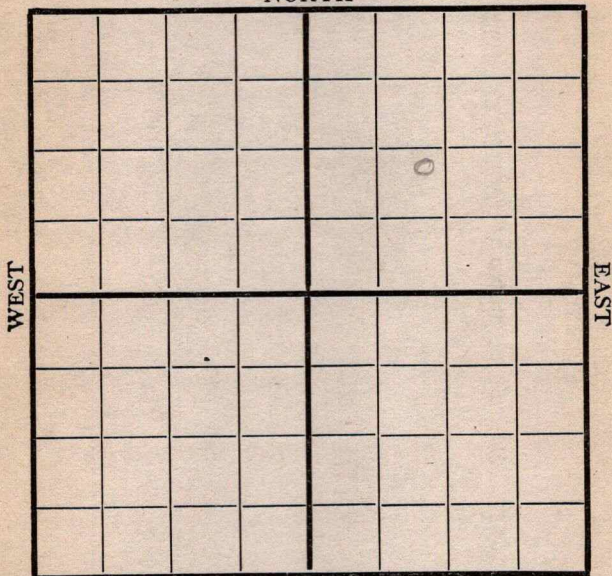

SOUTH

Location -----

Rig up -----

Drilling and Remarks:

RECORD

Cased ----- in., ----- ft.

Sand -----

Gas -----

Oil -----

Total Depth -----

PRODUCTION

1st 24 hrs. Nat. -----

1st 24 hrs. after shot -----

Gas ----- Cu. Ft.

Dry Hole -----

Abandoned -----

Date

10/9 191 S. C. Cady Scout


Map No. K14 Sec. 13 Twp. 26 R. 4Well No. 4209Company Engine

Contractor _____

NORTH

WEST

EAST

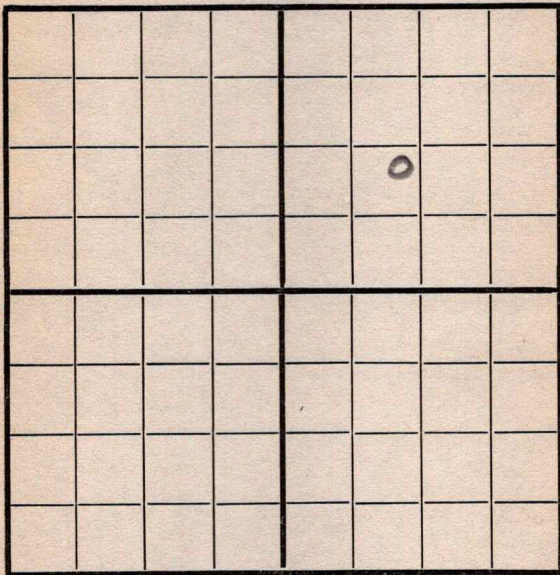

SOUTH

1120 S-W

Location _____

Rig up _____

Drilling and Remarks:

1920

RECORD

Cased _____ in., _____ ft.

Sand _____

Gas _____

Oil _____

Total Depth _____

PRODUCTION

1st 24 hrs. Nat. _____

1st 24 hrs. after shot _____

Gas _____ Cu. Ft.

Dry Hole _____

Abandoned _____

Date

10/16 1918 Candy Scout

WEST

EAST

SOUTH

Date _____

191

Scout

Map No. 1514 Sec. 13 Twp. 26 R. 4Well No. 4709ueCompany Cummins

Contractor _____

NORTH

WEST

EAST

SOUTH

11208-W

Location _____

Rig up _____

Drilling and Remarks:

RECORD

Cased _____ in., _____ ft.

Sand _____

Gas _____

Oil _____

Total Depth _____

PRODUCTION

1st 24 hrs. Nat. _____

1st 24 hrs. after shot _____

Gas _____ Cu. Ft.

Dry Hole _____

Abandoned _____

Date


10/30 1918 Cummins Scout

Map No. 15 14 Sec. 13 Twp. 26 R. 4
 Well No. 4 Tague
Evergreen Company
 Contractor

NORTH

WEST

EAST

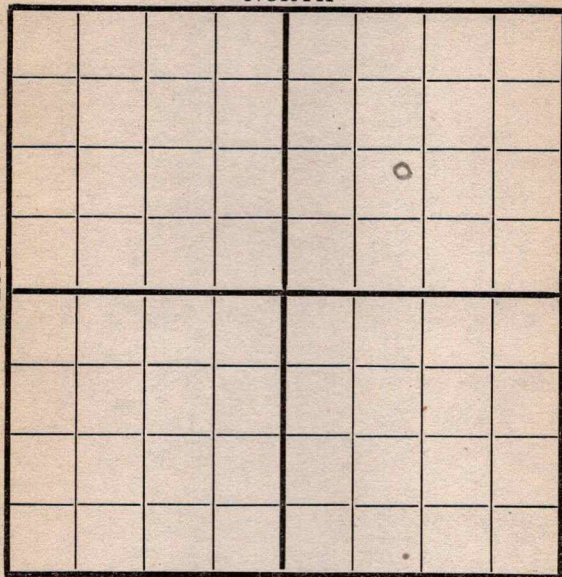

SOUTH

1120 S-W

Location _____

Rig up _____

Drilling and Remarks:

2100

RECORD

Cased _____ in., _____ ft.

Sand _____

Gas _____

Oil _____

Total Depth _____

PRODUCTION

1st 24 hrs. Nat. _____

1st 24 hrs. after shot _____

Gas _____ Cu. Ft.

Dry Hole _____

Abandoned _____

Date

11/61918Leidy

Scout

Map No. 1514 Sec. 13 Twp. 26 R. 4Well No. 4 Toigue


_____ Company

_____ Contractor

NORTH

WEST

EAST

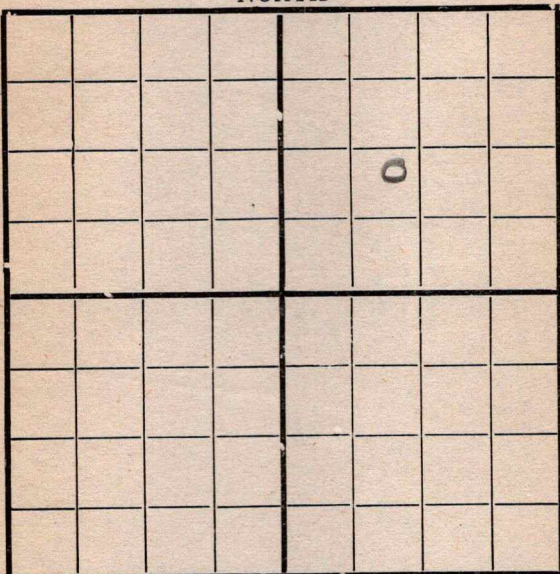

SOUTH

Location _____

Rig up _____

Drilling and Remarks:

22
2100

RECORD

Cased _____ in., _____ ft.

Sand _____

Gas _____

Oil _____

Total Depth _____

PRODUCTION

1st 24 hrs. Nat. _____

1st 24 hrs. after shot _____

Gas _____ Cu. Ft.

Dry Hole _____

Abandoned _____

Date

11/13 1918 Carley Scout

Map No. K14 Sec. 13 Twp. 26 R. 4Well No. 4 Logue


Company

Contractor

NORTH

WEST

EAST

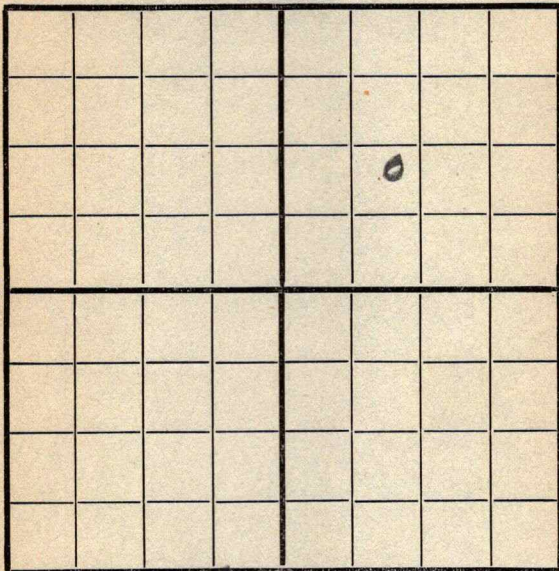

SOUTH

1120 S & W

Location

Rig up

Drilling and Remarks:

RECORD

Cased _____ in., _____ ft.

Sand _____

Gas _____

Oil _____

Total Depth _____

PRODUCTION

1st 24 hrs. Nat. _____

1st 24 hrs. after shot _____

Gas _____ Cu. Ft.

Dry Hole _____

Abandoned _____

Date

191

Scout

Map No. K14 Sec. 13 Twp. 26 R. 4


Well No. 4 Page
Engine Company

Contractor

NORTH

WEST

EAST

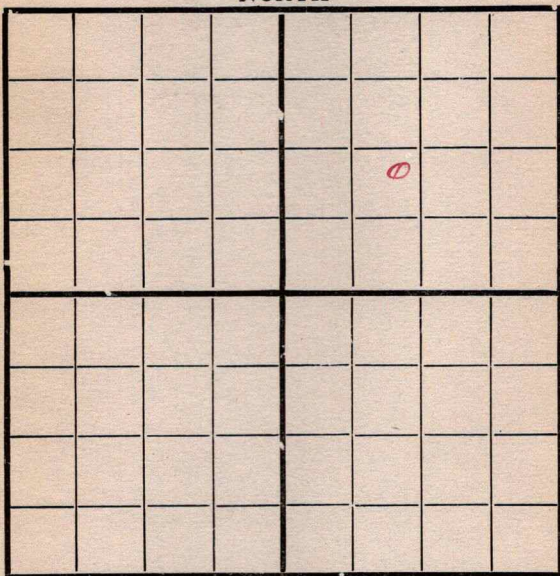

SOUTH

1120A-W

Location _____

Rig up _____

Drilling and Remarks:

22
2100

RECORD

Cased _____ in., _____ ft.

Sand _____

Gas _____

Oil _____

Total Depth _____

PRODUCTION

1st 24 hrs. Nat. _____

1st 24 hrs. after shot _____

Gas _____ Cu. Ft.

Dry Hole _____

Abandoned _____

Date

11/27 191 8 Candy Scout

Map No. 514 Sec. 13 Twp. 25 R. 4Well No. 4 ToqueEngine Company

Contractor

NORTH

WEST

EAST

SOUTH

1120 S & W

Location _____

Rig up _____

Drilling and Remarks:

2160

RECORD

Cased _____ in., _____ ft.

Sand _____

Gas _____

Oil _____

Total Depth _____

PRODUCTION

1st 24 hrs. Nat. _____

1st 24 hrs. after shot _____

Gas _____ Cu. Ft.

Dry Hole _____

Abandoned _____

Date

12/41918S. Candy

Scout

Map No. K14 Sec. 13 Twp. 26 R. 4Well No. 4909

Company _____

Contractor _____

NORTH

WEST

EAST

SOUTH

1120 S - 25

Location _____

Rig up _____

Drilling and Remarks:

RECORD

Cased _____ in., _____ ft.

Sand _____

Gas _____

Oil _____

Total Depth _____

PRODUCTION

1st 24 hrs. Nat. _____

1st 24 hrs. after shot _____

Gas _____ Cu. Ft.

Dry Hole _____

Abandoned _____

Date

12/11 191 8Scout Conroy

Map No. K14 Sec. 13 Twp. 26 R. 4Well No. 49 Tague


Company _____

Contractor _____

NORTH

WEST

EAST

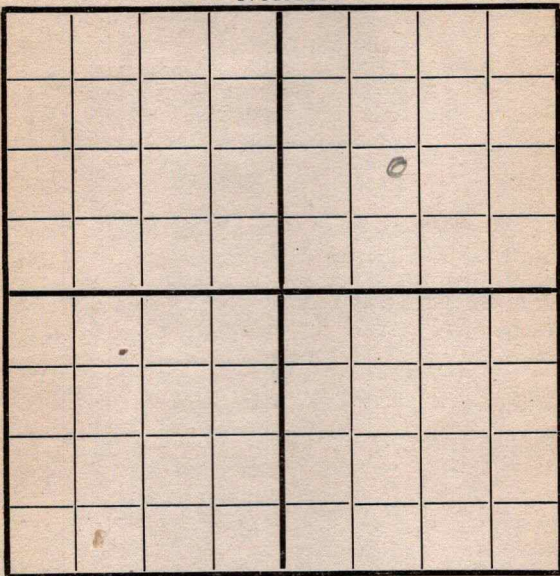

SOUTH

1120 S & W

Location _____

Rig up _____

Drilling and Remarks:

RECORD

Cased _____ in., _____ ft.

Sand _____

Gas _____

Oil _____

Total Depth _____

PRODUCTION

1st 24 hrs. Nat. _____

1st 24 hrs. after shot _____

Gas _____ Cu. Ft.

Dry Hole _____

Abandoned _____

Date

12/18

Scout

Map No. 114 Sec. 13 Twp. 26 R. 4Well No. 490


Company _____

Contractor _____

NORTH

WEST

EAST

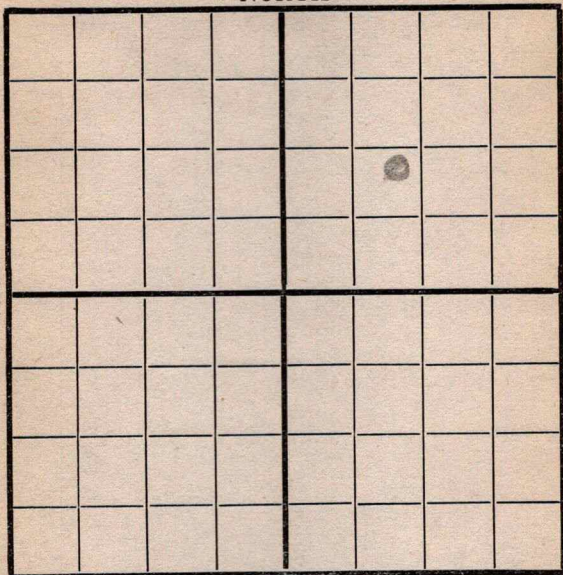

SOUTH

Location _____

Rig up _____

Drilling and Remarks:

U R
2470

RECORD

Cased _____ in., _____ ft

Sand _____

Gas _____

Oil _____

Total Depth _____

PRODUCTION

1st 24 hrs. Nat. _____

1st 24 hrs. after shot _____

Gas _____ Cu. Ft.

Dry Hole _____

Abandoned _____

Date

12/24/1918 J. C. Cuddy

Scot


Map No. K14 Sec. 13 Twp. 26 R. 4Well No. 4 DagueCompany Engine

Contractor _____

NORTH

WEST

EAST

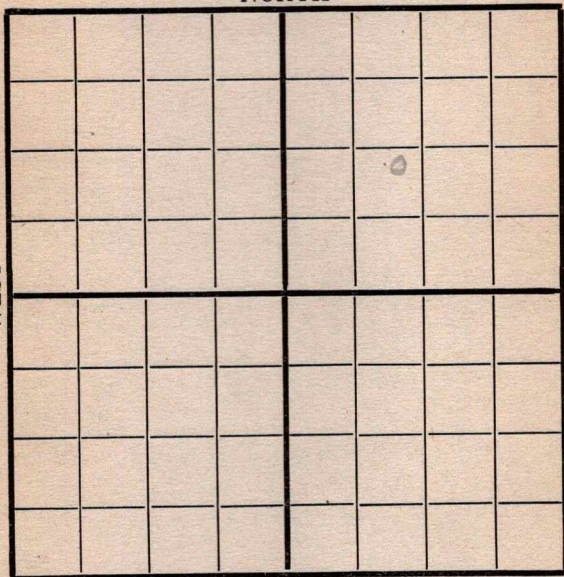

SOUTH

1/20 S + W

Location _____

Rig up _____

Drilling and Remarks:

SD 2470

RECORD

Cased _____ in., _____ ft.

Sand _____

Gas _____

Oil _____

Total Depth _____

PRODUCTION

1st 24 hrs. Nat. _____

1st 24 hrs. after shot _____

Gas _____ Cu. Ft.

Dry Hole _____

Abandoned _____

Date

1/1 9 Canary Scout

Map No. K 14 Sec. 13 Twp. 26 R. 4Well No. 4909Company Argonne

Contractor _____

NORTH

WEST

EAST

SOUTH

1120 8922

Location _____

Rig up _____

Drilling and Remarks:

22 2470

RECORD

Cased _____ in., _____ ft.

Sand _____

Gas _____

Oil _____

Total Depth _____

PRODUCTION

1st 24 hrs. Nat. _____

1st 24 hrs. after shot _____

Gas _____ Cu. Ft.

Dry Hole _____

Abandoned _____

Date

1/8 191 9 Conley Scout


Map No. K14 Sec. 13 Twp. 26 R. 4Well No. 4909Company Amesbury

Contractor _____

NORTH

WEST

EAST

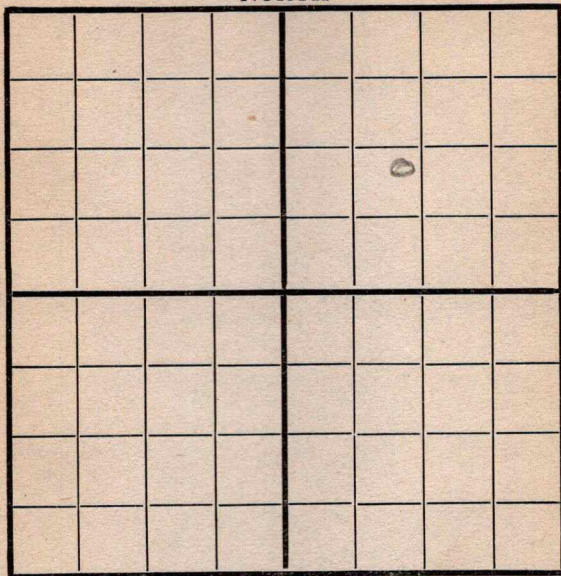

SOUTH

Location _____

Rig up _____

Drilling and Remarks:

22 2470

RECORD

Cased _____ in., _____ ft.

Sand _____

Gas _____

Oil _____

Total Depth _____

PRODUCTION

1st 24 hrs. Nat. _____

1st 24 hrs. after shot _____

Gas _____ Cu. Ft.

Dry Hole _____

Abandoned _____

Date

1/15

191

9 Amesbury

Scout

Map No. K14 Sec. 13 Twp. 26 R. 4Well No. 4 Tague
Engine Company

Contractor

NORTH

WEST

EAST

SOUTH

112087W

Location _____

Rig up _____

Drilling and Remarks:

22 2470

RECORD

Cased _____ in., _____ ft.

Sand _____

Gas _____

Oil _____

Total Depth _____

PRODUCTION

1st 24 hrs. Nat. _____

1st 24 hrs. after shot _____

Gas _____ Cu. Ft.

Dry Hole _____

Abandoned _____

Date

1/22 191 9 C. C. C. C. Scout


Map No. 114 Sec. 13 Twp. 26 R. 4Well No. 4 LagueEmpire Company

Contractor

NORTH

WEST

EAST

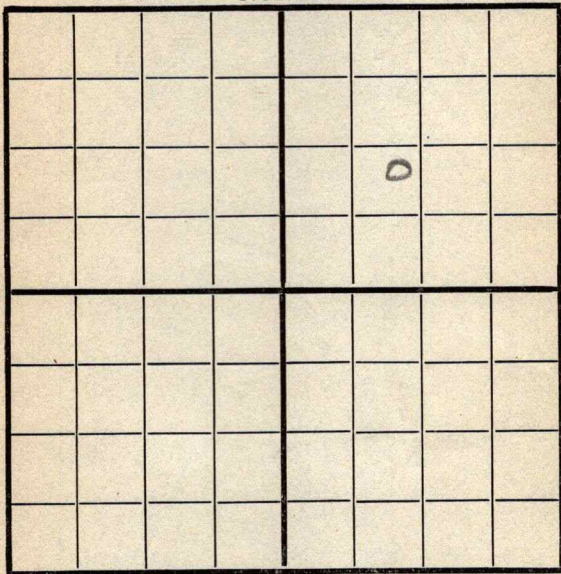

SOUTH

1120 S-W

Location _____

Rig up _____

Drilling and Remarks:

D. 10 @
2490

RECORD

Cased _____ in., _____ ft.

Sand _____

Gas _____

Oil _____

Total Depth _____

PRODUCTION

1st 24 hrs. Nat. _____

1st 24 hrs. after shot _____

Gas _____ Cu. Ft.

Dry Hole _____

Abandoned _____

Date

3/8

191

9Pyle

Scout

Map No. K14 Sec. 13 Twp. 26 R. 4Well No. 4 Tague
Empire Company

Contractor

NORTH

WEST

EAST

COMPLETED

SOUTH

11205-W

Location _____

Rig up _____

Drilling and Remarks:

RECORD

Cased _____ in., _____ ft.

Sand 2472 - 2503

Gas _____

Oil _____

Total Depth _____

PRODUCTION

1st 24 hrs. Nat. 100 bbls

1st 24 hrs. after shot _____

Gas _____ Cu. Ft.

Dry Hole _____

Abandoned _____

Date

191

9

Pyle

Scout

6/3