

Map No. \_\_\_\_\_ Sec. 13 Twp. 26 R. 4  
 Well No. 11 Mohr Farm  
Lecky Oil & Gas Co. Company

NORTH

WEST



EAST

SOUTH

Location \_\_\_\_\_

Rig Up \_\_\_\_\_

Drilling Remarks:

Drilling Remarks:

3013 Area (Sand) 2473-2515/  
6/11/18

### RECORD

Cased \_\_\_\_\_ in. \_\_\_\_\_ ft.

Sand \_\_\_\_\_

Gas \_\_\_\_\_

Oil \_\_\_\_\_

Total Depth \_\_\_\_\_

### PRODUCTION

1st 24 hrs. Nat. \_\_\_\_\_

1st 24 hrs. after shot \_\_\_\_\_

Gas \_\_\_\_\_ cu. ft.

Dry Hole \_\_\_\_\_

Abandoned \_\_\_\_\_

Map No. K14 Sec. 13 Twp. 26 R. 4Well No. 11 Trinity Farm  
Seely Company

NORTH

WEST


EAST

SOUTH

| RECORD                       |                           |
|------------------------------|---------------------------|
| Location -----               | Cased ----- in. ----- Ft. |
| Rig Up -----                 | Sand -----                |
| Drilling and remarks         | Gas -----                 |
|                              | Oil -----                 |
|                              | Total Depth -----         |
| PRODUCTION                   |                           |
| 1st 24 hrs. Nat. -----       |                           |
| 1st 24 hrs. after shot ----- |                           |
| Gas ----- Cu. Ft.            |                           |
| Dry Hole -----               |                           |
| Abandoned -----              |                           |

Date 5/9, 1918 Candry Scout  
 FIRST REPORT

Map No. \_\_\_\_\_ Sec. 13 Twp. 26 R. 4  
 Well No. 11 Mabrey Farm \_\_\_\_\_  
Selby Oil & Gas Company \_\_\_\_\_  
 NORTH

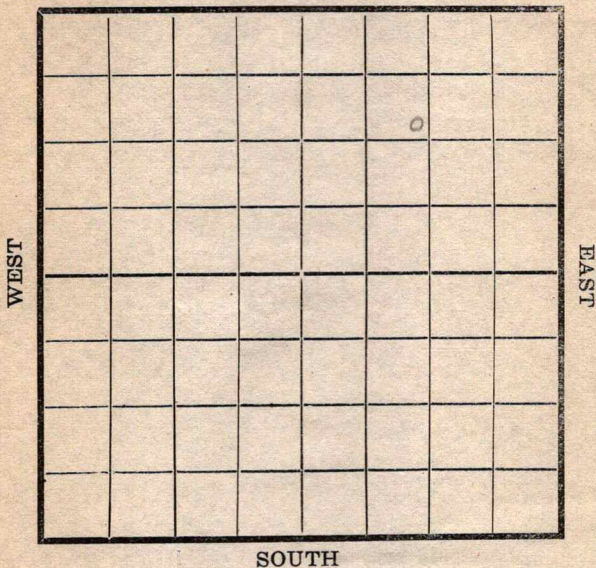


| RECORD                                                                       |                              |
|------------------------------------------------------------------------------|------------------------------|
| Location _____                                                               | Cased _____ in. _____ Ft.    |
| Rig Up _____                                                                 | Sand _____                   |
| Drilling and remarks<br><br><u>200</u><br><br><u>Company</u><br><u>Tools</u> | Gas _____                    |
|                                                                              | Oil _____                    |
|                                                                              | Total Depth _____            |
|                                                                              | PRODUCTION                   |
|                                                                              | 1st 24 hrs. Nat. _____       |
|                                                                              | 1st 24 hrs. after shot _____ |
|                                                                              | Gas _____ Cu. Ft.            |
|                                                                              | Dry Hole _____               |
|                                                                              | Abandoned _____              |

Date

5/15, 1918 Candley Scout \_\_\_\_\_

Map No. \_\_\_\_\_ Sec. 13 Twp. 26 R. 4  
Well No. 11 Malum Farm  
Selling Oil Company  
NORTH

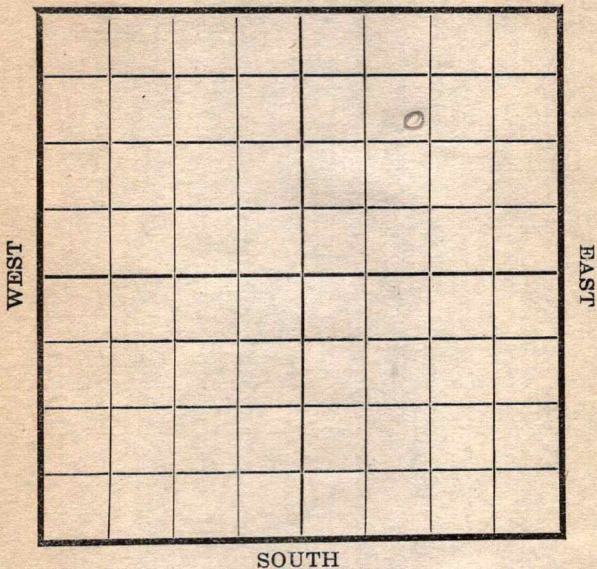

|                      | RECORD                       |
|----------------------|------------------------------|
| Location _____       | Cased _____ in. _____ Ft.    |
| Rig Up _____         | Sand _____                   |
| Drilling and remarks | Gas _____                    |
| <u>200</u>           | Oil _____                    |
|                      | Total Depth _____            |
|                      | PRODUCTION                   |
|                      | 1st 24 hrs. Nat. _____       |
|                      | 1st 24 hrs. after shot _____ |
|                      | Gas _____ Cu. Ft.            |
|                      | Dry Hole _____               |
|                      | Abandoned _____              |

Date 5/22, 1918 Cordry Scout

Map No. \_\_\_\_\_ Sec. 13 Twp. 26 R. 4Well No. 11 Seabury Farm \_\_\_\_\_\_\_\_\_\_Seabury Company

NORTH

WEST

EAST

SOUTH

Location \_\_\_\_\_

Rig Up \_\_\_\_\_

Drilling and remarks

1270

## RECORD

Cased \_\_\_\_\_ in. \_\_\_\_\_ Ft.

Sand \_\_\_\_\_

Gas \_\_\_\_\_

Oil \_\_\_\_\_

Total Depth \_\_\_\_\_

## PRODUCTION

1st 24 hrs. Nat. \_\_\_\_\_

1st 24 hrs. after shot \_\_\_\_\_

Gas \_\_\_\_\_ Cu. Ft.

Dry Hole \_\_\_\_\_

Abandoned \_\_\_\_\_

Date

5/29, 1918 Scout

Map No. \_\_\_\_\_ Sec. 13 Twp. 26 R. 4Well No. 11 Ruby \_\_\_\_\_ Farm\_\_\_\_\_ Selby \_\_\_\_\_ Company

NORTH

WEST

EAST

SOUTH

Location \_\_\_\_\_

Rig Up \_\_\_\_\_

Drilling and remarks

1270

## RECORD

Cased \_\_\_\_\_ in. \_\_\_\_\_ Ft.

Sand \_\_\_\_\_

Gas \_\_\_\_\_

Oil \_\_\_\_\_

Total Depth \_\_\_\_\_

## PRODUCTION

1st 24 hrs. Nat. \_\_\_\_\_

1st 24 hrs. after shot \_\_\_\_\_

Gas \_\_\_\_\_ Cu. Ft.

Dry Hole \_\_\_\_\_

Abandoned \_\_\_\_\_

Date

6/5, 1918 C. Condy \_\_\_\_\_ Scout

Map No. K14 Sec. 13 Twp. 26 R. 4Well No. 11 ShubertSelby Oil CompanyComptony Tools Contractor

NORTH

WEST

EAST

SOUTH

COMPLETED

Location \_\_\_\_\_

Rig up \_\_\_\_\_

Drilling and Remarks:

Est at  
300 bbls

## RECORD

Cased \_\_\_\_\_ in., \_\_\_\_\_ ft.

Sand 2473-2515

Gas \_\_\_\_\_

Oil \_\_\_\_\_

Total Depth \_\_\_\_\_

## PRODUCTION

1st 24 hrs. Nat. \_\_\_\_\_

1st 24 hrs. after shot \_\_\_\_\_

Gas \_\_\_\_\_ Cu. Ft.

Dry Hole \_\_\_\_\_

Abandoned \_\_\_\_\_

Date

6/11 1918 Comptony Scout