


Map No. 14 Sec. 25 Twp. 26 R. 4
 Well No. Largent Farm
Magnolia Company

NORTH

WEST

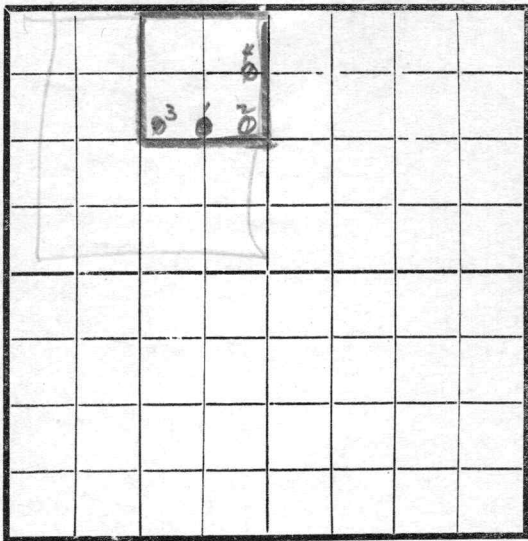

EAST

SOUTH

RECORD

Location -----
 Rig Up -----
 Drilling and remarks

Cased ----- in. ----- Ft.
 Sand -----
 Gas -----
 Oil -----
 Total Depth -----

PRODUCTION

1st 24 hrs. Nat. -----
 1st 24 hrs. after shot -----
 Gas ----- Cu. Ft.
 Dry Hole -----
 Abandoned -----

*Note: The Magnolia
 has been E⁴ of NW⁴
 as outlined above
 Second
 7/26/1918*

Date

-----, 191----- Scout

Map shows
 Magnolia as
 corner of NW⁺
 You show
 Central West.
 Which is correct?
 RMM

RECORD

Carried in _____
 Sand _____
 Gas _____
 Oil _____
 Total Depth _____
 PRODUCTION
 1st 24 hrs. Net _____
 1st 24 hrs. after shut _____
 Gas _____
 Oil _____
 Dr. Hole _____
 Abandoned _____

Location _____
 Rig No. _____
 Drilling and remarks _____

Date _____


181

Map No. K14 Sec. 24 Twp. 26 R. 4Well No. 4 SargentCentral West CompanyH. L. & G. E. Smith Contractor

NORTH

WEST

EAST

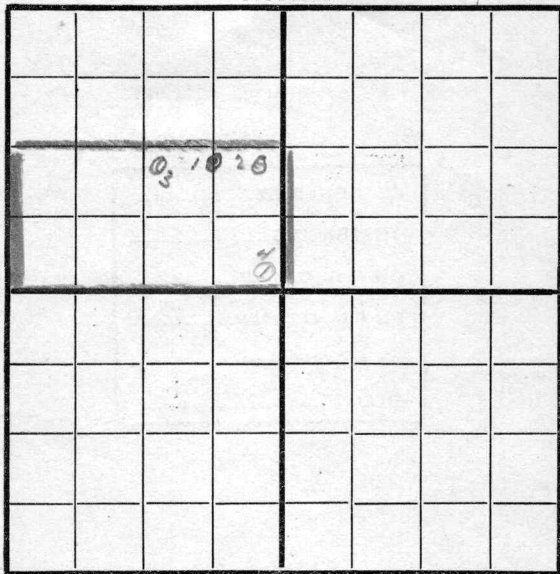

SOUTH

RECORD

Location _____

Cased _____ in., _____ ft.

Rig up _____

Sand _____

Drilling and Remarks:

Gas _____

Oil _____

Total Depth _____

PRODUCTION

1st 24 hrs. Nat. _____

1st 24 hrs. after shot _____

Gas _____ Cu. Ft.

Dry Hole _____

Abandoned _____

FIRST REPORT

Date

7/10 191 J. C. Sargent Scout

Map No. _____ Sec. 24 Twp. 26 R. 9

Well No. _____

Central West **Company**

Bill & Restonworth Contractor

E. Howard NORTH *KS*

NORTH

WEST

EAST

SOUTH

Location _____

Rig up.....

Drilling and Remarks:

RECORD

Cased_____in., _____ft.

Sand

Gas

Oil _____

Total Depth.....

PRODUCTION

1st 24 hrs. Nat. -----

1st 24 hrs. after shot-----

Gas.....Cu. Ft.

Dry Hole.....

Abandoned.....

Date _____

191


Scout

Map No. _____ Sec. 24 Twp. 26 R. 4Well No. 4 _____

_____ Company

_____ Contractor

NORTH

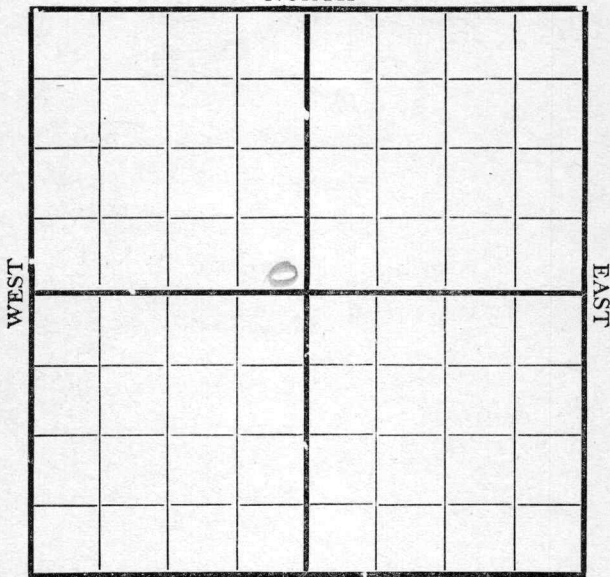

SOUTH

Location _____

Rig up _____

Drilling and Remarks:

Shut down
200

RECORD

Cased _____ in., _____ ft.

Sand _____

Gas _____

Oil _____

Total Depth _____

PRODUCTION

1st 24 hrs. Nat. _____

1st 24 hrs. after shot _____

Gas _____ Cu. Ft.

Dry Hole _____

Abandoned _____

Date


7/17 191 8 C. C. C. C. Scout

Map No. _____ Sec. 24 Twp. 26 R. 4Well No. 460

_____ Company

_____ Contractor

NORTH

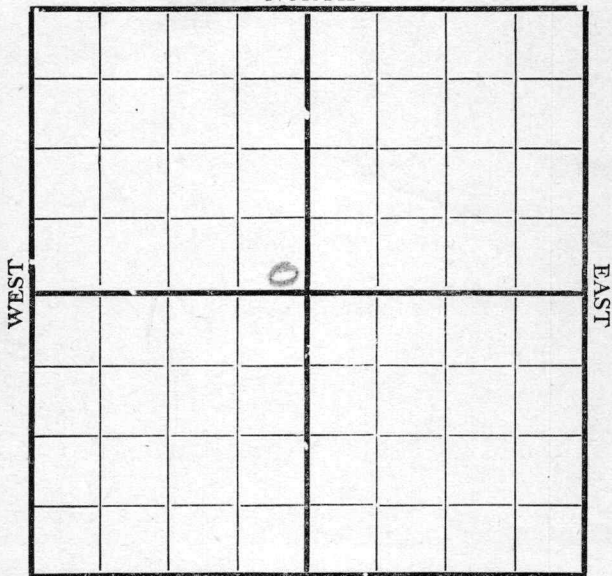

SOUTH

Location _____

Rig up _____

Drilling and Remarks:

460

RECORD

Cased _____ in., _____ ft.

Sand _____

Gas _____

Oil _____

Total Depth _____

PRODUCTION

1st 24 hrs. Nat. _____

1st 24 hrs. after shot _____

Gas _____ Cu. Ft.

Dry Hole _____

Abandoned _____

Date

7/24 1918 Candey Scout


Map No. K14 Sec. 24 Twp. 26 R. 4Well No. 4 Target CreekCentral West Oil Company

Contractor

NORTH

WEST

EAST

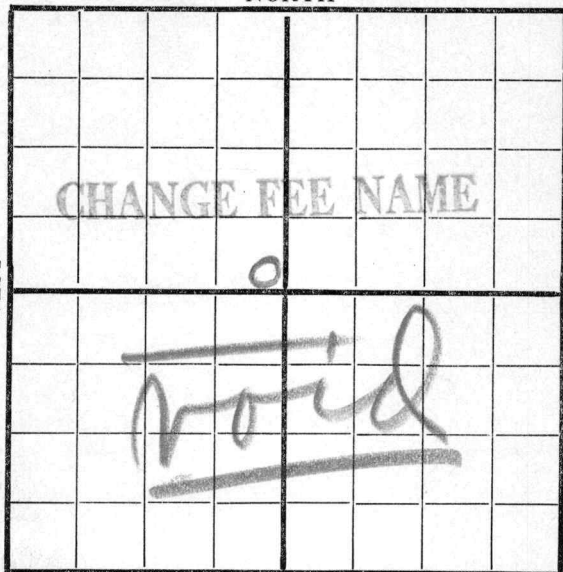

SOUTH

Location _____

Rig up _____

Drilling and Remarks:

RECORD

Cased _____ in., _____ ft.

Sand _____

Gas _____

Oil _____

Total Depth _____

PRODUCTION

1st 24 hrs. Nat. _____

1st 24 hrs. after shot _____

Gas _____ Cu. Ft.

Dry Hole _____

Abandoned _____

Date

7/31 191 P. Canby Scout


Map No. _____ Sec. 24 Twp. 26 R. 4Well No. 4 C Link
Central West oil Company

Contractor _____

NORTH

WEST

EAST

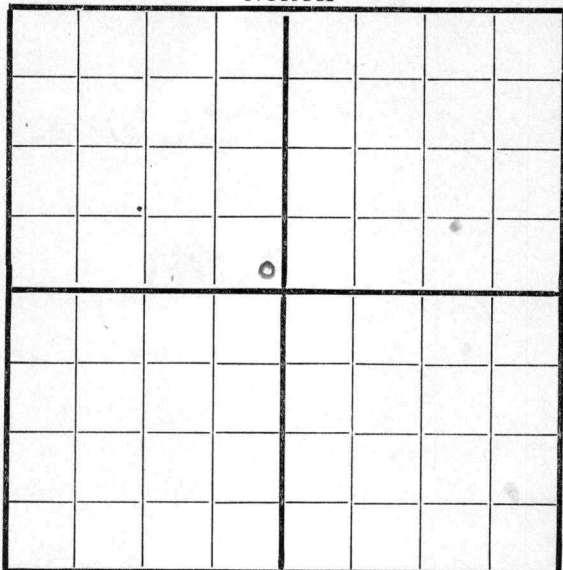

SOUTH

RECORD

Location _____

Cased _____ in., _____ ft.

Rig up _____

Sand _____

Drilling and Remarks:

Gas _____

Oil _____

Total Depth _____

PRODUCTION

1st 24 hrs. Nat. _____

1st 24 hrs. after shot _____

Gas _____ Cu. Ft.

Dry Hole _____

Abandoned _____

Date

7/31 191 P. Conley Scout

Map No. _____ Sec. 34 Twp. 26 R. 4


Well No. 4 Clark

Central Trust Company

Contractor _____

NORTH

WEST

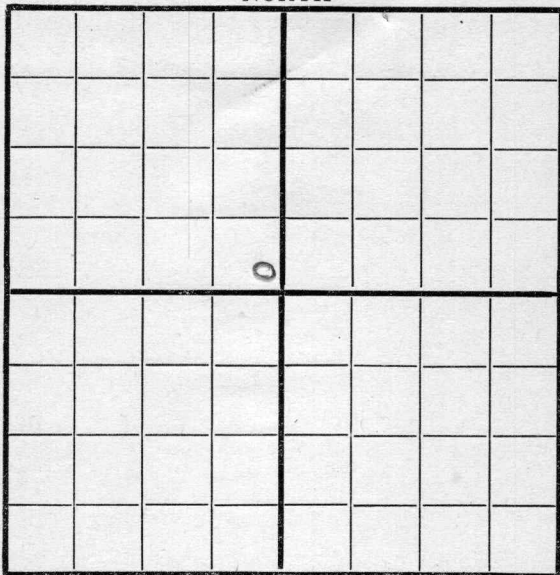

EAST

SOUTH

Location _____

Rig up _____

Drilling and Remarks:

WR 1700

RECORD

Cased _____ in., _____ ft.

Sand _____

Gas _____

Oil _____

Total Depth _____

PRODUCTION

1st 24 hrs. Nat. _____

1st 24 hrs. after shot _____

Gas _____ Cu. Ft.


Dry Hole _____

Abandoned _____

Date

8/7 1918 Candiff Scout

Map No. _____ Sec. 34 Twp. 26 R. 4
 Well No. 4 Clark
 _____ Company
 _____ Contractor

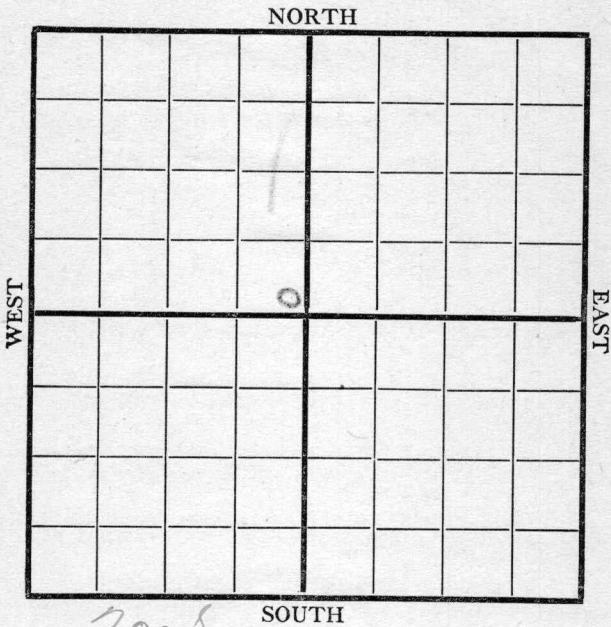


Location <u>2006</u>	Drilling and Remarks: <u>2000'</u>	RECORD	
		Cased _____ in., _____ ft.	
Rig up _____		Sand _____	
		Gas _____	
		Oil _____	
		Total Depth _____	
		PRODUCTION	
		1st 24 hrs. Nat. _____	
		1st 24 hrs. after shot _____	
		Gas _____ Cu. Ft.	
		Dry Hole _____	
		Abandoned _____	

Date 8/15 1918 Cyle Scout

Map No. _____ Sec. 24 Twp. 26 R. 4Well No. 48Central Trust and Company_____
Contractor

NORTH

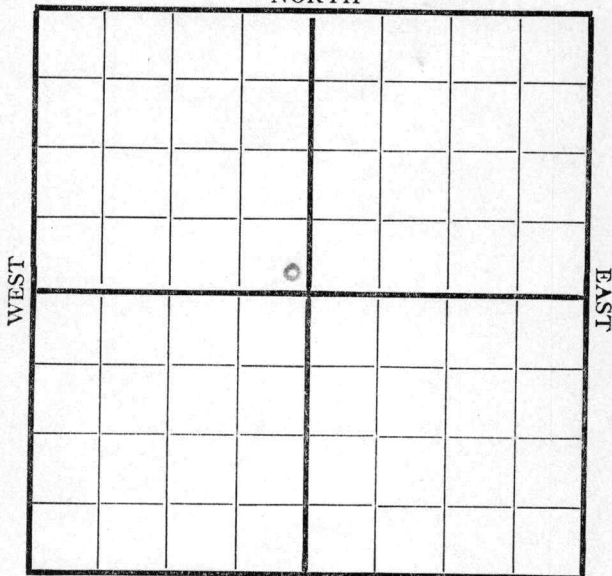

SOUTH

200' DFE

Location _____

Rig up _____

Drilling and Remarks:

2450

RECORD

Cased _____ in., _____ ft.

Sand _____

Gas _____

Oil _____

Total Depth _____

PRODUCTION

1st 24 hrs. Nat. _____

1st 24 hrs. after shot _____

Gas _____ Cu. Ft.

Dry Hole _____

Abandoned _____

Date

8/22 1918 Pyle Scout


Map No. 1514 Sec. 24 Twp. 26 R. 4Well No. 4 ClarkCentral West Company

Contractor

NORTH

WEST

EAST

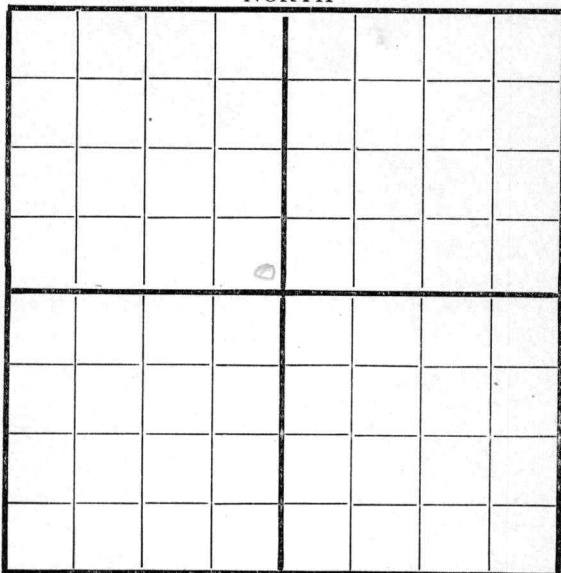

SOUTH

500 84E

RECORD

Location _____

Cased _____ in., _____ ft.

Rig up _____

Sand _____

Drilling and Remarks:

Gas _____

Oil _____

Total Depth _____

PRODUCTION

1st 24 hrs. Nat. _____

1st 24 hrs. after shot _____

Gas _____ Cu. Ft.

Dry Hole _____


Abandoned _____

Date

8/28 191 8 Clark Scout

Map No. 1514 Sec. 24 Twp. 26 R. 4Well No. 4 ClarkCentral West CompanyHale & Teetsworth ContractorE. J. Dwyer NORTH Ko

WEST

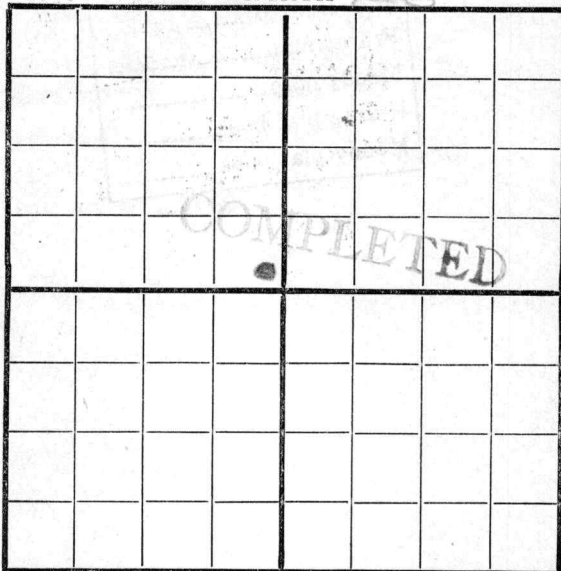

EAST

SOUTH

RECORD

Location _____

Cased _____ in., _____ ft.

Rig up _____

Sand 2617-2635

Drilling and Remarks:

Gas _____

Oil _____

Total Depth _____

PRODUCTION

1st 24 hrs. Nat. _____

1st 24 hrs. after shot _____

Gas _____ Cu. Ft.

Dry Hole _____

Abandoned _____

Date

9/5

191

8Condit

Scout