


Map No. _____ Sec. 24 Twp. 26 R. 4

Well No. 5 Clark Farm
Central West Company

NORTH

WEST

EAST

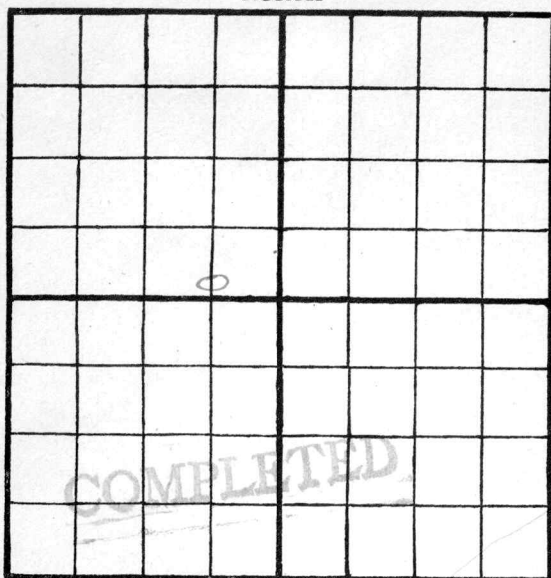

SOUTH

Location _____

Rig Up _____

Drilling Remarks:

Drilling Remarks:

RECORD

PRODUCTION

Cased _____ in. _____ ft.

1st 24 hrs. Nat. _____

Sand _____

1st 24 hrs. after shot _____

Gas _____

Gas _____ cu. ft.

Oil _____

Dry Hole _____

Total Depth _____

Abandoned _____

Map No. 15 14 Sec. 24 Twp. 26 R. 4

Well No. 5 Clark


Central West Company

Contractor

NORTH

WEST

EAST

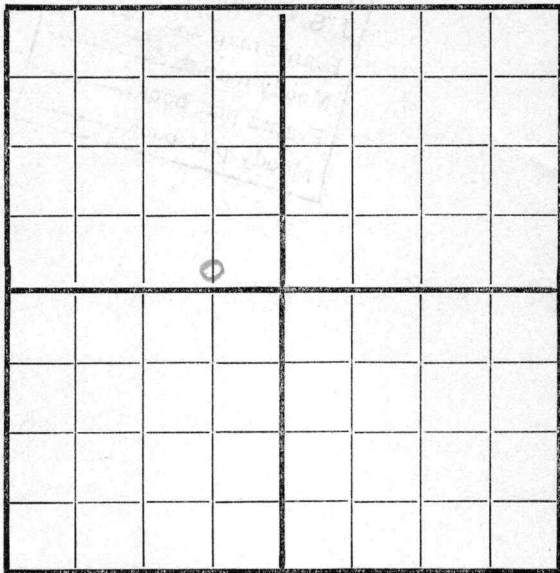

SOUTH

2005-660 E-

Location _____

Rig up ☒

Drilling and Remarks:

RECORD

Cased _____ in., _____ ft.

Sand _____

Gas _____

Oil _____

Total Depth _____

PRODUCTION

1st 24 hrs. Nat. _____

1st 24 hrs. after shot _____

Gas _____ Cu. Ft.

Dry Hole _____


Abandoned _____

FIRST REPORT

☒

Date

9/25 1918 S. Candy Scout

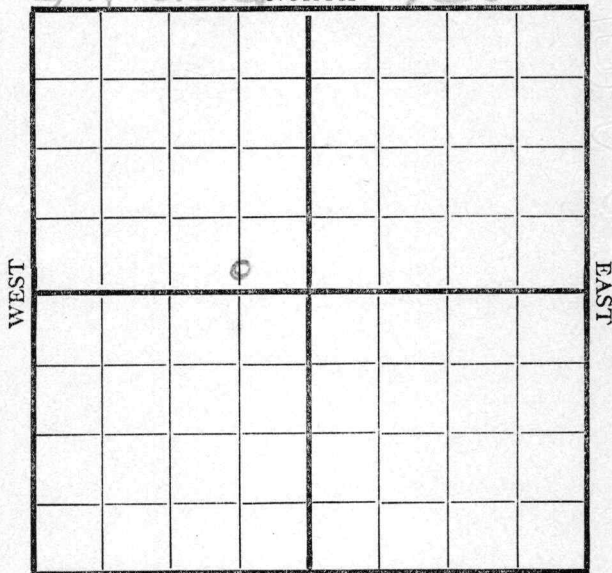Map No. 1514 Sec. 24 Twp. 26 R. 4Well No. 5-ClarkCentral West CompanySunshine Drill Co ContractorClayton NORTH Ks

SOUTH

2005-660 E

Location _____

Rig up ☒

Drilling and Remarks:

Rigging up**RECORD**

Cased _____ in., _____ ft.

Sand _____

Gas _____

Oil _____

Total Depth _____

PRODUCTION

1st 24 hrs. Nat. _____

1st 24 hrs. after shot _____

Gas _____ Cu. Ft.

Dry Hole _____

Abandoned _____

Date

10/3 191 S. C. C. C. Scout

Well No. 5 Clark

Central West Company

NORTH


SOUTH

Location _____

Rig up_____

Drilling and Remarks:

500

RECORD

Cased _____ in., _____ ft.

Sand_____

Gas

Oil

Total Depth_____

PRODUCTION

1st 24 hrs. Nat.

1st 24 hrs. after shot-----

Gas_____Cu. Ft.


Dry Hole_____

Abandoned.....

Date _____

10/9 1918 C. C. C. Scout

Map No. K14 Sec. 24 Twp. 26 R. 4
Well No. 50
Central West Company
Contractor

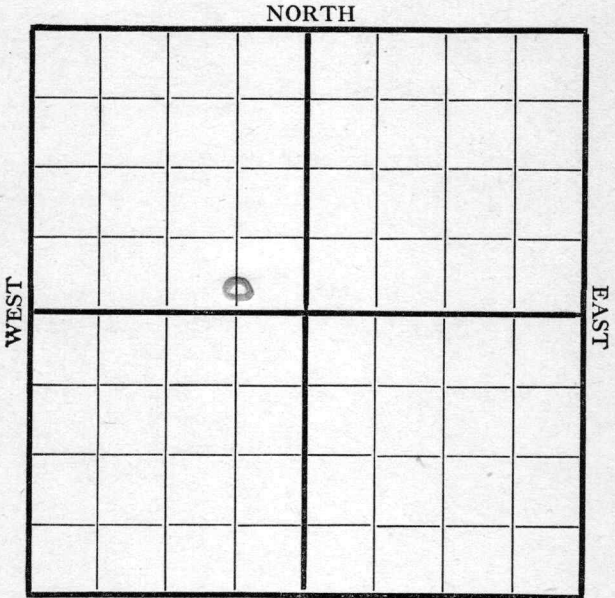

2008-660 E

Location _____
Rig up _____
Drilling and Remarks:

RECORD

Cased _____ in., _____ ft.
Sand _____
Gas _____
Oil _____
Total Depth _____

Shut Down
650

PRODUCTION

1st 24 hrs. Nat. _____
1st 24 hrs. after shot _____
Gas _____ Cu. Ft.
Dry Hole _____
Abandoned _____

Date 10/16 1918 Scout


Map No. K14 Sec. 29 Twp. 26 R. 4Well No. 5 CentralCompany Central

Contractor _____

NORTH

WEST

EAST

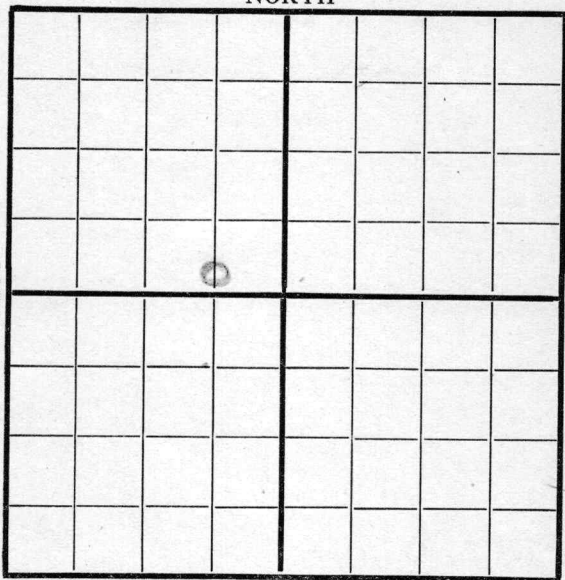

SOUTH

2005-660

Location _____

Rig up _____

Drilling and Remarks:

1000

RECORD

Cased _____ in., _____ ft.

Sand _____

Gas _____

Oil _____

Total Depth _____

PRODUCTION

1st 24 hrs. Nat. _____

1st 24 hrs. after shot _____

Gas _____ Cu. Ft.

Dry Hole _____

Abandoned _____

Date

10/23 191 S. Candy Scout


Map No. K14 Sec. 24 Twp. 26 R. 4Well No. 5000Central West Company

Contractor

NORTH

WEST

EAST

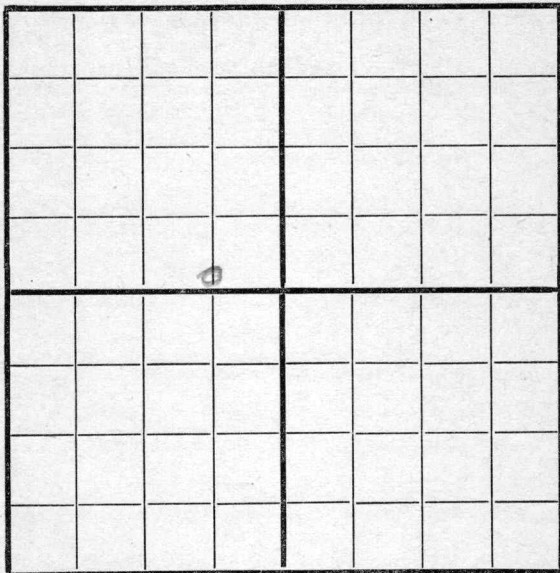

SOUTH

200 S-660 E

Location _____

Rig up _____

Drilling and Remarks:

1300

RECORD

Cased _____ in., _____ ft.

Sand _____

Gas _____

Oil _____

Total Depth _____

PRODUCTION

1st 24 hrs. Nat. _____

1st 24 hrs. after shot _____

Gas _____ Cu. Ft.

Dry Hole _____

Abandoned _____

Date

10/30 1918 S. Landry Scout


Map No. K14 Sec. 24 Twp. 26 R. 4Well No. 5000Central West Company

Contractor

NORTH

WEST

EAST

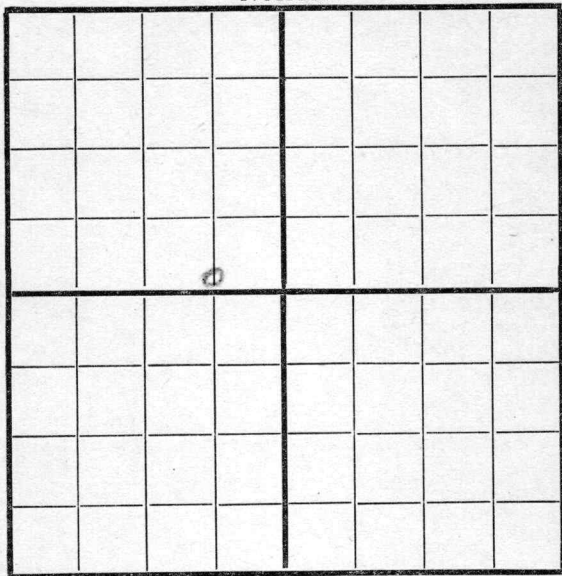

SOUTH

2005-6602

Location _____

Rig up _____

Drilling and Remarks:

1800

RECORD

Cased _____ in., _____ ft.

Sand _____

Gas _____

Oil _____

Total Depth _____

PRODUCTION

1st 24 hrs. Nat. _____

1st 24 hrs. after shot _____

Gas _____ Cu. Ft.

Dry Hole _____

Abandoned _____

Date

11/6

191


J. Conley

Scout

Map No. 1514 Sec. 34 Twp. 26 R. 4Well No. 5000Central West Company

Contractor

NORTH

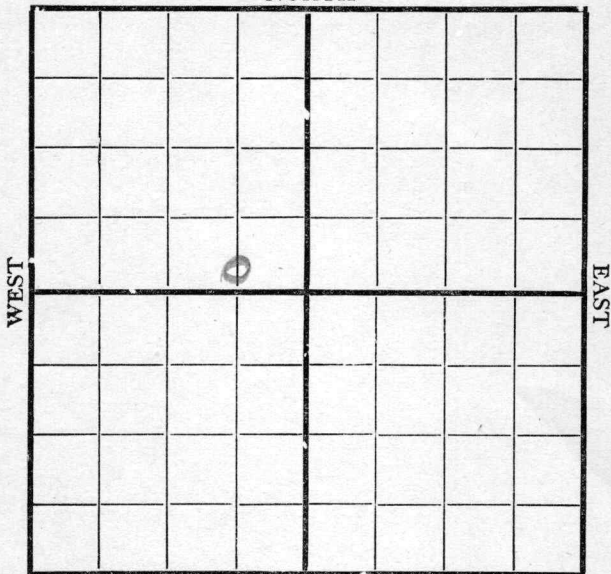

SOUTH

Location _____

Rig up _____

Drilling and Remarks:

2300

RECORD

Cased _____ in., _____ ft.

Sand _____

Gas _____

Oil _____

Total Depth _____

PRODUCTION

1st 24 hrs. Nat. _____

1st 24 hrs. after shot _____

Gas _____ Cu. Ft.


Dry Hole _____

Abandoned _____

Date

11/13 191 P. Condyff Scout

Map No. 1514 Sec. 24 Twp. 26 R. 4
 Well No. 5000
Central-West Company
 Contractor

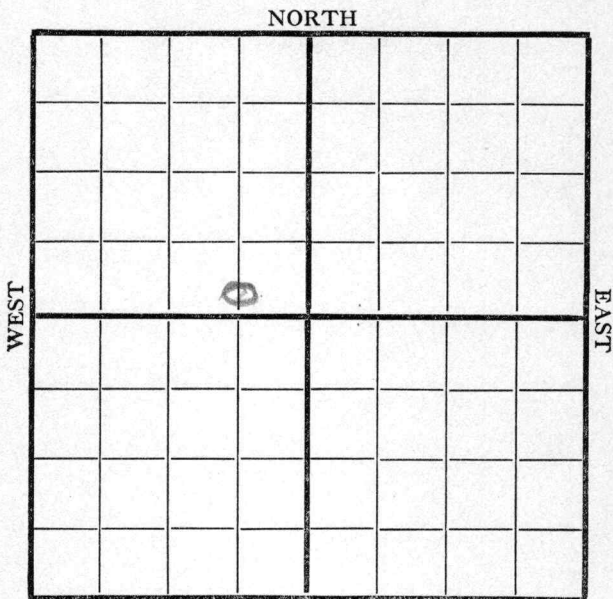

2005660E

Location _____
 Rig up _____
 Drilling and Remarks:

2460

RECORD


Cased _____ in., _____ ft.
 Sand _____
 Gas _____
 Oil _____
 Total Depth _____

PRODUCTION

1st 24 hrs. Nat. _____
 1st 24 hrs. after shot _____
 Gas _____ Cu. Ft.
 Dry Hole _____
 Abandoned _____

Date

11/20 J. C. Carey Scout
 191

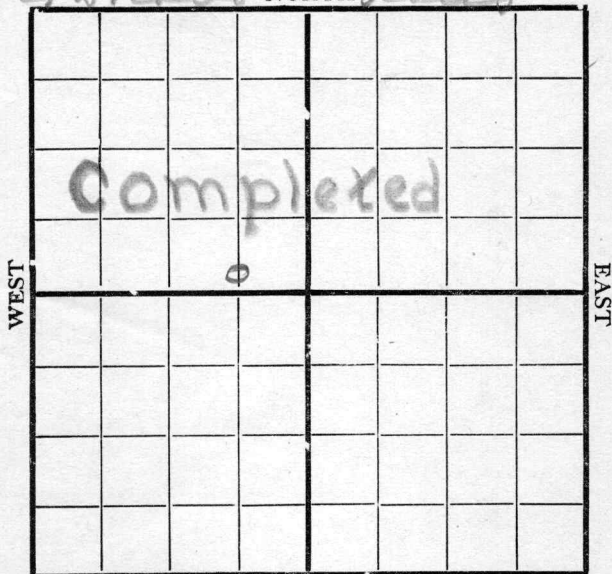Map No. K14 Sec. 24 Twp. 26 R. 4Well No. 5 ClarkCentral-West Oil CompanySunshine Drilling Co. ContractorEl Dorado NORTH Kansas2004-6608 SOUTH

Location _____

Rig up _____

Drilling and Remarks:

Est at
80 Bbls**RECORD**

Cased _____ in., _____ ft.

Sand 2621-2631

Gas _____

Oil _____

Total Depth _____

PRODUCTION

1st 24 hrs. Nat. _____

1st 24 hrs. after shot _____

Gas _____ Cu. Ft.

Dry Hole _____

Abandoned _____

Date _____

11/27 191 P. Cardy Scout