
KANSAS Butler County

FORM 51 5M BRIX

Section 27 Township 26 Range 7E

Well No. #2 "B" Young

Company Eldorado Ref.

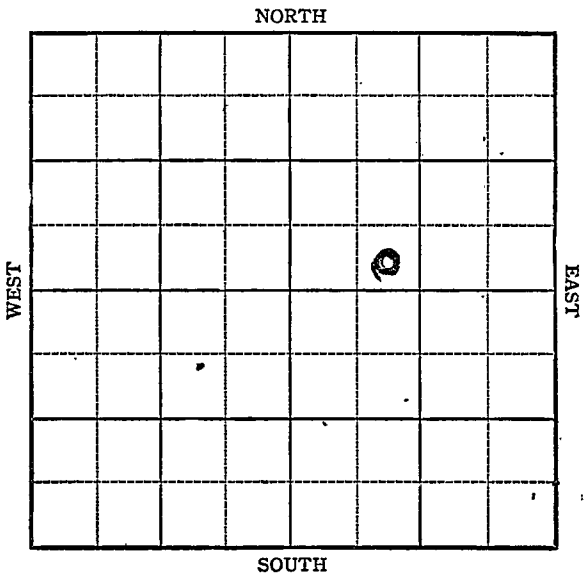

FORM 252-A
5M 9-44 PETROL

KANSAS

Butler County

Sec. 27 Twp. 26S R. 7E

Well No. #2, "B" Young Farm

~~Eldorado Ref.~~ Company

Miscellaneous


____ Ft. from N. Line

330 Ft. from S. Line

____ Ft. from E. Line

990 Ft. from W. Line

SE SW NE

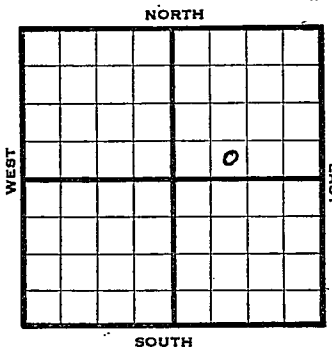

1945	REPORT
1-3	Machine
1/10	"
1/17	"
1/26	12" @ 906 Drlg. 1480'
1/31	KC 2027 TD 2172 7" @ 2140' RUST
2/7	KC 2027 7" @ 2140 4000 acid TD 2172 Pump 150 Pot Grav. 38.0

COMPLETED

FORM 26 200 BKS 1-44 PETROL

Pool Name Miscellaneous

Map No. 7) Sec. 27 Twp. 26 R. 7E


Well No. 2 "B" Young

Eldorado Ref. Company

FIRST REPORT Contractor

SE SW NE

SECTION PLAT

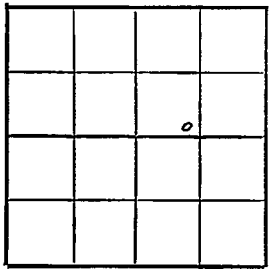

Ft. from N. Line

330 Ft. from S. Line

Ft. from E. Line

990 Ft. from W. Line

Butler

Location

Rig up

Drilling and Remarks:

machine

RECORD

Cased in., ft.

Sand

Gas

Oil

Total Depth

PRODUCTION

1st 24 hrs. Nat.

1st 24 hrs. after shot

Gas Cu. Ft.

Dry Hole

Abandoned

Date

JAN 3 1945 19 S. J. LEWIS Scout

FORM 26 200 BKS. 1 44 PETROL

Pool Name Miscellaneous

Map No. K-15 Sec. 27 Twp. 26 R. 7E


Well No. 2 "B" Young

Eldorado Ref. Company

COMPLETED Contractor

SE SW NE

SECTION PLAT

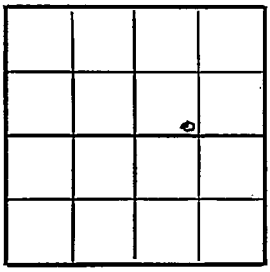

____ Ft. from N. Line

330 Ft. from S. Line

____ Ft. from E. Line

990 Ft. from W. Line

Butler

Location

Rig up

Drilling and Remarks:

TC. 2027

7" C 2140

4000 Acid

Pump 150 B of

38° Gr

RECORD

Cased ____ in., ____ ft.

Sand

Gas

Oil

Total Depth 2172

PRODUCTION

1st 24 hrs. Nat.

1st 24 hrs. after shot

Gas ____ Cu. Ft.

Dry Hole

Abandoned

Date

FEB 7 1945 19 S. I. LEWIS Scout