


Map No. _____ Sec. 13 Twp. 26 R. 4
Well No. 6. Lague Farm _____
Empire Gas & Fuel Co. Company

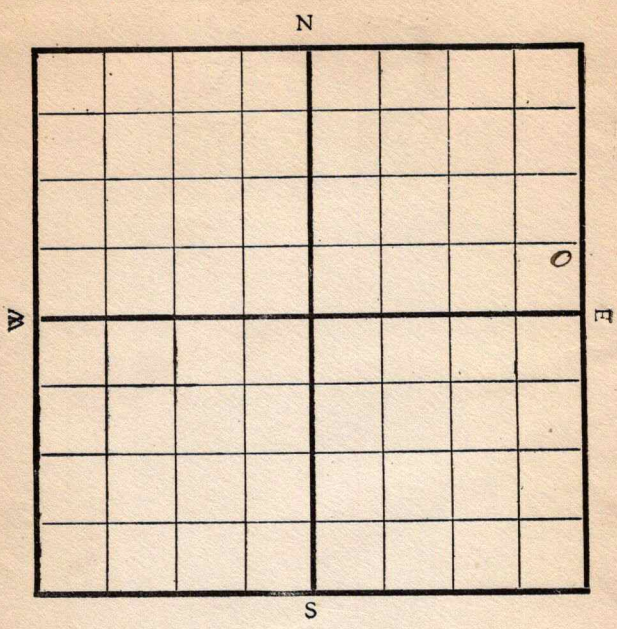

Location _____
Drilling Remarks:

Rig Up _____
Drilling Remarks:

COMPLETED

RECORD

Cased _____ in. _____ ft.
Sand _____
Gas _____
Oil _____
Total Depth _____

PRODUCTION

1st 24 hrs. Nat. _____
1st 24 hrs. after shot _____
Gas _____ cu. ft.
Dry Hole _____
Abandoned _____

Map No. _____ Sec. 13 Twp. 26 R. 4Well No. 6. Inque Farm _____Empire Gas Fuel Co. Company _____


Contractor _____

ME. Quarter _____

_____ Ft. from N. Line

583 Ft. from S. Line160 Ft. from E. Line

_____ Ft. from W. Line

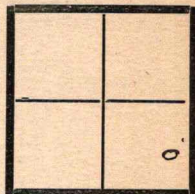

REPORT

FIRST REPORT

10/27 Rig up
17/20 Spud
4/14 Spud 2498-2507- 27600
10 day test

COMPLETED

Map No. K14 Sec. 13 Twp. 26 R. 4Well No. 6 TagueEmpire Company

Contractor

SECTION PLAT

Ft. from N. Line

583 Ft. from S. Line160 Ft. from E. Line

Ft. from W. Line

			0

Location

Rig up ☒

Drilling and Remarks:

RECORD

Cased _____ in., _____ ft.

Sand _____

Gas _____

Oil _____

Total Depth _____

PRODUCTION

1st 24 hrs. Nat. _____

1st 24 hrs. after shot _____

Gas _____ Cu. Ft.

Dry Hole _____

Abandoned _____


Date

10/27 1919

Pyle

Scout

Map No. K14 Sec. 13 Twp. 26 R. 4
 Well No. 6 Jaqueline Farm
Empire Company
 Date Started _____ Ft. from N 583 S 160 E _____ W _____ line
 NORTH

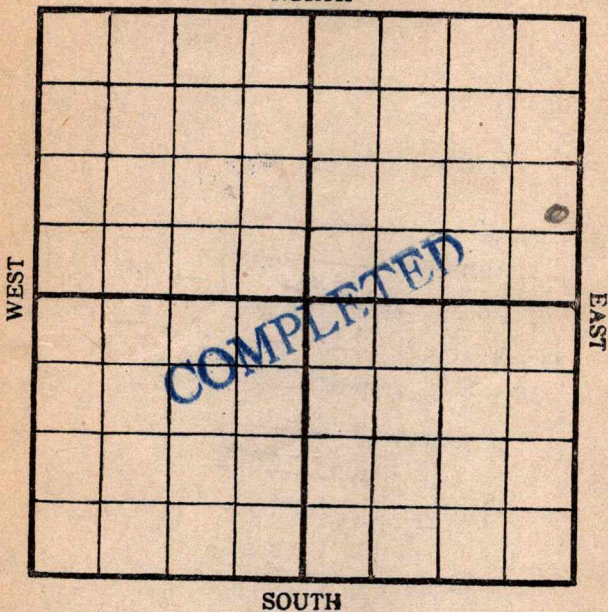

Cased _____ In. _____ Ft. _____
 Sand 2498-2507
 Pay { Gas _____
 Oil _____
 Total Depth _____

Production Remarks

27 bbls
10 day test

Condition of Well on this date _____

4/4

Pyle

Scout