


Butler

Map No. DANS Sec. 27 Twp. 26 R. 7Well No. 4 Young FarmEmpire G. & Fuel Company

NORTH

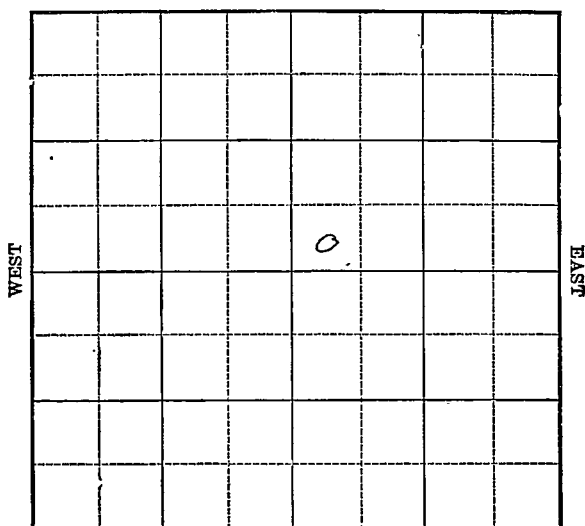

SOUTH

Location _____

Drilling Remarks _____

RECORD

Cased _____ in. _____ ft.

Sand _____

Gas _____

Oil _____

Total Depth _____

Rig Up _____

Drilling Remarks _____

PRODUCTION

1st 24 hrs. Nat. _____

1st 24 hrs. after shot _____

Gas _____ cu. ft.

Dry Hole _____

Abandoned _____

Butler Co

Map No. 14 Sec. 27 Twp. 26 R. 7

Well No. 4 Young Farm _____

Empire Gas & Fuel Company


NORTH

Ft. from N. Line

330 Ft. from S. Line

Ft. from E. Line

330 Ft. from W. Line

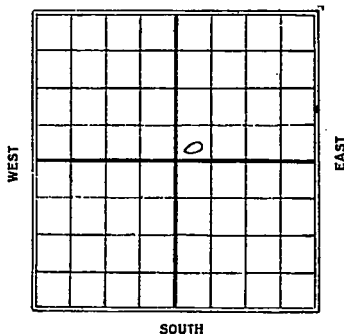

SOUTH

Date/

REPORT

Date 1926

6/30	R.O.G.
------	--------

7/8	Bldg rig
-----	----------

7/15 Rig

9/22	Dlg 350
------	---------

7/28	"	1.310
------	---	-------

8/4	11	2.110
-----	----	-------

Shs Sand 2120-2160

60/80 lbs oil 30 water

F.D. 2162

Butler
 K15 KANSAS Sec. 27 Twp. 26 R. 7
 Map No. # Young
 Well No. 6 on pit 2500 Fuel Co. Company

Contractor

FIRST REPORTS

SECTION PLAT

Ft. from N. Line

230 Ft. from S. Line

Ft. from E. Line

230 Ft. from W. Line

		o	

Location

Rig up

Drilling and Remarks:

Bo 8

RECORD

Cased _____ in., _____ ft.

Sand _____

Gas _____

Oil _____

Total Depth _____

PRODUCTION

1st 24 hrs. Nat. _____

1st 24 hrs. after shot _____

Gas _____ Cu. Ft.

Dry Hole _____

Abandoned _____

Date

JUN 30 1926

CHAS. L. SHERWOOD

192

Scout

15 **KANSAS** Sec. 27 Twp. 26 R. 7

Well No. 4 Young
Empire Gas & Oil Co. Company

Contractor

COMPLETED

SECTION PLAT

_____ Ft. from N. Line

330 _____ Ft. from S. Line

_____ Ft. from E. Line

330 _____ Ft. from W. Line

		0	

Location _____

Rig up _____

Drilling and Remarks:

600 80 18 0
30 18 10

RECORD

Cased _____ in. _____ ft.

Sand 2120 2160

Gas _____

Oil _____

Total Depth 2162

PRODUCTION

1st 24 hrs. Nat. _____

1st 24 hrs. after shot _____

Gas _____ Cu. Ft.

Dry Hole _____

Abandoned _____

Date

AUG 18 1926

192

CHAS. L. SHERWOOD

Scout