


Map No. _____ Sec. 24 Twp. 26 R. 4
Well No. 28 Richards Farm
Patton et al Company

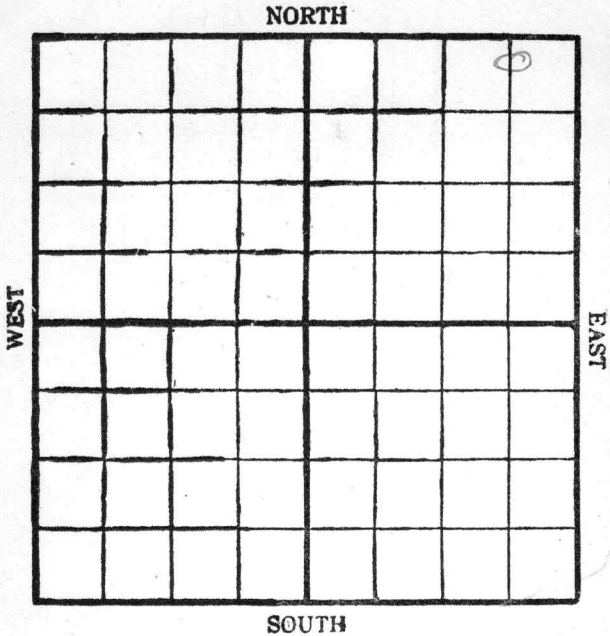

Location _____

Drilling Remarks:

RECORD

Cased _____ in. _____ ft.
Sand _____
Gas _____
Oil _____
Total Depth _____

Rig Up _____

Drilling Remarks:

PRODUCTION

1st 24 hrs. Nat. _____
1st 24 hrs. after shot _____
Gas _____ cu. ft.
Dry Hole _____
Abandoned _____

Map No. 1514 Sec. 24 Twp. 26 R. 4Well No. 281 Richards
Patton et al

Company

Contractor

NORTH

WEST

EAST

SOUTH

Location _____

Rig up ☒

Drilling and Remarks:

FIRST REPORT

RECORD

Cased _____ in., _____ ft.

Sand _____

Gas _____

Oil _____

Total Depth _____

PRODUCTION

1st 24 hrs. Nat. _____

1st 24 hrs. after shot _____

Gas _____ Cu. Ft.

Dry Hole _____

Abandoned _____


Date

11/13 191 8 Conley Scout

Map No. 114 Sec. 24 Twp. 26 R. 4Well No. 28 BelmontPatton et al CompanyPhineas & Son ContractorEdwards NORTH Kans

WEST

EAST

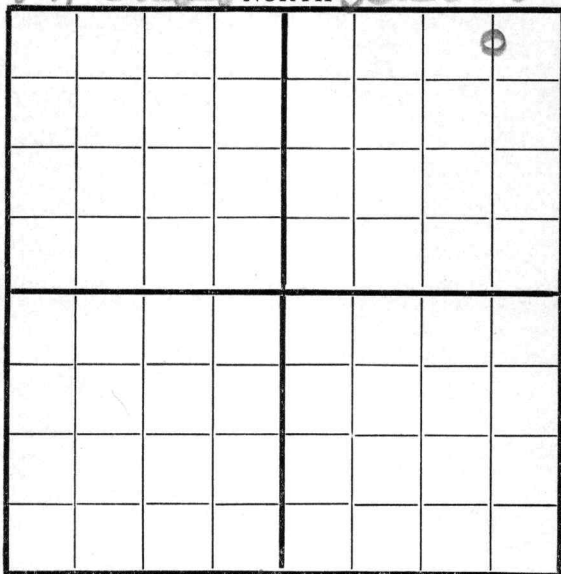

SOUTH

Location _____

Rig up _____

Drilling and Remarks:

Spudding

RECORD

Cased _____ in., _____ ft.

Sand _____

Gas _____

Oil _____

Total Depth _____

PRODUCTION

1st 24 hrs. Nat. _____

1st 24 hrs. after shot _____

Gas _____ Cu. Ft.

Dry Hole _____

Abandoned _____

Date


11/20 J. C. Candy Scout

Map No. K14 Sec. 24 Twp. 26 R. 4
 Well No. 28 Richards
Patterson et al Company
 Contractor

NORTH

WEST

EAST

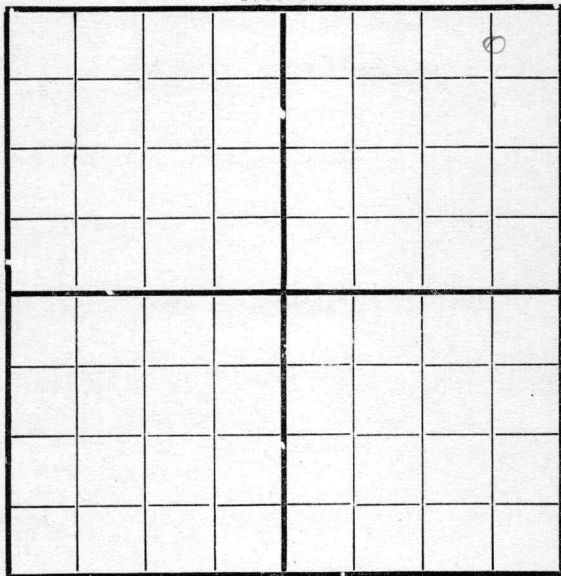

SOUTH

350 N 660 E

Location _____

Rig up _____

Drilling and Remarks:

440

RECORD

Cased _____ in., _____ ft.

Sand _____

Gas _____

Oil _____

Total Depth _____

PRODUCTION

1st 24 hrs. Nat. _____

1st 24 hrs. after shot _____

Gas _____ Cu. Ft.

Dry Hole _____

Abandoned _____


Date

11/27 1918 Conley Scout

Map No. K14 Sec. 24 Twp. 26 R. 4Well No. 28 Richards
Patton et al Company

Contractor

NORTH

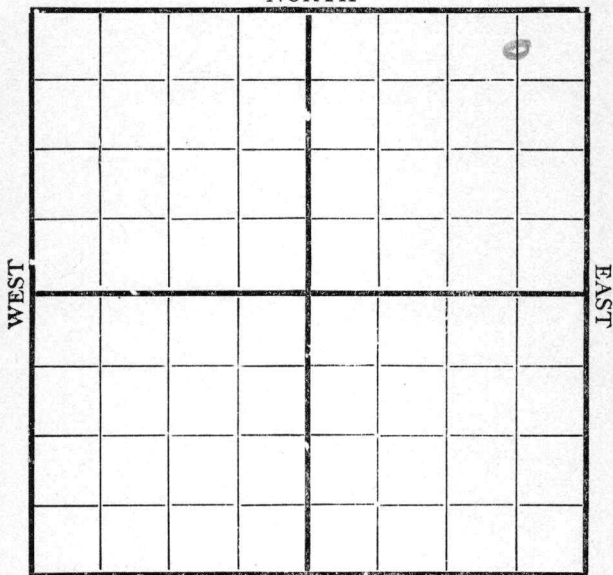

SOUTH

350 x 660

Location _____

Rig up _____

Drilling and Remarks:

800

RECORD

Cased _____ in., _____ ft.

Sand _____

Gas _____

Oil _____

Total Depth _____

PRODUCTION

1st 24 hrs. Nat. _____

1st 24 hrs. after shot _____

Gas _____ Cu. Ft.

Dry Hole _____

Abandoned _____

Date

12/4

191

J. C. Cady

Scout

Map No. K 14 Sec. 24 Twp. 26 R. 4
Well No. 28 Richardson
Patton et al Company
Contractor

NORTH							
WEST							0
SOUTH							
EAST							

200 R-660

Location _____ Rig up _____ Drilling and Remarks: <u>Set 10"</u> <u>1500</u>	RECORD Cased _____ in., _____ ft. Sand _____ Gas _____ Oil _____ Total Depth _____
	PRODUCTION 1st 24 hrs. Nat. _____ 1st 24 hrs. after shot _____ Gas _____ Cu. Ft. Dry Hole _____ Abandoned _____


Date 12/11 1918 Conley Scout

Map No. 1714 Sec. 24 Twp. 26 R. 4
Well No. 28 Richards
Patton et al Company
Contractor

NORTH

WEST

EAST

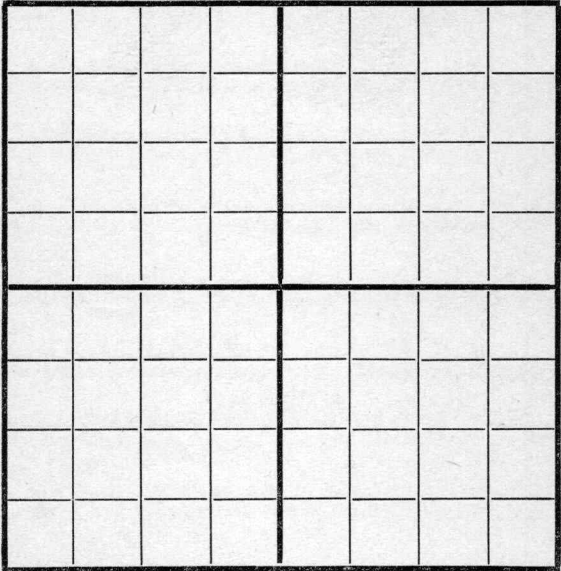

SOUTH

200 N 660 E

RECORD

Location _____

Cased _____ in., _____ ft.

Rig up _____

Sand _____

Drilling and Remarks:

Gas _____

Oil _____

Total Depth _____

2250

PRODUCTION

1st 24 hrs. Nat. _____

1st 24 hrs. after shot _____

Gas _____ Cu. Ft.


Dry Hole _____

Abandoned _____

Date

12/25 of Conroy Scout

Map No. K14 Sec. 24 Twp. 26 R. 4
Well No. 28 Richmond
Patton et al Company
Contractor

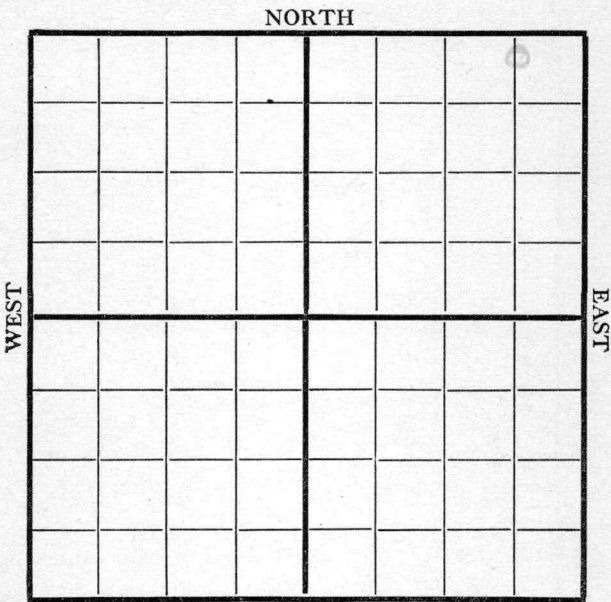

2008-660 E

Location _____ Rig up _____ Drilling and Remarks: <u>22,2250</u>	RECORD
	Cased _____ in., _____ ft. Sand _____ Gas _____ Oil _____ Total Depth _____
	PRODUCTION
	1st 24 hrs. Nat. _____ 1st 24 hrs. after shot _____ Gas _____ Cu. Ft. Dry Hole _____ Abandoned _____

Date 1/19 C. C. Casey Scout
191

Map No. K14 Sec. 24 Twp. 26 R. 4Well No. 28 Richards
Patton et al Company

Contractor

NORTH

WEST

EAST

SOUTH

Location _____

Rig up _____

Drilling and Remarks:

2340

RECORD

Cased _____ in., _____ ft.

Sand _____

Gas _____

Oil _____

Total Depth _____

PRODUCTION

1st 24 hrs. Nat. _____

1st 24 hrs. after shot _____

Gas _____ Cu. Ft.


Dry Hole _____

Abandoned _____

Date

1/8 191 P. Conroy Scout

Map No. K14 Sec. 24 Twp. 26 R. 4
Well No. 28 Richards
Patterson et al Company _____
Contractor _____

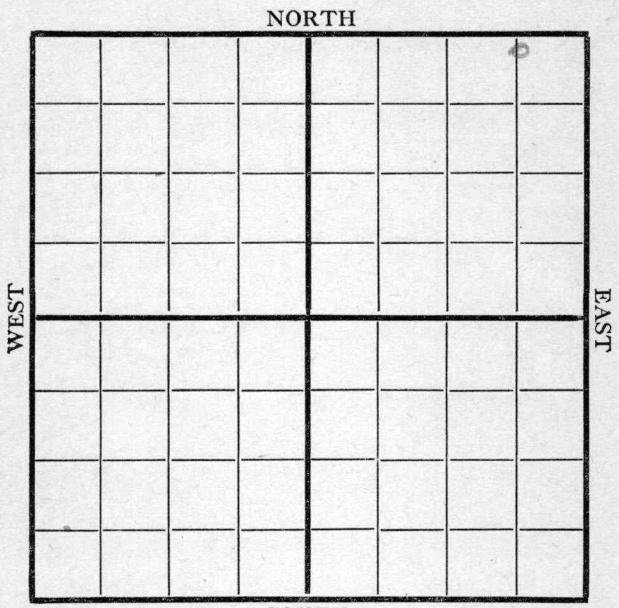

20086602

Location _____
Rig up _____
Drilling and Remarks:

2500

RECORD

Cased _____ in., _____ ft.
Sand _____
Gas _____
Oil _____
Total Depth _____

PRODUCTION

1st 24 hrs. Nat. _____
1st 24 hrs. after shot _____
Gas _____ Cu. Ft.
Dry Hole _____
Abandoned _____


Date

1/15 1919 Cummins Scout

Map No. 1514 Sec. 24 Twp. 26 R. 4Well No. 28 RichardsPatton et al Company

Contractor

NORTH

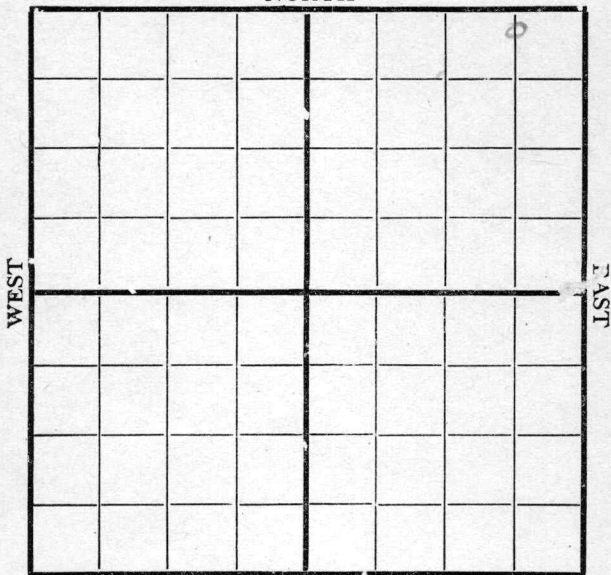

SOUTH

200 76602

Location _____

Rig up _____

Drilling and Remarks:

No Report
Lost 25 ft

RECORD

Cased _____ in., _____ ft.

Sand _____

Gas _____

Oil _____

Total Depth _____

PRODUCTION

1st 24 hrs. Nat. _____

1st 24 hrs. after shot _____

Gas _____ Cu. Ft.

Dry Hole _____

Abandoned _____

Date

722 9 Cuddy Scout


Map No. K14 Sec. 24 Twp. 26 R. 4Well No. 28 RichardsGatton et al Company

Contractor

NORTH

WEST

EAST

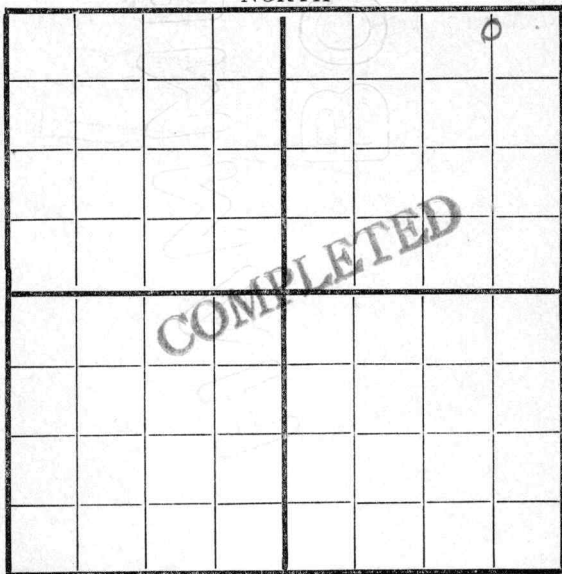

SOUTH

660 E200 N

RECORD

Location _____

Cased _____ in., _____ ft.

Rig up _____

Sand 2582 - 2593

Drilling and Remarks:

Gas _____

Oil _____

Total Depth _____

PRODUCTION

1st 24 hrs. Nat. 150 bbls

1st 24 hrs. after shot _____

Gas _____ Cu. Ft.

Dry Hole _____

Abandoned _____

Date

3/24191 9

Pyle

Scout