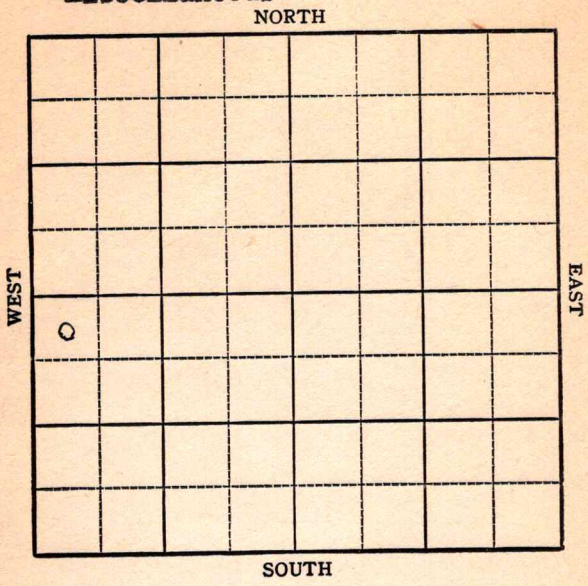


Section 13 Township 26 Range 4-E

Well No. #1 Wilke

Company Dunn & Strait
Miscellaneous



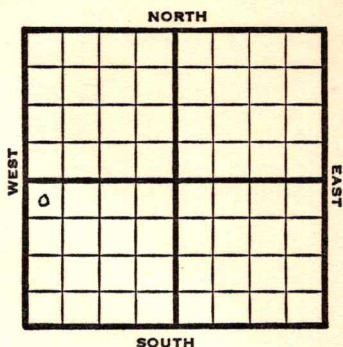
KANSAS

Butler

Sec. 13 Twp. 26 R. 4EWell No. #1 Wilke FarmDunn & Strait

Company

Miscellaneous

330' Ft. from N. Line Ft. from S. Line Ft. from E. Line330' Ft. from W. Line

NW SW

1948 **Eli 1366'** REPORT

12/1 Location

12/6 8" @ 90'
Drlg. 300'

12/14 Drlg. 2191'

12/22 **Arbuckle 2415'**
5" @ 2415'
TD 2442'12/29 40 qts.
TD 2442'
Arb 2415'
5"@ 2415'
Pump 25 oil Pot
38° Gr.
Comp**COMPLETED**

Map No. _____ Sec. 13 Twp. 26 R. 4EWell No. 1 WilkeDunn & Strait

Company

FIRST REPORT

Contractor

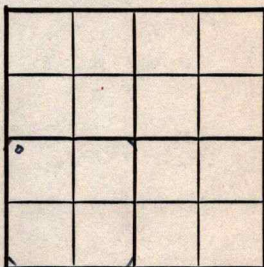
NW SW

SECTION PLAT

330 Ft. from N. Line

_____ Ft. from S. Line

_____ Ft. from E. Line

330 Ft. from W. Line

Butler County

Location _____ X

Rig up _____

Drilling and Remarks:

RECORD

Cased _____ in., _____ ft.

Sand _____

Gas _____

Oil _____

Total Depth _____

PRODUCTION

1st 24 hrs. Nat. _____

1st 24 hrs. after shot _____

Gas _____ Cu. Ft.

Dry Hole _____

Abandoned _____

Date

DEC 1 1948

19

S. J. LEWIS

Scout

Map No. 14 Sec. 13 Twp. 26 R. 4EWell No. 1 WilkeDunn & Strait

Company

COMPLETE

Contractor

NW SW

E11366
SECTION PLAT330 Ft. from N. Line Ft. from S. Line Ft. from E. Line330 Ft. from W. Line

0			

Butler CountyLocation Rig up

Drilling and Remarks:

Cr 24155" 02415Pump 25 oil Rd38° SW

RECORD

Cased in., ft.Sand Gas Oil Total Depth 2442

PRODUCTION

1st 24 hrs. Nat. 1st 24 hrs. after shot Gas Cu. Ft.Dry Hole Abandoned

Date

DEC 29 1948 19S. J. LEWIS

Scout