


Russell
 Polcyn
 El Dorado Refining Co.
 County No. 1
 Farm Company



6	5	4	3	2	1
7	8	9	10	11	12
13	14	15	16	17	18
19	20	21	22	23	24
25	26	27	28	29	30
31	32	33	34	35	36

Elev. 1901 T.D. 3400
 Date Drilled 4/14/35 5/25/35
 Correlation by

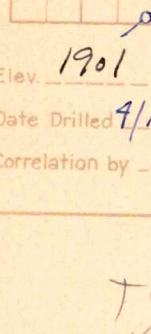