


12-54

STATE Kansas		COMPANY C. U. Bay	
COUNTY Saline	FARM Johnson	WELL NO. 1	
BLOCK	SURVEY		
SEC. 11			
T. 14	R. 4w	TOTAL DEPTH 3805	
		NE-NE-SE	
		COMMENCED	
		COMPLETED	
		REMARKS	
ALTITUDE 1252			
PRODUCTION D&A			

CASING RECORD		
DST 3757-65/hr. 30'		
Mdy. wtr. 60'slt. wtr		
BHP 1200#.		
SHOT	QUARTS	BETWEEN

FORM 186 - In stock and for sale by Ross-Martin Co., Tulsa

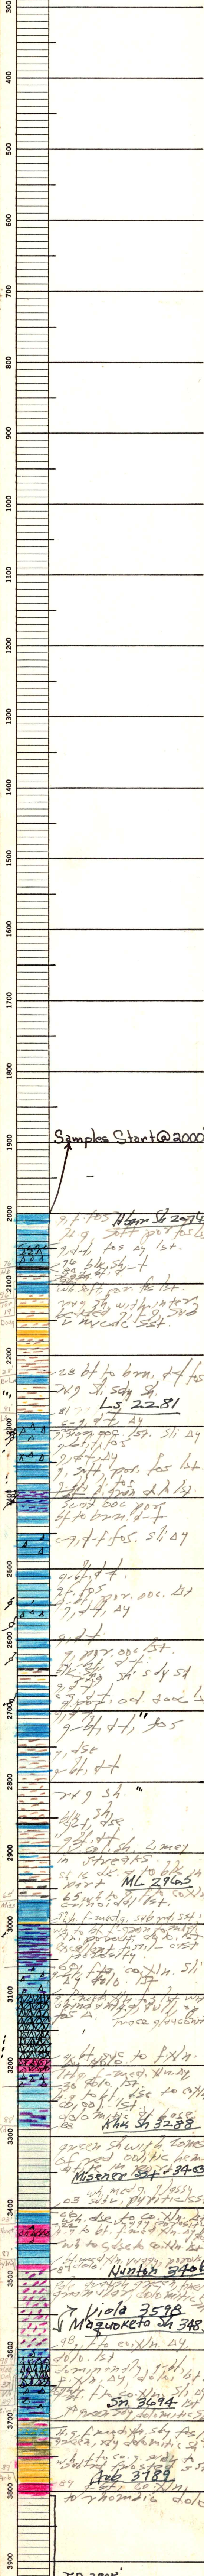

T.D. 3805