

Map No. _____ Sec. 13 Twp. 26 R. 1
 Well No. 1-Bear (Blair) Farm _____
Empire Company _____

NORTH

WEST

EAST

COMPLETED

SOUTH

Location _____

Rig Up _____

Drilling Remarks:

Drilling Remarks:

RECORD

Cased _____ in. _____ ft.

Sand _____

Gas _____

Oil _____

Total Depth _____

PRODUCTION

1st 24 hrs. Nat. _____

1st 24 hrs. after shot _____

Gas _____ cu. ft

Dry Hole _____

Abandoned _____


Map No. _____ Sec. 13 Twp. 26 R. ✓

Well No. 1. B. Cor Farm _____
Empire Company _____

NORTH

WEST

EAST

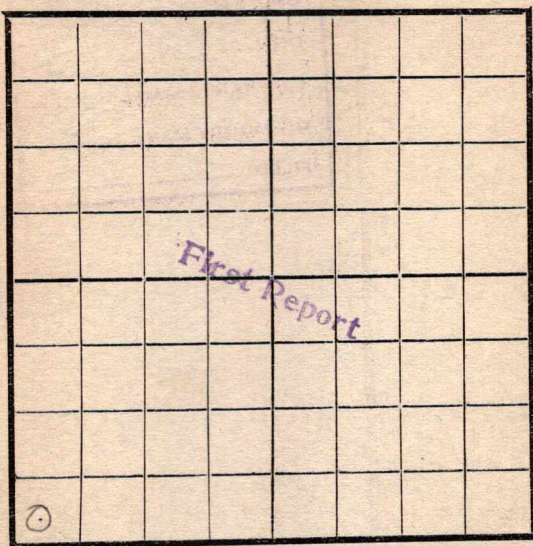

SOUTH

Location _____

Rig Up ✓ _____

Drilling and remarks _____

RECORD

Cased _____ in. _____ Ft

Sand _____

Gas _____

Oil _____

Total Depth _____

PRODUCTION

1st 24 hrs. Nat. _____

1st 24 hrs. after shot _____

Gas _____ Cu. Ft.

Dry Hole _____

Abandoned _____

Date

8-29, 1917 Lantz Scout

Map No. _____ Sec. 13 Twp. 26 R. 4Well No. 13 Farm _____
Engine Company _____

NORTH

WEST

EAST

SOUTH

Location _____

Rig Up _____

Drilling and remarks

790

RECORD

Cased _____ in. _____ Ft.

Sand _____

Gas _____

Oil _____

Total Depth _____

PRODUCTION

1st 24 hrs. Nat. _____

1st 24 hrs. after shot _____

Gas _____ Cu. Ft.

Dry Hole _____

Abandoned _____

Date

10/9, 1917 C. C. C. Scout _____

Map No. _____ Sec. 13 Twp. 26 R. 4
 Well No. 1360 Farm _____
Engine Company _____

NORTH

WEST

EAST

SOUTH

Location _____

Rig Up _____

Drilling and remarks

880'

RECORD

Cased _____ in. _____ Ft.

Sand _____

Gas _____

Oil _____

Total Depth _____

PRODUCTION

1st 24 hrs. Nat. _____

1st 24 hrs. after shot _____

Gas _____ Cu. Ft.

Dry Hole _____

Abandoned _____


Date

10/17, 1912, Condiff Scout

Map No. _____ Sec. 13 Twp. 26 R. 4Well No. 1 Blom Farm _____
Engine Company _____

NORTH

WEST

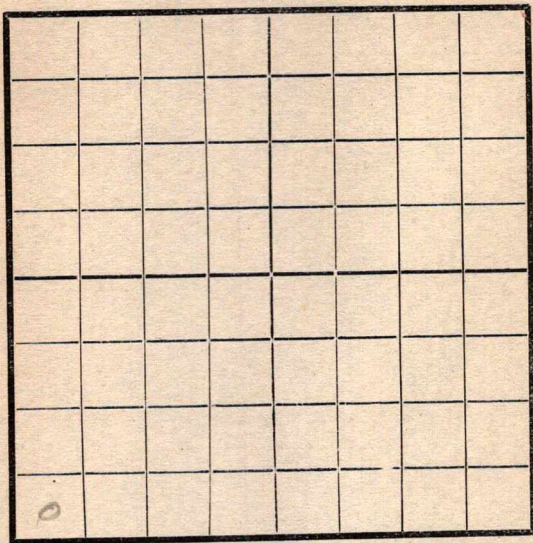

EAST

SOUTH

Location _____

Rig Up _____

Drilling and remarks

975

RECORD

Cased _____ in. _____ Ft.

Sand _____

Gas _____

Oil _____

Total Depth _____

PRODUCTION

1st 24 hrs. Nat. _____

1st 24 hrs. after shot _____

Gas _____ Cu. Ft.

Dry Hole _____

Abandoned _____

Date

10/24, 1917 2 Co. 1 Scout _____

Map No. _____ Sec. 13 Twp. 26 R. 4Well No. 1 Blom Farm _____Cummins Company _____

NORTH

WEST

EAST

SOUTH

Location _____

Rig Up _____

Drilling and remarks

AD 975

RECORD

Cased _____ in. _____ Ft.

Sand _____

Gas _____

Oil _____

Total Depth _____

PRODUCTION

1st 24 hrs. Nat. _____

1st 24 hrs. after shot _____

Gas _____ Cu. Ft.

Dry Hole _____

Abandoned _____

Date

10/31, 1917 Cummins Scout _____

Map No. _____ Sec. 13 Twp. 26 R. 4Well No. 1 Below Farm _____

Company _____

NORTH

WEST

EAST

SOUTH

Location _____

Rig Up _____

Drilling and remarks

RECORD

Cased _____ in. _____ Ft.

Sand _____

Gas _____

Oil _____

Total Depth _____

PRODUCTION

1st 24 hrs. Nat. _____

1st 24 hrs. after shot _____

Gas _____ Cu. Ft.

Dry Hole _____

Abandoned _____


Date

11-7-7 191 Condy Scout

Map No. _____ Sec. 13 Twp. 26 R. 4Well No. 1 Blor Farm _____Engine Company _____

NORTH

WEST

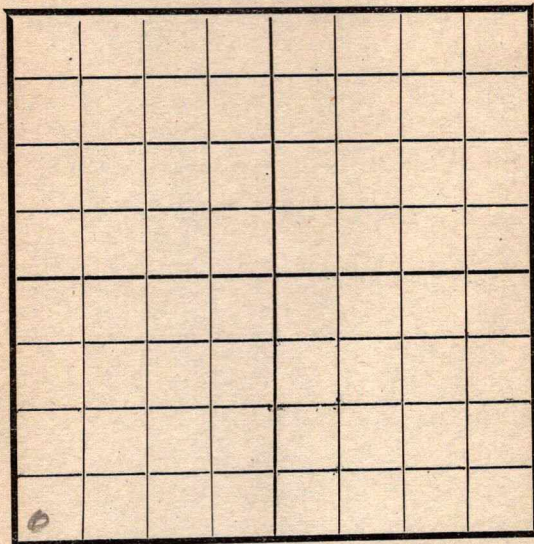

EAST

SOUTH

Location _____

Rig Up _____

Drilling and remarks

1550

RECORD

Cased _____ in. _____ Ft.

Sand _____

Gas _____

Oil _____

Total Depth _____

PRODUCTION

1st 24 hrs. Nat. _____

1st 24 hrs. after shot _____

Gas _____ Cu. Ft.

Dry Hole _____

Abandoned _____


Date

11/14, 1917 Cordiff Scout _____

Map No. _____ Sec. 13 Twp. 26 R. 4
 Well No. 1 Blain Farm _____
Engine Company _____

NORTH

WEST

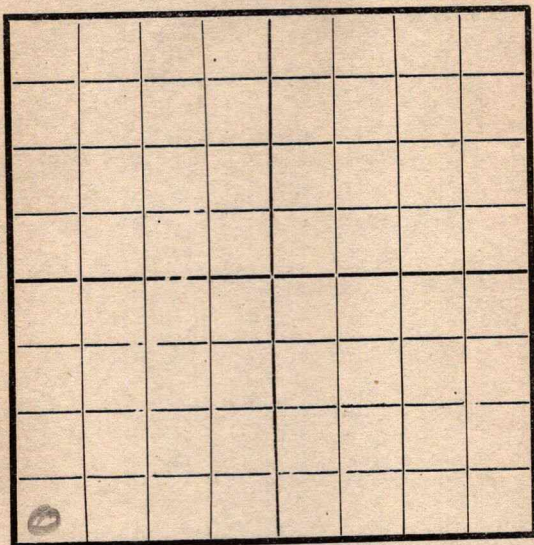

EAST

SOUTH

Location _____

Rig Up _____

Drilling and remarks

RECORD

Cased _____ in _____ Ft.

Sand _____

Gas _____

Oil _____

Total Depth _____

PRODUCTION

1st 24 hrs. Nat. _____

1st 24 hrs. after shot _____

Gas _____ Cu. Ft.

Dry Hole _____

Abandoned _____

Date

11/21, 1917 Carney Scout _____

Map No. _____ Sec. 13 Twp. 36 R. 4Well No. 136 Farm _____Engine Company _____

NORTH

WEST

EAST

SOUTH

Location _____

Rig Up _____

Drilling and remarks

1680

RECORD

Cased _____ in _____ Ft.

Sand _____

Gas _____

Oil _____

Total Depth _____

PRODUCTION

1st 24 hrs. Nat. _____

1st 24 hrs. after shot _____

Gas _____ Cu. Ft.

Dry Hole _____

Abandoned _____


Date

11/28, 1917 Carley Scout

Map No. _____ Sec. 13 Twp. 26 R. 4Well No. 1 B. L. C. Farm _____
Empire Company

NORTH

WEST

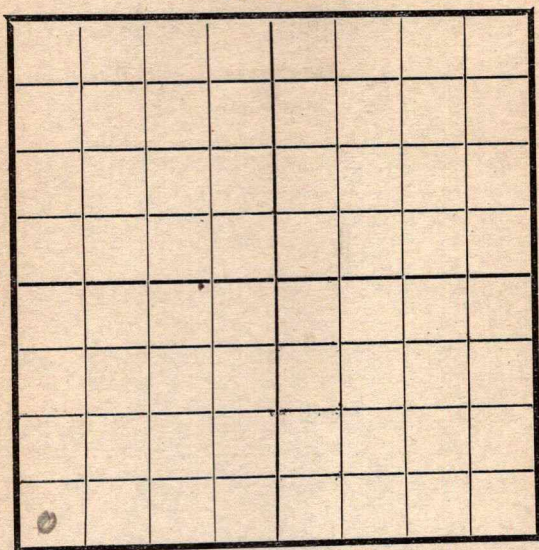

EAST

SOUTH

Location _____

Rig Up _____

Drilling and remarks

1950

RECORD

Cased _____ in. _____ Ft.

Sand _____

Gas _____

Oil _____

Total Depth _____

PRODUCTION

1st 24 hrs. Nat. _____

1st 24 hrs. after shot _____

Gas _____ Cu. Ft.

Dry Hole _____

Abandoned _____


Date

10/5, 1917 Empire Scout

Map No. _____ Sec. 13 Twp. 26 R. 4Well No. 1 Block Bloss Farm _____Engine Company _____

NORTH

WEST

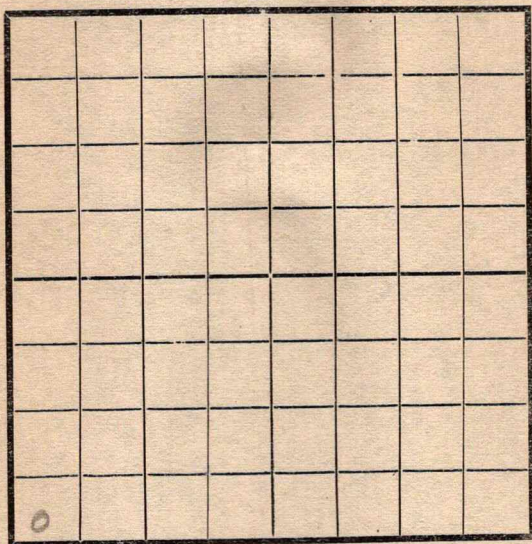

EAST

SOUTH

RECORD

Location _____

Rig Up _____

Drilling and remarks

Cased _____ in. _____ Ft.

Sand _____

Gas _____

Oil _____

Total Depth _____

PRODUCTION

1st 24 hrs. Nat. _____

1st 24 hrs. after shot _____

Gas _____ Cu. Ft.

Dry Hole _____

Abandoned _____

Date


1/2, 1918 S. Conley Scout

Map No. _____ Sec. 13 Twp. 26 R. 4
 Well No. 136 Farm _____
Carpenter Company

NORTH

WEST

EAST

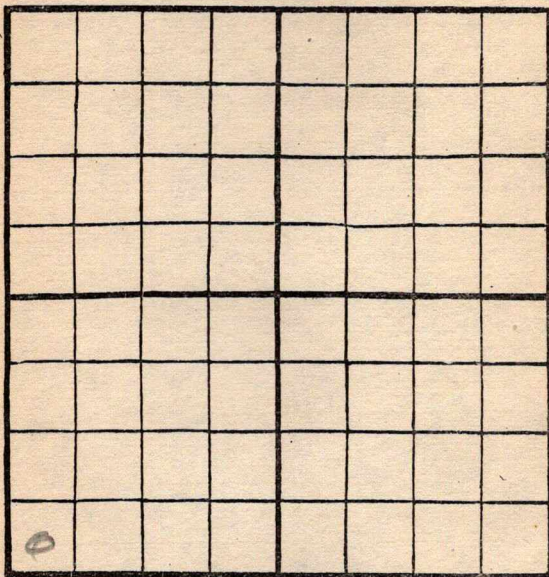

SOUTH

Location _____

Rig Up _____

Drilling and remarks

RECORD

Cased _____ in. _____ Ft.

Sand _____

Gas _____

Oil _____

Total Depth _____

PRODUCTION

1st 24 hrs. Nat. _____

1st 24 hrs. after shot _____

Gas _____ Cu. Ft.


Dry Hole _____

Abandoned _____

Date

1/16, 1918, S. C. Cady Scout

Map No. _____ Sec. 13 Twp. 26 R. 4
Well No. 1 Blor _____ Farm _____
Empire _____ Company _____
NORTH

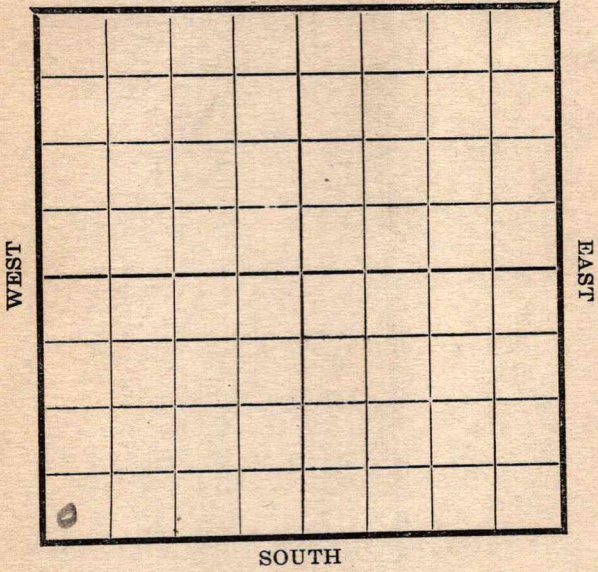

	RECORD
Location _____	Cased _____ in. _____ Ft.
Rig Up _____	Sand _____
Drilling and remarks	Gas _____
	Oil _____
	Total Depth _____
	PRODUCTION
	1st 24 hrs. Nat. _____
	1st 24 hrs. after shot _____
	Gas _____ Cu. Ft.
	Dry Hole _____
	Abandoned _____

Topsand
2330'

Date 1/23, 1918 C. Condy _____ Scout

Map No. _____ Sec. 13 Twp. 26 R. 4Well No. 136 Farm _____

_____ Company

NORTH

WEST

EAST

SOUTH

Location _____

Rig Up _____

Drilling and remarks

RECORD

Cased _____ in. _____ Ft.

Sand _____

Gas _____

Oil _____

Total Depth _____

PRODUCTION

1st 24 hrs. Nat. _____

1st 24 hrs. after shot _____

Gas _____ Cu. Ft.


Dry Hole _____

Abandoned _____

Date

1/30, 1918 Scout Scout

Map No. _____ Sec. 13 Twp. 26 R. 4
 Well No. 124 Farm _____
Empire Company _____
 Date Started _____ Ft. from N _____ S _____ E _____ W _____ line
 NORTH

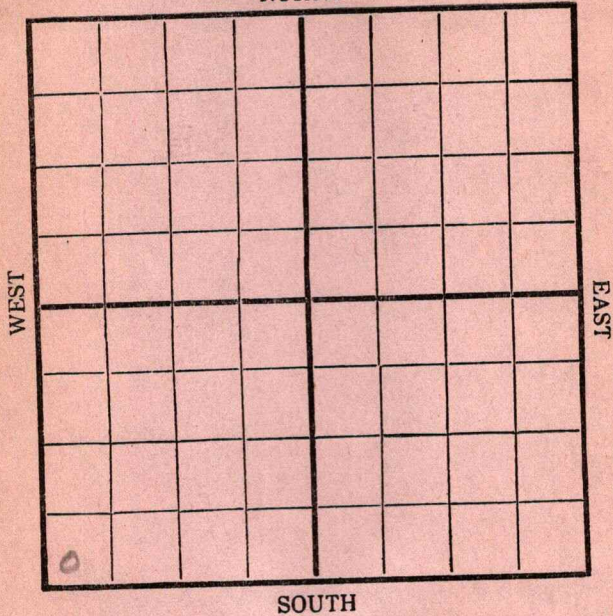

Cased _____ In. _____ Ft. _____	Production Remarks
Sand _____	
Pay { Gas _____ Oil _____	
Total Depth _____	

Condition of Well on this date 2/6/1918

Top sand 2330'

Condy

Scout

Map No. _____ Sec. 13 Twp. 26 R. 4Well No. 1360 Farm _____

_____ Company

NORTH

WEST

EAST

SOUTH

RECORD

Location _____

Cased _____ in. _____ Ft.

Rig Up _____

Sand _____

Drilling and remarks

Gas _____

Oil _____

Total Depth _____

PRODUCTION

1st 24 hrs. Nat. _____

1st 24 hrs. after shot _____

Gas _____ Cu. Ft.

Dry Hole _____

Abandoned _____

Date

2/13/1918


191

Scout

Map No. K14 Sec. 13 Twp. 26 R. 4Well No. 1360 FarmEmpire Company

NORTH

WEST

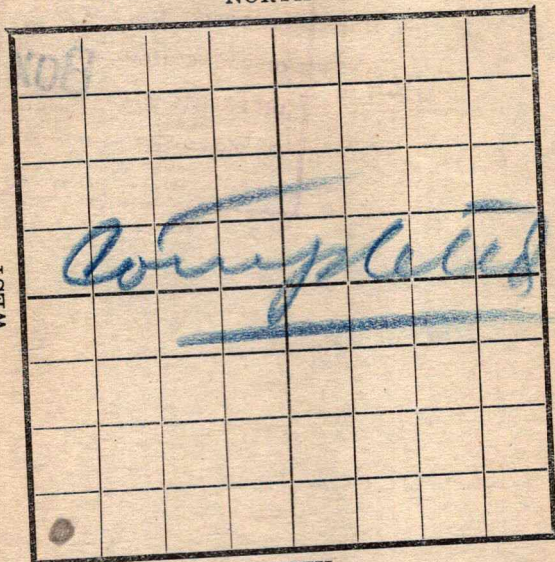

EAST

SOUTH

RECORD

Location -----

Rig Up -----

Drilling and remarks

Cased ----- in. ----- Ft.

Sand 2398-2429

Gas -----

Oil -----

Total Depth -----

PRODUCTION

1st 24 hrs. Nat. -----

1st 24 hrs. after shot -----

Gas ----- Cu. Ft.

Dry Hole -----

Abandoned -----

Date

7/20, 1918 Empire Scout