

Map No. _____ Sec. 13 Twp. 26 R. 4
 Well No. 5 Blair (Blair) Farm _____
Empire Company

NORTH

WEST

EAST



SOUTH

Location _____

Rig Up _____

Drilling Remarks:

Drilling Remarks:

RECORD

Cased _____ in. _____ ft.

Sand _____

Gas _____

Oil _____

Total Depth _____

PRODUCTION

1st 24 hrs. Nat. _____

1st 24 hrs. after shot _____

Gas _____ cu. ft

Dry Hole _____

Abandoned _____

Map No. _____ Sec. 13 Twp. 26 R. 4Well No. 5 BlonEsmeralda Company

Contractor _____

NORTH

WEST

EAST

SOUTH

Location _____

Rig up ☒

Drilling and Remarks:

RECORD

Cased _____ in., _____ ft.

Sand _____

Gas _____

Oil _____

Total Depth _____

PRODUCTION

1st 24 hrs. Nat. _____

1st 24 hrs. after shot _____

Gas _____ Cu. Ft.

Dry Hole _____

Abandoned _____

Date

6/26 1918 Candey Scout

Map No. _____ Sec. 13 Twp. 26 R. 4Well No. 5 Blow Farm _____Empire Company _____

NORTH

WEST

EAST

SOUTH

Location _____

Rig Up ☒ _____

Drilling and remarks _____

RECORD

Cased _____ in. _____ Ft.

Sand _____

Gas _____

Oil _____

Total Depth _____

PRODUCTION

1st 24 hrs. Nat. _____

1st 24 hrs. after shot _____

Gas _____ Cu. Ft.

Dry Hole _____

Abandoned _____

Date

7/13, 1918 Scout

Map No. _____ Sec. 13 Twp. 26 R. 4Well No. 5 Blain

_____ Company

_____ Contractor

NORTH

WEST

EAST

SOUTH

Location _____

Rig up ☒

Drilling and Remarks:

RECORD

Cased _____ in., _____ ft.

Sand _____

Gas _____

Oil _____

Total Depth _____

PRODUCTION

1st 24 hrs. Nat. _____

1st 24 hrs. after shot _____

Gas _____ Cu. Ft.

Dry Hole _____

Abandoned _____

Date

7/3 191 8 C. C. C. C. Scout

Map No. _____ Sec. 13 Twp. 26 R. 4Well No. 5 Blom

_____ Company

_____ Contractor

NORTH

WEST

EAST

SOUTH

Location _____

Rig up ☒ _____

Drilling and Remarks:

RECORD

Cased _____ in., _____ ft.

Sand _____

Gas _____

Oil _____

Total Depth _____

PRODUCTION

1st 24 hrs. Nat. _____

1st 24 hrs. after shot _____

Gas _____ Cu. Ft.

Dry Hole _____

Abandoned _____

Date

7/10 191 S. C. Carley Scout

Map No. _____ Sec. 13 Twp. 26 R. 4Well No. 503

Company _____

Contractor _____

NORTH

WEST

EAST

SOUTH

Location _____

Rig up ☒

Drilling and Remarks:

RECORD

Cased _____ in., _____ ft.

Sand _____

Gas _____

Oil _____

Total Depth _____

PRODUCTION

1st 24 hrs. Nat. _____

1st 24 hrs. after shot _____

Gas _____ Cu. Ft.

Dry Hole _____


Abandoned _____

Date

2/17 191 8 C. C. C. Scout

Map No. _____ Sec. 13 Twp. 26 R. 4
 Well No. 513
 _____ Company
 _____ Contractor

NORTH

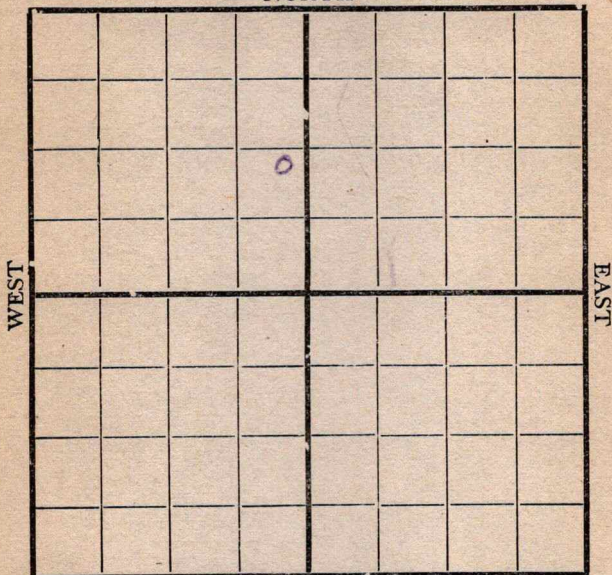

SOUTH

Location _____

Rig up ☒

Drilling and Remarks:

RECORD

Cased _____ in., _____ ft.

Sand _____

Gas _____

Oil _____

Total Depth _____

PRODUCTION

1st 24 hrs. Nat. _____

1st 24 hrs. after shot _____

Gas _____ Cu. Ft.

Dry Hole _____


Abandoned _____

Date

7/24 191 P. Cardy Scout

Map No. _____ Sec. 13 Twp. 26 R. 4Well No. 5 Blon
Empire Company _____ Contractor _____

NORTH

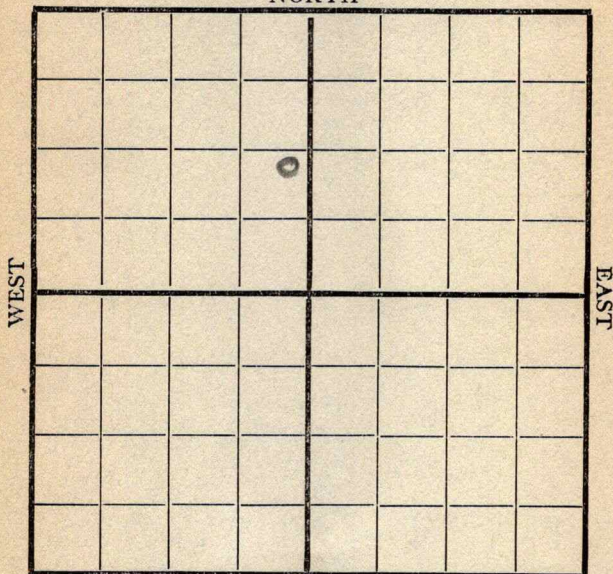

SOUTH

1120 S of L x 200 ft E Line

Location _____

Rig up ☒

Drilling and Remarks:

RECORD

Cased _____ in., _____ ft.

Sand _____

Gas _____

Oil _____

Total Depth _____

PRODUCTION

1st 24 hrs. Nat. _____

1st 24 hrs. after shot _____

Gas _____ Cu. Ft.

Dry Hole _____

Abandoned _____

Date


7/31 1918 Candy Scout

Map No. _____ Sec. 13 Twp. 26 R. 4Well No. 5 Blair

_____ Company

_____ Contractor

NORTH

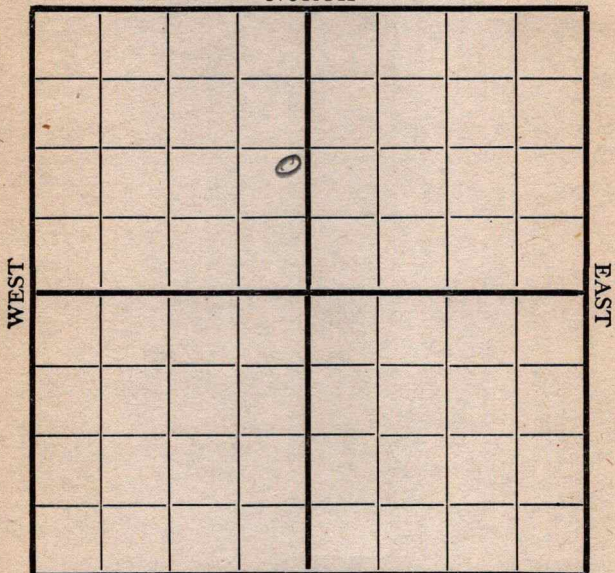

SOUTH

Location 200 E

Rig up _____

Drilling and Remarks:

RECORD

Cased _____ in., _____ f

Sand _____

Gas _____

Oil _____

Total Depth _____

PRODUCTION

1st 24 hrs. Nat. _____

1st 24 hrs. after shot _____

Gas _____ Cu. F

Dry Hole _____

Abandoned _____

Date

8/7 8 Quincy Scott

Map No. _____ Sec. 13 Twp. 26 R. 4Well No. 5 B

Company _____

Contractor _____

NORTH

WEST

EAST

SOUTH

Location 1120 S 200 E

Rig up _____

Drilling and Remarks:

490'

RECORD

Cased _____ in., _____ f

Sand _____

Gas _____

Oil _____

Total Depth _____

PRODUCTION

1st 24 hrs. Nat. _____

1st 24 hrs. after shot _____

Gas _____ Cu. F

Dry Hole _____

Abandoned _____

Date

8/13 1918


Scott

Map No. _____ Sec. 13 Twp. 26 R. 4Well No. 51360_____E. Murphy_____
Company_____
Contractor

NORTH

WEST

EAST

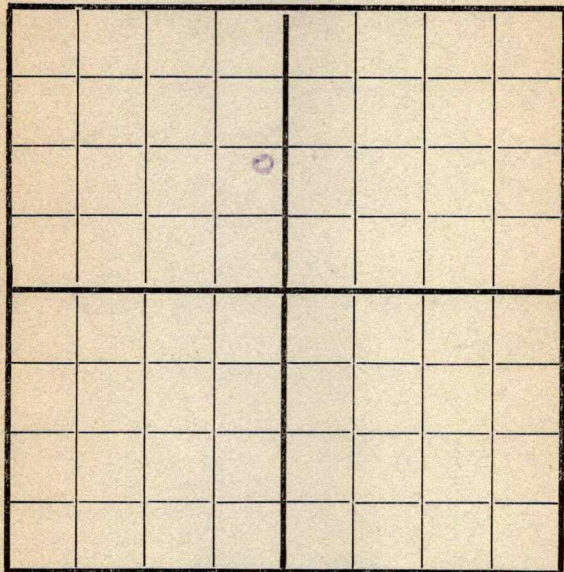

SOUTH

1120' A. - 200' E

Location _____

Rig up _____

Drilling and Remarks:

Bad hole
@
960'

RECORD

Cased _____ in., _____ ft.

Sand _____

Gas _____

Oil _____

Total Depth _____

PRODUCTION

1st 24 hrs. Nat. _____

1st 24 hrs. after shot _____

Gas _____ Cu. Ft.

Dry Hole _____

Abandoned _____

Date

8/22
1918

Pyle

Scout

Map No. 1514 Sec. 13 Twp. 26 R. 4Well No. 5 Blair


Compan

Contract

NORTH

WEST

EAST

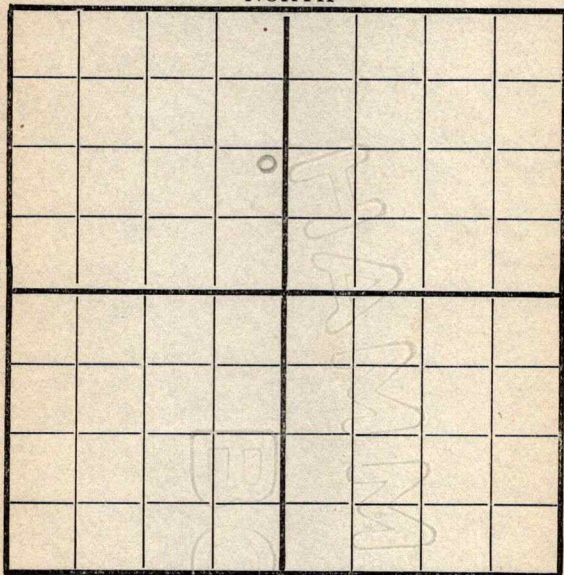

SOUTH

Location _____

Rig up _____

Drilling and Remarks:

1255

RECORD

Cased _____ in., _____ f

Sand _____

Gas _____

Oil _____

Total Depth _____

PRODUCTION

1st 24 hrs. Nat. _____

1st 24 hrs. after shot _____

Gas _____ Cu. F

Dry Hole _____

Abandoned _____

Date

8/28

191


Scou

Map No. 1514 Sec. 13 Twp. 26 R. 4

Well No. 5 Blair
Engine _____ Company _____

Contractor _____

NORTH

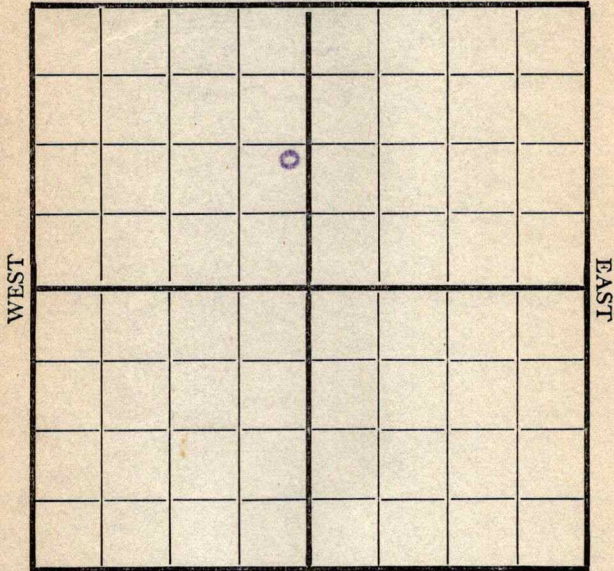

SOUTH

200 E 1100 S

Location _____ Rig up _____ Drilling and Remarks: <u>1580</u>	RECORD Cased _____ in., _____ f Sand _____ Gas _____ Oil _____ Total Depth _____
	PRODUCTION 1st 24 hrs. Nat. _____ 1st 24 hrs. after shot _____ Gas _____ Cu. F Dry Hole _____ Abandoned _____

Date 9/4 191 S. C. C. C. Score _____


Map No. 1514 Sec. 13 Twp. 26 R. 4Well No. 5 BlairEngine _____ Company _____

_____ Contractor _____

NORTH

WEST

EAST

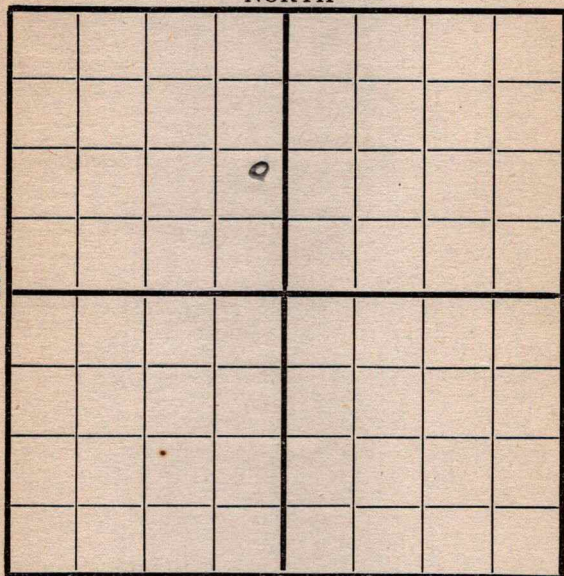11205-200E SOUTH

Location _____

Rig up _____

Drilling and Remarks:

RECORD

Cased _____ in., _____ f

Sand _____

Gas _____

Oil _____

Total Depth _____

PRODUCTION

1st 24 hrs. Nat. _____

1st 24 hrs. after shot _____

Gas _____ Cu. Ft.

Dry Hole _____

Abandoned _____

Date

9/11 1918 Combs Scout _____


Map No. 1514 Sec. 13 Twp. 26 R. 4Well No. 5 BlairCompany Engle

Contractor

NORTH

WEST

EAST

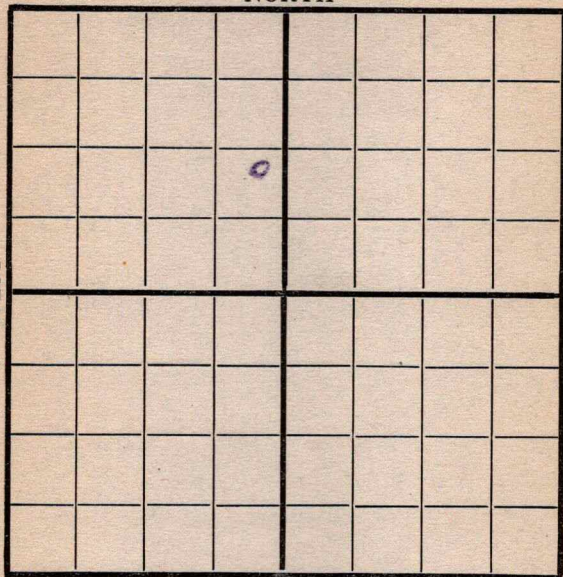

SOUTH

RECORD

Location _____

Cased _____ in., _____ f

Rig up _____

Sand _____

Drilling and Remarks:

Gas _____

Oil _____

Total Depth _____

PRODUCTION

1st 24 hrs. Nat. _____

1st 24 hrs. after shot _____

Gas _____ Cu. Ft.

Dry Hole _____

Abandoned _____

Date

9/18

191

Scout

Map No. 1514 Sec. 13 Twp. 26 R. 4Well No. 5-13-26Engine Company

Contractor

NORTH

WEST

EAST

SOUTH

1120 S - 300 E

Location

Rig up

Drilling and Remarks:

2452

RECORD

Cased _____ in., _____ ft.

Sand _____

Gas _____

Oil _____

Total Depth _____

PRODUCTION

1st 24 hrs. Nat. _____

1st 24 hrs. after shot _____

Gas _____ Cu. Ft.

Dry Hole _____

Abandoned _____

Date

9/25 191 S. Conroy Scout

Map No. 1514 Sec. 13 Twp. 25 R. 4Well No. 5-13-25Company Engelmann

Contractor

NORTH

WEST

COMPLETED

EAST

SOUTH

Location

Rig up

Drilling and Remarks:

Pumped
50 bbls
24 hrs

RECORD

Cased _____ in., _____ ft.

Sand 2456-2512

Gas _____

Oil _____

Total Depth _____

PRODUCTION

1st 24 hrs. Nat. _____

1st 24 hrs. after shot _____

Gas _____ Cu. Ft.

Dry Hole _____

Abandoned _____

Date

10/3 191 8 Conley Scout