

Butler


KANSAS

FORM 51 SM 2-38 TPCO.

Section 29 Township 26 Range 7-E


Well No. 1 Guenther "A" B

Company Rex & Morris

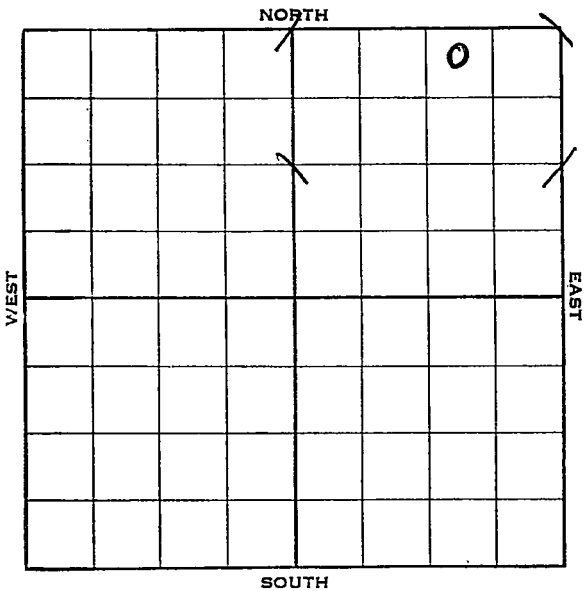

Sec. 29 Twp. 26 R. 7-EWell No. #1 Guenther-"A" FarmRex & Morris Company330 Ft. from N. Line Ft. from S. Line990 Ft. from E. Line Ft. from W. Line

Elev. 1462

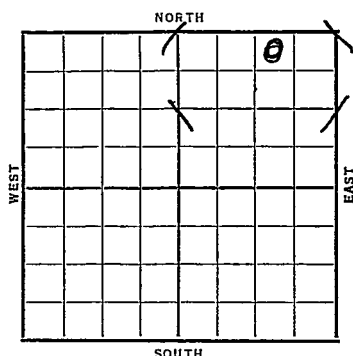

Date

REPORT

1938

7/27

Location

8/5

Dlg. 810'.

8/12

12" - 810'. 10" - 1607'.

Dlg. 1745'.

8/19

K. C. 2070'. Pay 2187-96'.

T. D. 2201'. 8" - 2186'.

8/24

8" at 2186'.

K. C. 2070'.

T. D. 2201'.

3000 acid.

50 bbls. oil.

COMPLETED

Butler KANSAS

Map No. 15 Sec. 29 Twp. 26 R. 7EWell No. 1 Guenther "A"Rex & Morris

Company

Contractor

FIRST REPORT

NW NE NE

330 Ft. from N. Line

Ft. from S. Line

990 Ft. from E. Line

Ft. from W. Line

SECTION PLAT

			0

Location X

Rig up

Drilling and Remarks:

RECORD

Cased _____ in., _____ ft.

Sand _____

Gas _____

Oil _____

Total Depth _____

PRODUCTION

1st 24 hrs. Nat. _____

1st 24 hrs. after shot _____

Gas _____ Cu. Ft.

Dry Hole _____

Abandoned _____

Date

JUL 27 1938 19H. D. Hatfield

Scout

Map No. 15 Sec. 29 Twp. 26 R. 7EWell No. 1 Guenther "A"Rex & Morris

Company

Contractor

COMPLETED

NW NE NE

330 Ft. from N. Line

_____ Ft. from S. Line

990 Ft. from E. Line

_____ Ft. from W. Line

SECTION PLAT

			0

Location _____

Rig up _____

Drilling and Remarks:

3000 acid50 oil

RECORD

Cased 8 in., 2186 ft.Sand KC 2070

Gas _____

Oil _____

Total Depth 2201

PRODUCTION

1st 24 hrs. Nat. _____

1st 24 hrs. after shot _____

Gas _____ Cu. Ft.

Dry Hole _____

Abandoned _____

Date

1

AUG 24 1936 19H. D. Hatfield Scout