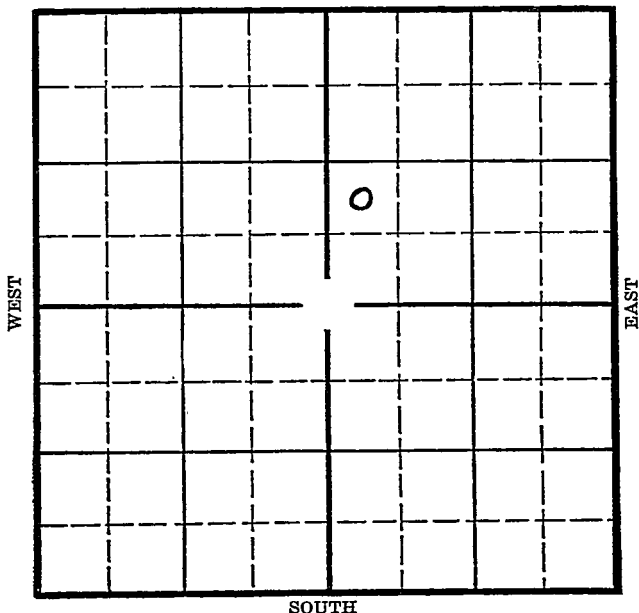


Map No. KANSAS Sec. 29 Twp. 26 R. 7E
 Well No. #3 Gunther (Guenther) Farm
Pryor & Lockhart et al Company

- NORTH



Location_____

Drilling Remarks_____

Rig Up_____

Drilling Remarks_____

RECORD

Cased_____ in. _____ ft.

Sand_____

Gas_____

Oil_____

Total Depth_____

PRODUCTION

1st 24 hrs. Nat. _____

1st 24 hrs. after shot _____

Gas_____ cu. ft. _____

Dry Hole _____

Abandoned _____

KANSAS

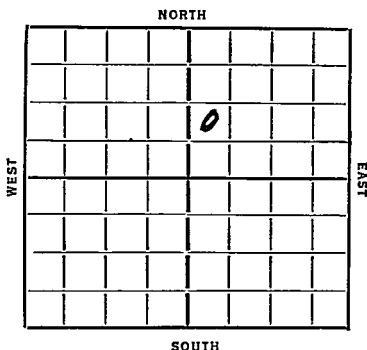
Map No. _____ Sec. 29 Twp. 26 R. 7-EWell No. 3-Gunther Farm _____

Pryor & Lockhart et al Company _____

_____ Ft. from N. Line

990 Ft. from S. Line

_____ Ft. from E. Line

330 Ft. from W. LineElev. 1463Date
1936

REPORT

4/8 Dlg. 1175

4/16 Drlg. 1925'.

4/23 Drlg. 2450'

4/30 Bart. Sand. 2605'. S.O. & G.

Top Miss. Lime. 2745'. Pay 2747-48'- 1000' oil.

5/6/36- Top Miss Lime. 2745'

Pay 2747-48'

T.D. 2748'

170 bbls Natural.

COMPLETED

Map No. 15 Sec. 29 Twp. 26 R. 7EWell No. 3 GuntherPryor & Lockhard & Co. Company

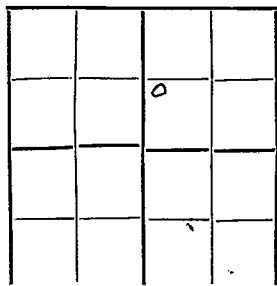
Contractor

SECTION PLAT

..... Ft. from N. Line

990 Ft. from S. Line

..... Ft. from E. Line

330 Ft. from W. Line

FIRST REPORT

Location.....

Rig up.....

Drilling and Remarks:

1175 Drilling

RECORD

Cased.....in.,ft.

Sand.....

Gas.....

Oil.....

Total Depth.....

PRODUCTION

1st 24 hrs. Nat.....

1st 24 hrs. after shot.....

Gas.....Cu. Ft.

Dry Hole.....

Abandoned.....

Date

4/8/36 192.....

S. J. J. J. J.

Scout

Map No. 15 Sec. 29 Twp. 26 R. 24Well No. 3 GuntherShirley - Pryor & Lockhart Company
Contractor

SECTION PLAT

		0	

 Ft. from N. Line990 Ft. from S. Line Ft. from E. Line930 Ft. from W. Line

COMPLETED

Location Rig up

Drilling and Remarks:

Top of Gas Line
2745
Pay 2747-48
170 88 lb. Nat.

RECORD

Cased in., ft.Sand Gas Oil Total Depth 2748

PRODUCTION

1st 24 hrs. Nat. 1st 24 hrs. after shot Gas Cu. Ft.Dry Hole Abandoned

Date

MAY19

S. J. LEWIS

Scout