

KANSAS


Butler

Form 51-5M-436-Palace

Section 29 Township 26 Range 7-E

Well Number #4 Gunther (*Guenther*)

Company Slick, Pryor & Lockhart

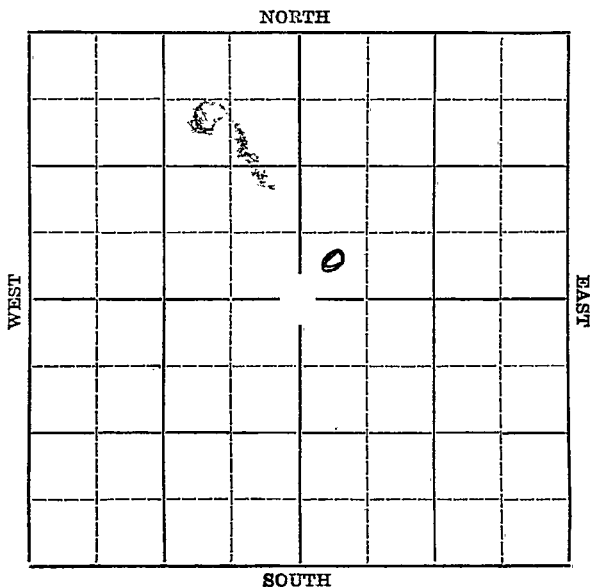

Sec. 29 Twp. 26 R. 7EWell No. #4 Gunther FarmSlick Bryl & Lockhart Company


Ft. from N. Line

330' Ft. from S. Line

Ft. from E. Line

330' Ft. from W. Line

Elev. 1463

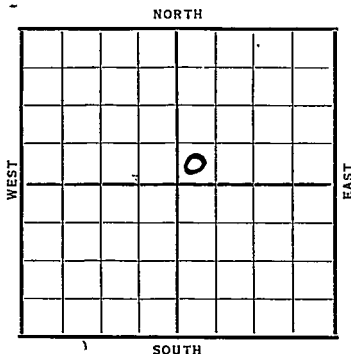~~1936~~

REPORT

10/28 Machine 630'.

11/6 12" @ 855 Drlg. 1475

11/12 10" @ 1623 Drlg. 2200

11/19 Bart. Sd. 2605-30

Mississippi lime 2750'. set 6"

Pay 2750-54'. water 2820

Plug back 2755'.

11/27 Shut down.

12/2 Bart. Sd. 2605'. Miss. L. 2750'.

Pay 2750-54'. T. D. 2820'.

P. B. 2755'. 2000 acid.

Pot. 130 oil & 20 water.

COMPLETED

KANSAS

Form 26-1M-Bks.-2-29

Map No. 15 Sec. 29 Twp. 26 R. 26Well No. 4 GuntherShick, Pryor & Lockhart Company
Contractor

SECTION PLAT

		0	

 Ft. from N. Line330 Ft. from S. Line Ft. from E. Line330 Ft. from W. Line

FIRST REPORT

Location Rig up

Drilling and Remarks:

Mach 630

RECORD

Cased in., ft.Sand Gas Oil Total Depth

PRODUCTION

1st 24 hrs. Nat. 1st 24 hrs. after shot Gas Cu. Ft.Dry Hole Abandoned

Date

OCT 22 1936 19S. J. LEWIS

Scout

KANSAS

Map No. 15 Sec. 29 Twp. 26 R. 7EWell No. 4 GuntherSlick, Pryor & Lockhart Company

Contractor

SECTION PLAT

		0	

11 Ft. from N. Line330 Ft. from S. Line Ft. from E. Line330 Ft. from W. Line

COMPLETED

Location Rig up

Drilling and Remarks:

Bar 8. & 2605Mis 42750 -Pay 2750 54P.B. 27552000 acidProd 180 oil 20 Water

RECORD

Cased in., ft.Sand Gas Oil Total Depth 2830

PRODUCTION

1st 24 hrs. Nat. 1st 24 hrs. after shot Gas Cu. Ft.Dry Hole Abandoned

Date

DEC 2 1936 19

S. J. LEWIS Scout