


Map No. _____ Sec. 13 Twp. 26 R. 4
 Well No. 18 Blow Farm _____
 _____ Empire Company

NORTH

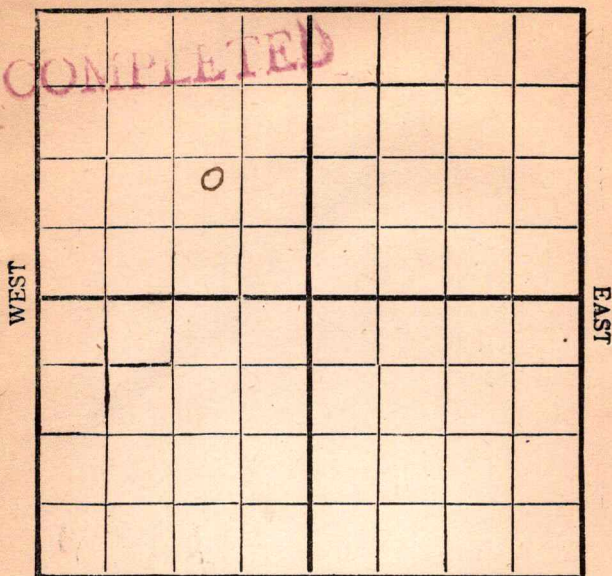

SOUTH

Location _____

Rig Up _____

Drilling Remarks:

Drilling Remarks:

RECORD

PRODUCTION

Cased _____ in. _____ ft.

1st 24 hrs. Nat. _____

Sand _____

1st 24 hrs. after shot _____

Gas _____

Gas _____ cu. ft.

Oil _____

Dry Hole _____

Total Depth _____

Abandoned _____

Map No. K14 Sec. 13 Twp. 26 R. H
 Well No. 18 Blois
Empire Company
 Contractor

NORTH

SOUTH

WEST

EAST

FIRST REPORT

1525 N

SOUTH

960 E

Location _____

Rig up. ☒

Drilling and Remarks:

RECORD

Cased _____ in., _____ ft.

Sand _____

Gas _____

Oil _____

Total Depth _____

PRODUCTION

1st 24 hrs. Nat. _____

1st 24 hrs. after shot _____

Gas _____ Cu. Ft.

Dry Hole _____

Abandoned _____

Date

Pyle

1919

Scout

27

Map No. K14 Sec. 13 Twp. 26 R. 4
 Well No. 18 Bloir
Empire Company
 Contractor

SECTION PLAT

1525 Ft. from N. Line

_____ Ft. from S. Line

960 Ft. from E. Line

_____ Ft. from W. Line

	0		

COMPLETED

RECORD

Location _____

Rig up _____

Drilling and Remarks:

75 bbls
in 10 hrs

Cased _____ in., _____ ft.

Sand 2390 - 2405

Gas _____

Oil _____

Total Depth _____

PRODUCTION

1st 24 hrs. Nat. _____

1st 24 hrs. after shot _____

Gas _____ Cu. Ft.

Dry Hole _____

Abandoned _____

Date

9/19 1919

Pyle

Scout