


Map No. 714 Sec. 13 Twp. 26 R. 4
Well No. 20 Blair Farm _____
Empire Company _____

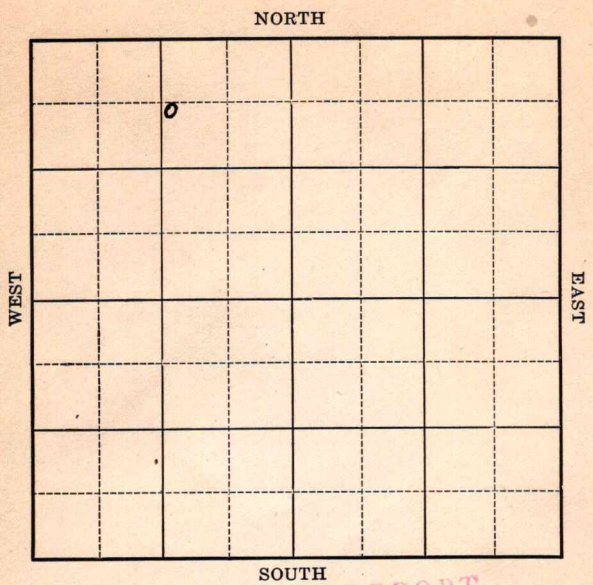

FIRST REPORT
COMPLETED

Location _____
Drilling Remarks: _____


RECORD

Cased _____ in. _____ ft.
Sand _____
Gas _____
Oil _____
Total Depth _____

Rig Up _____
Drilling Remarks: _____

PRODUCTION

1st 24 hrs. Nat. _____
1st 24 hrs. after shot _____
Gas _____ cu. ft.
Dry Hole _____
Abandoned _____

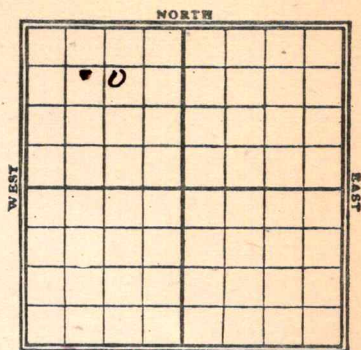Map No. T. 14 Sec. 13 Twp. 26 R. 4Well No. 2030 Blair Farm
Empire Company670 Ft. from N. Line Ft. from S. Line1054 Ft. from E. Line1054 Ft. from W. Line

FIRST REPORT

REPORT

1900

7/13

9/17

Lilly @ 1250

2364-72-7375

40 bbls.

COMPLETED

Map No. K14 Sec. 13 Twp. 26 R. 4Well No. 20 BlairEmpire Company

Contractor

SECTION PLAT

670 Ft. from N. Line

Ft. from S. Line

1054 Ft. from E. Line1054 Ft. from W. Line

	o		

FIRST REPORT

Location

Rig up

Drilling and Remarks:

Dlq C
1280'

RECORD

Cased _____ in., _____ ft

Sand _____

Gas _____

Oil _____

Total Depth _____

PRODUCTION

1st 24 hrs. Nat. _____

1st 24 hrs. after shot _____

Gas _____ Cu. Ft

Dry Hole _____

Abandoned _____

Date

8/25 19120

Pyle

Scout

Map No. K14 Sec. 13 Twp. 26 R. 4Well No. 20 BloirEmpire Company

Contractor

SECTION PLAT

670 Ft. from N. Line

Ft. from S. Line

1054 Ft. from E. Line

Ft. from W. Line

Location

Rig up

Drilling and Remarks:

RECORD

Cased _____ in., _____ ft.

Sand 2364-72

Gas _____

Oil _____

Total Depth 2375

PRODUCTION

1st 24 hrs. Nat. 40 bbls

1st 24 hrs. after shot _____

Gas _____ Cu. Ft.

Dry Hole _____

Abandoned _____

Date

9/17 1910

Pyle

Scout