

Butler

Section 13 Township 26 Range 4-E

Well No. 22 Bolir (B/oir)

Company Cities Service

Miscellaneous

NORTH

WEST

EAST

	o						

SOUTH

KANSAS

Sec. 13 Twp. 26 R. 4EWell No. #22Bolir Farm

Cities Service

Company

Misc.


Ft. from N. Line

990 Ft. from S. Line

Ft. from E. Line

990 Ft. from W. Line

NE SW NW

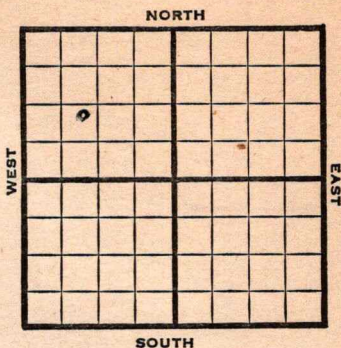

1947 Elev. 1361' REPORT

10/8 8" @ 87'
WOC

10/15 "

10/22 Arbuckle 2380
5" @ 2382 TD 2385
1610' oil 12 hrs11/5 Arbuckle 2380'
5" @ 2382'
Pump 100 P_o t
Gr. 380_o
Total Depth 2385'

COMPLETED

Map No. _____ Sec. 13 Twp. 26 R. 4E

Well No. 22 Bolir

Cities Service Company

FIRST REPORT Contractor

NE SW NW

SECTION PLAT

_____ Ft. from N. Line

990 Ft. from S. Line

_____ Ft. from E. Line

990 Ft. from W. Line

0			

Butler County

Location _____

Rig up _____

Drilling and Remarks:

8" @ 87 WOC

RECORD

Cased _____ in., _____ ft.

Sand _____

Gas _____

Oil _____

Total Depth _____

PRODUCTION

1st 24 hrs. Nat. _____

1st 24 hrs. after shot _____

Gas _____ Cu. Ft.

Dry Hole _____

Abandoned _____

Date

OCT 8 1947 19

S. J. LEWIS

Scout


Kansas

Map No. 14 Sec. 13 Twp. 26 R. 4EWell No. 22 BolirCities Service Company

COMPLETE

Contractor

NW SW NW

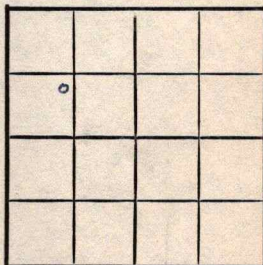E11861
SECTION PLAT Ft. from N. Line990 Ft. from S. Line Ft. from E. Line990 Ft. from W. Line

Butler County

Location Rig up

Drilling and Remarks:

CEL 23805" @ 2382Pump 1000 ft38 ft

RECORD

Cased in., ft.Sand Gas Oil Total Depth 2385

PRODUCTION

1st 24 hrs. Nat. 1st 24 hrs. after shot Gas Cu. Ft.Dry Hole Abandoned

Date

NOV 5 1947

19

S. J. LEWIS

Scout