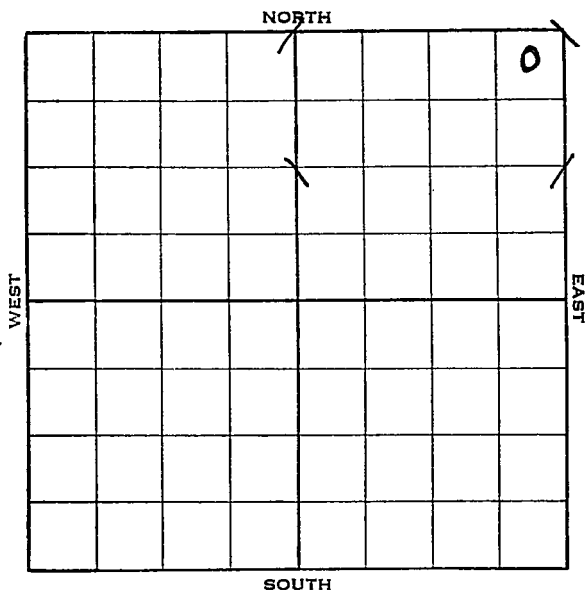


Butler

KANSAS


Section 29 Township 26 Range 7-EWell No. 2 Guenther "B"Company Rex & Morris

KANSAS

Butler

Sec. 29 Twp. 26 R. 7-EWell No. #2 Guenther "B" FarmRex & Morris Company330 Ft. from N. Line       Ft. from S. Line330 Ft. from E. Line       Ft. from W. Line

Elev. 1453

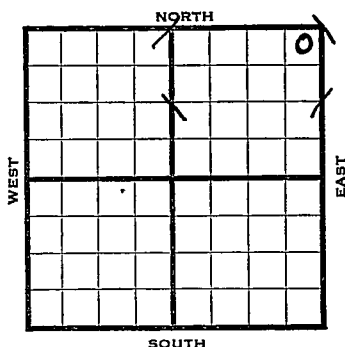

| 1938  | REPORT                                |
|-------|---------------------------------------|
| 8/31  | Mat'l.                                |
| 9/9   | 12 $\frac{1}{2}$ " - 992'. Dlg. 975'. |
| 9/16  | 10" - 1605'. Lans. 1760'.             |
|       | Dlg. 1785'.                           |
| 9/23  | K. C. 2060'. 8" - 2280'.              |
|       | Dlg. 2420'.                           |
| 9/30  | Miss. 2729'. S.O. 2732-40'.           |
|       | Dlg. 2746'.                           |
| 10/7  | 6" - 2731'. Pay 2735-46'.             |
|       | T. D. 2817'. 1 bbl. oil per hr.       |
| 10/12 | 6" at 2731'.                          |
|       | Miss. 2729'.                          |
|       | T. D. 2817'.                          |
|       | 2000 acid.                            |
|       | 30 bbls.                              |
|       | COMPLETED                             |

Butler KANSAS

Map No. 15 Sec. 29 Twp. 26 R. 7EWell No. 2 Guenther "B" (originally reported as "A" Lease)Rex & Morris

Company


Contractor

## FIRST REPORT

NE/C

330 Ft. from N. Line       Ft. from S. Line330 Ft. from E. Line       Ft. from W. Line

## SECTION PLAT

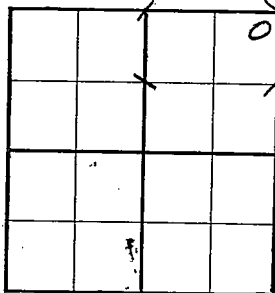Location                                 Rig up                                 

Drilling and Remarks:

Matl.

## RECORD

Cased            in.,            ft.Sand                                 Gas                                 Oil                                 Total Depth                                 

## PRODUCTION

1st 24 hrs. Nat.                                 1st 24 hrs. after shot                                 Gas                                  Cu. Ft.Dry Hole                                 Abandoned                                 

Date

AUG 31 1938

19

H. D. Hatfield Scout

Butler

Map No. 15 Sec. 29 Twp. 26 R. 7EWell No. 2 Guenther "B"Rex & Morris

Company

Contractor

**COMPLETED**

NE/C

## SECTION PLAT

|  |  |  |   |
|--|--|--|---|
|  |  |  | 0 |
|  |  |  |   |
|  |  |  |   |
|  |  |  |   |

330 Ft. from N. Line       Ft. from S. Line330 Ft. from E. Line       Ft. from W. LineLocation       Rig up       

Drilling and Remarks:

*2000 acid**30 bbl/s*

## RECORD

Cased 6 in., 2731 ft.Sand MISS 2729Gas       Oil       Total Depth 2817

## PRODUCTION

1st 24 hrs. Nat.       1st 24 hrs. after shot       Gas        Cu. Ft.Dry Hole       Abandoned       

Date

OCT 12 1938

19

H. D. Hatfield

Scout