

KANSAS


Butler

Section 13 Township 26 Range 4E

Well No. #23 Blair

Company Cities Service

Miscellaneous

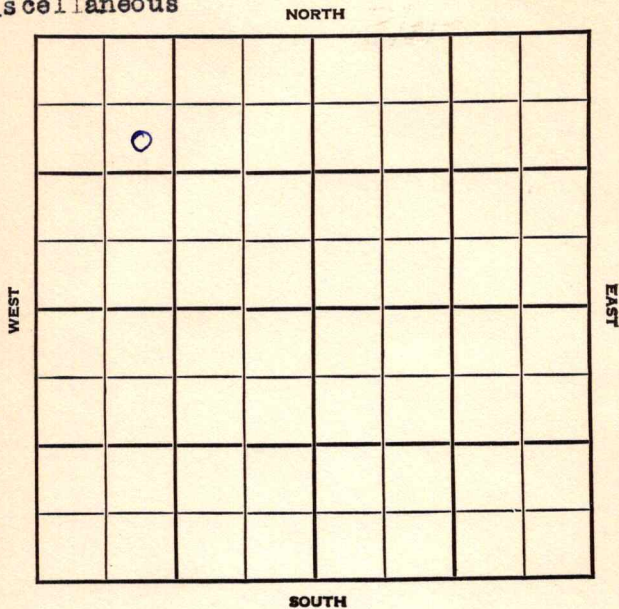

KANSAS

Butler

Sec. 13 Twp. 26 R. 4EWell No. #23 Bloir Farm _____

Cities Service

Company _____

Miscellaneous


990' Ft. from N. Line

_____ Ft. from S. Line

_____ Ft. from E. Line

990' Ft. from W. Line

SE NW NW

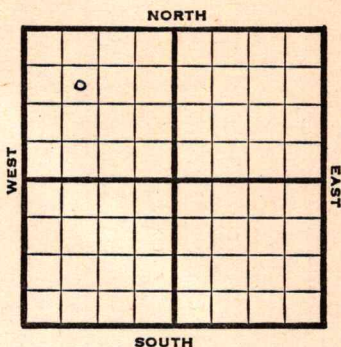

1948

Elev. 1386' REPORT

2/11 10" @ 88'
Drlg. 1058'

2/18 Lansing 1689'
KC 1977'
Arbuckle 2382'
TD 2385'
7" @ 2382'
RUST

2/25 TD 2391'
 $\frac{1}{2}$ bbls. oil PH

3/3 250 Acid

3/10 "

3/17 "

3/24 Arbuckle 2382'
7" @ 2382'
Pump 32 Pot.
Gr. 38°
TD 2391'

COMPLETED

Map No. _____ Sec. 13 Twp. 26 R. 4EWell No. 23 Blair

_____ Cities Service _____ Company

_____ FIRST REPORT _____ Contractor

SE NW NW

SECTION PLAT

o			

990 Ft. from N. Line

_____ Ft. from S. Line

_____ Ft. from E. Line

990 Ft. from W. Line

Butler County

Location _____

Rig up _____

Drilling and Remarks:

10" @ 88

drlg. 1058

RECORD

Cased _____ in., _____ ft.

Sand _____

Gas _____

Oil _____

Total Depth _____

PRODUCTION

1st 24 hrs. Nat. _____

1st 24 hrs. after shot _____

Gas _____ Cu. Ft.

Dry Hole _____

Abandoned _____

Date

FEB 1 1 1948

19

S. J. LEWIS

Scout

Map No. 14 Sec. 13 Twp. 26 R. 4E

Well No. 23 Blair

Cities Service

Company

COMPLETE

Contractor

SE NW NW

E. 1. 1386.
SECTION PLAT

990 Ft. from N. Line

_____ Ft. from S. Line

_____ Ft. from E. Line

990 Ft. from W. Line

0			

Butler County

Location _____

Rig up _____

Drilling and Remarks:

Cr 2382

7" 2382

Pring 2382

38-2

RECORD

Cased _____ in., _____ ft.

Sand _____

Gas _____

Oil ☒

Total Depth 2381

PRODUCTION

1st 24 hrs. Nat. _____

1st 24 hrs. after shot _____

Gas _____ Cu. Ft.

Dry Hole _____

Abandoned _____

Date

MAR 24 1948

19

S. J. LEWIS

Scout