


Map No. _____ Sec. 21 Twp. 26 R. 4
 Well No. 1- Waite Farm _____
(Eastern parties) Company _____

NORTH

WEST

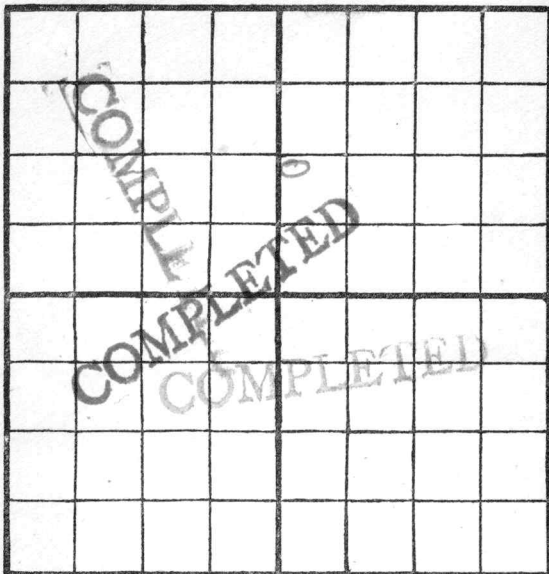

EAST

SOUTH

Location _____

Drilling Remarks:

Dry & Abandoned
6/14/18

Rig Up _____

Drilling Remarks:

2545 ft

RECORD

Cased _____ in. _____ ft.
 Sand _____
 Gas _____
 Oil _____
 Total Depth _____

PRODUCTION

1st 24 hrs. Nat. _____
 1st 24 h.s. after shot _____
 Gas _____ cu. ft
 Dry Hole _____
 Abandoned _____

Map No. _____ Sec. 21 Twp. 26 R. 4
 Well No. 1 Waite Farm _____
(Eastern Partners) Company _____

NORTH

WEST

EAST

FIRST REPORT

SOUTH

Location _____

Rig Up ☒ _____

Drilling and remarks

Could not
find out
who owns
This rig.

RECORD

Cased _____ in. _____ Ft.

Sand _____

Gas _____

Oil _____

Total Depth _____

PRODUCTION

1st 24 hrs. Nat. _____

1st 24 hrs. after shot _____

Gas _____ Cu. Ft.

Dry Hole _____

Abandoned _____


Date

10/9, 1917, Candys Scout

Map No. _____ Sec. 21 Twp. 26 R. 4Well No. 1 Waite Farm _____
Price et al Company _____

NORTH

WEST

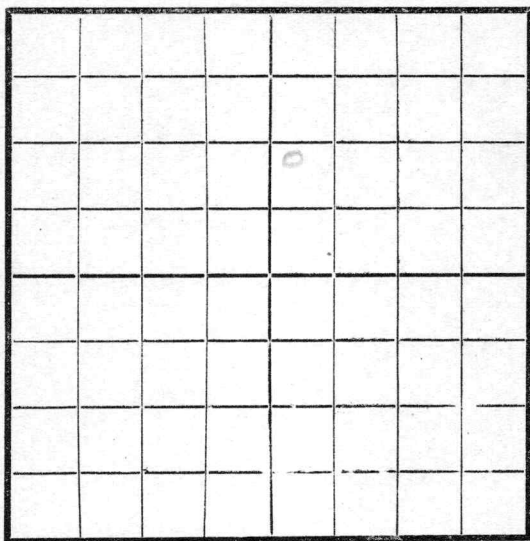

EAST

SOUTH

Location _____

Rig Up _____

Drilling and remarks _____

RECORD

Cased _____ in. _____ Ft.

Sand _____

Gas _____

Oil _____

Total Depth _____

PRODUCTION

1st 24 hrs. Nat. _____

1st 24 hrs. after shot _____

Gas _____ Cu. Ft.

Dry Hole _____

Abandoned _____


Date

10/31, 1917 Cordell Scout _____

Map No. _____ Sec. 21 Twp. 26 R. 4
 Well No. 1 White _____ Farm
Price et al _____ Company

NORTH

WEST

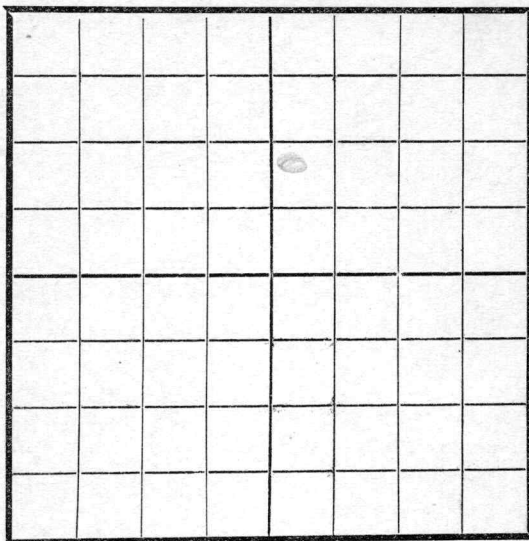

EAST

SOUTH

Location _____

Rig Up ☒ _____

Drilling and remarks _____

RECORD

Cased _____ in. _____ Ft.

Sand _____

Gas _____

Oil _____

Total Depth _____

PRODUCTION

1st 24 hrs. Nat. _____

1st 24 hrs. after shot _____

Gas _____ Cu. Ft.

Dry Hole _____

Abandoned _____

Date

11-7, 1917 Price et al _____ Scout

Map No. _____ Sec. 21 Twp. 26 R. 4Well No. 1 White Farm
Kansas City - Duluth Company

NORTH

WEST

EAST

SOUTH

Location _____

Rig Up ☒ _____

Drilling and remarks

RECORD

Cased _____ in _____ Ft.

Sand _____

Gas _____

Oil _____

Total Depth _____

PRODUCTION

1st 24 hrs. Nat. _____

1st 24 hrs. after shot _____

Gas _____ Cu. Ft.

Dry Hole _____

Abandoned _____


Date

11-14, 1917 Conley Scout

Map No. _____ Sec. 21 Twp. 26 R. 4

Well No. 1 Waite Farm
Kansas City Drilling Company

NORTH

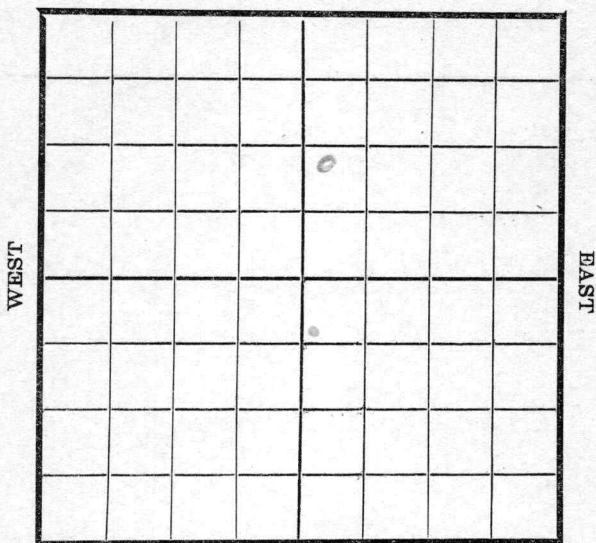

SOUTH

Location _____
 Rig Up ☒ _____
 Drilling and remarks _____

RECORD

Cased _____ in _____ Ft.
 Sand _____
 Gas _____
 Oil _____
 Total Depth _____

PRODUCTION


1st 24 hrs. Nat. _____
 1st 24 hrs. after shot _____
 Gas _____ Cu. Ft.
 Dry Hole _____
 Abandoned _____

Date

11/21, 1917 Carley Scout

Map No. _____ Sec. 21 Twp. 26 R. 4Well No. 1 Waite Farm
Kansas City Dentine Company

NORTH

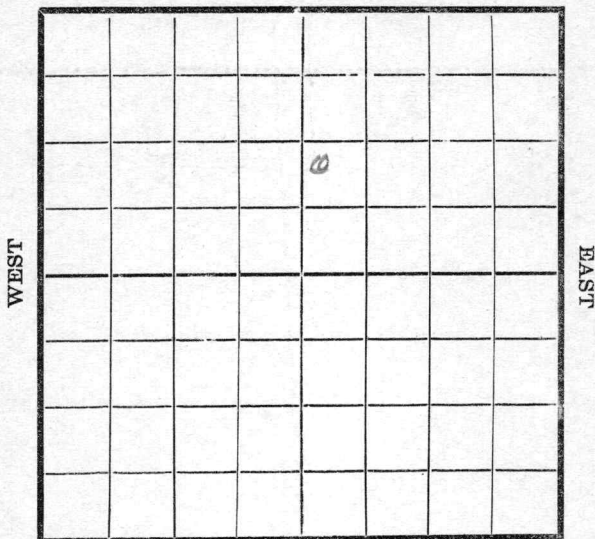

SOUTH

Location _____

Rig Up _____

Drilling and remarks

Rigging up

RECORD

Cased _____ in. _____ Ft.

Sand _____

Gas _____

Oil _____

Total Depth _____

PRODUCTION

1st 24 hrs. Nat. _____

1st 24 hrs. after shot _____

Gas _____ Cu. Ft.

Dry Hole _____

Abandoned _____


Date

11/28, 1917 Cordry Scout

Map No. _____ Sec. 21 Twp. 26 R. 4Well No. 1 White Farm
Kansas City Sulphur Company

NORTH

WEST

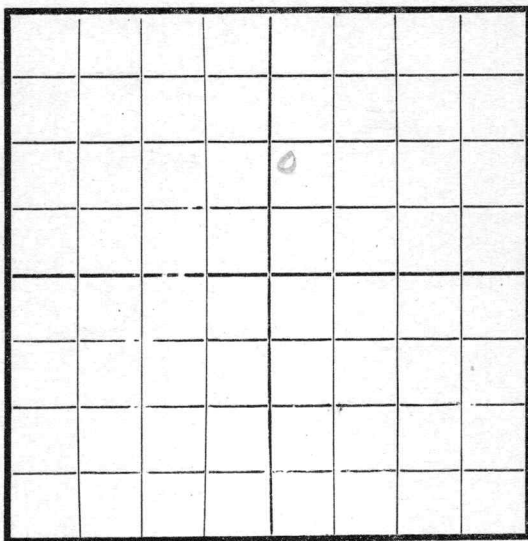

EAST

SOUTH

Location _____

Rig Up _____

Drilling and remarks

RECORD

Cased _____ in. _____ Ft.

Sand _____

Gas _____

Oil _____

Total Depth _____

PRODUCTION

1st 24 hrs. Nat. _____

1st 24 hrs. after shot _____

Gas _____ Cu. Ft.

Dry Hole _____

Abandoned _____

Date


12/5, 1912 Conduff Scout

Map No. _____ Sec. 21 Twp. 26 R. 4

Well No. 1 White Farm _____
Kansas City - Dubuque Company

NORTH

WEST

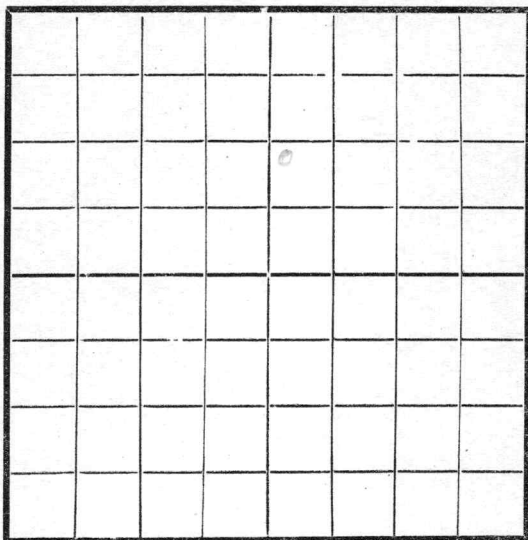

EAST

SOUTH

Location _____

Rig Up _____

Drilling and remarks

600

RECORD

Cased _____ in. _____ Ft.

Sand _____

Gas _____

Oil _____

Total Depth _____

PRODUCTION

1st 24 hrs. Nat. _____

1st 24 hrs. after shot _____

Gas _____ Cu. Ft.

Dry Hole _____

Abandoned _____

Date


1/2, 1918 C. C. Coffey Scout

Map No. _____ Sec. 21 Twp. 26 R. 4

Well No. 1 Waite Farm _____
Kansas City - Duluth Company

NORTH

WEST

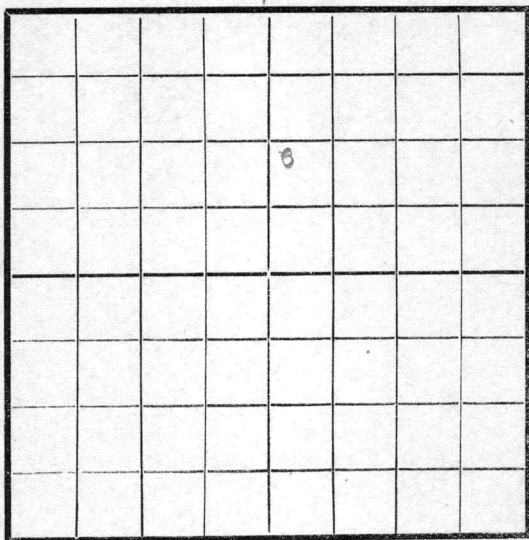

EAST

SOUTH

Location _____

Rig Up _____

Drilling and remarks

221240

RECORD

Cased _____ in. _____ Ft.

Sand _____

Gas _____

Oil _____

Total Depth _____

PRODUCTION

1st 24 hrs. Nat. _____

1st 24 hrs. after shot _____

Gas _____ Cu. Ft.

Dry Hole _____

Abandoned _____

Date


1/9, 1918 S. Condy Scout

Map No. _____ Sec. 21 Twp. 26 R. 4

Well No. 1 Waite Farm
Kansas City - Dribble Company

NORTH

WEST

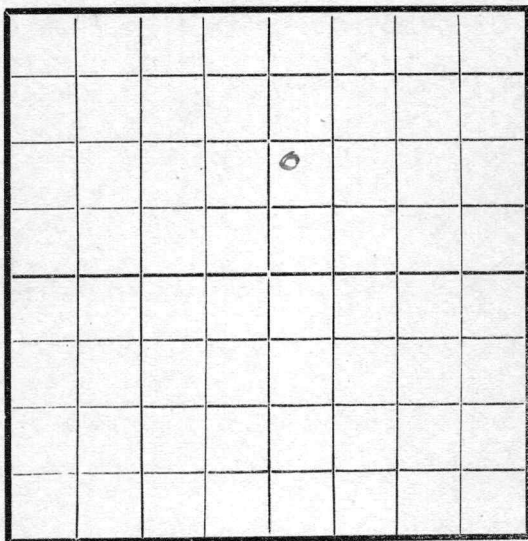

EAST

SOUTH

Location _____

Rig Up _____

Drilling and remarks

22 1240

RECORD

Cased _____ in. _____ Ft.

Sand _____

Gas _____

Oil _____

Total Depth _____

PRODUCTION

1st 24 hrs. Nat. _____

1st 24 hrs. after shot _____

Gas _____ Cu. Ft.

Dry Hole _____

Abandoned _____

Date

1/16, 1918 J. C. Cady Scout

Map No.----- Sec.----- Twp.----- R.-----

Well No. 1 mile Farm
Kansas City - Duluth Company

NORTH

WEST

EAST

SOUTH

Location _____

Rig Up -----

Drilling and remarks

22 1340

RECORD

Cased_____ in:_____Ft.

Sand

Gas

Oil

Total Depth -----

PRODUCTION

1st 24 hrs. Nat.-----

1st 24 hrs. after shot-----

Gas ----- Cu. Ft.


Dry Hole _____

Abandoned -----

Date _____

1/30 1918 Scout

Map No. _____ Sec. 21 Twp. 26 R. 4
 Well No. 1 White Farm
Kansas City Dubell Company
 Date Started _____ Ft. from N _____ S _____ E _____ W _____ line
 NORTH

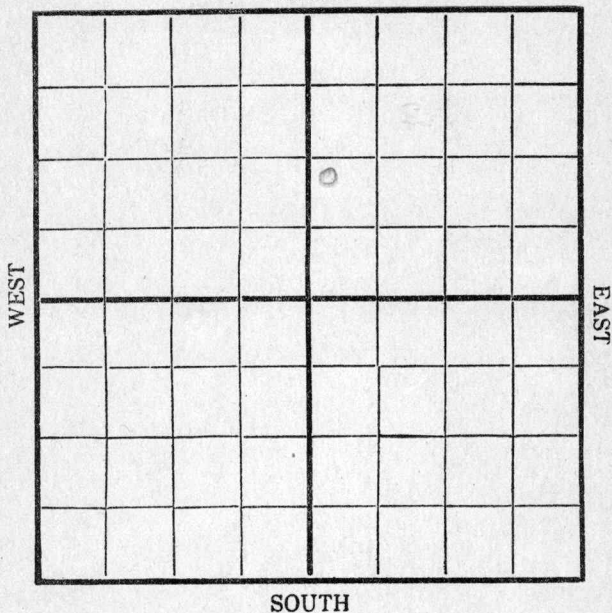

Cased _____ In. _____ Ft.
 Sand _____
 Pay { Gas _____
 { Oil _____
 Total Depth _____

Production Remarks


Condition of Well on this date 2/6/18

SD 1240

Candey

Scout

Map No. _____ Sec. 21 Twp. 26 R. 4
 Well No. 1 Wright Farm _____
Kansas City - Lubbock Company _____
 NORTH

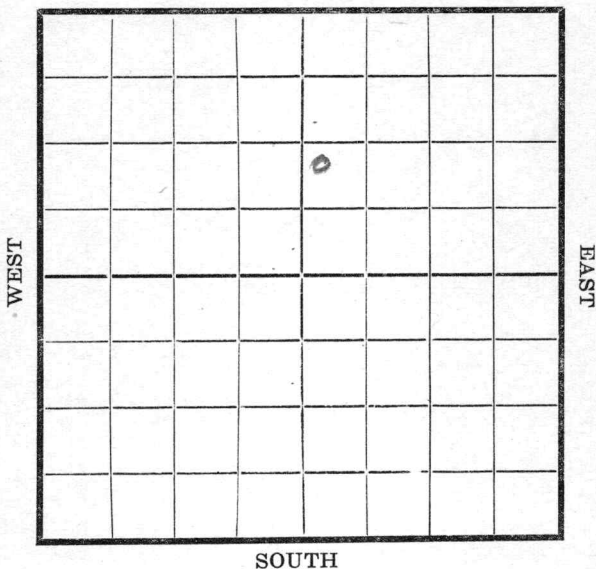

Location _____
 Rig Up _____
 Drilling and remarks

SD 1240

RECORD

Cased _____ in. _____ Ft.
 Sand _____
 Gas _____
 Oil _____
 Total Depth _____

PRODUCTION

1st 24 hrs. Nat. _____
 1st 24 hrs. after shot _____
 Gas _____ Cu. Ft.
 Dry Hole _____
 Abandoned _____


Date

4/14, 1918 C. C. Carey Scout

Map No. _____ Sec. 21 Twp. 26 R. 4Well No. 1 White Farm _____
Kansas Oil & Drilling Company

NORTH

WEST

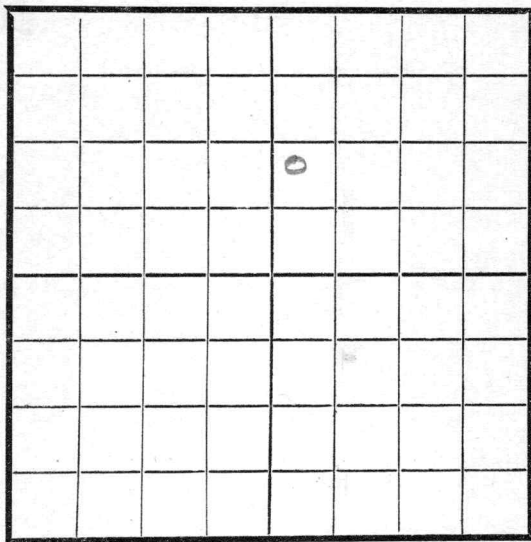

EAST

SOUTH

Location _____

Rig Up _____

Drilling and remarks

RECORD

Cased _____ in. _____ Ft.

Sand _____

Gas _____

Oil _____

Total Depth _____

PRODUCTION

1st 24 hrs. Nat. _____

1st 24 hrs. after shot _____

Gas _____ Cu. Ft.

Dry Hole _____

Abandoned _____


Date

2/20/1918 Scout

Map No.----- Sec. 21 Twp. 26 R. 4Well No. 1-White Farm
Kansas City - D. D. D. Co. Company

NORTH

WEST

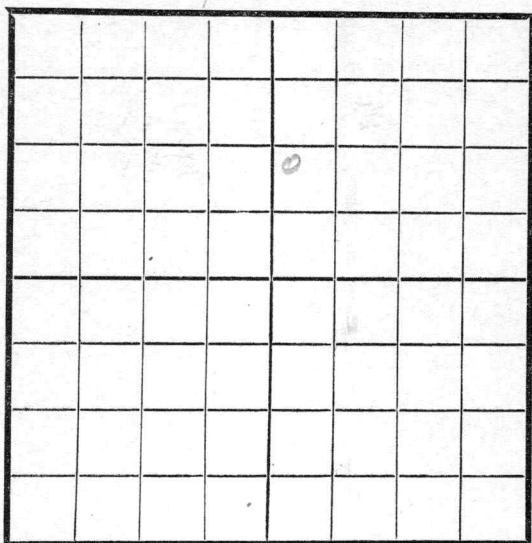

EAST

SOUTH

Location -----

Rig Up -----

Drilling and remarks

22 13 20

RECORD

Cased ----- in. ----- Ft.

Sand -----

Gas -----

Oil -----

Total Depth -----

PRODUCTION

1st 24 hrs. Nat. -----

1st 24 hrs. after shot -----

Gas ----- Cu. Ft.

Dry Hole -----


Abandoned -----

Date

7/27, 1918 C. C. C. Co. Scout

Map No. _____ Sec. 21 Twp. 36 R. 4
H.C. - Danville Company _____

NORTH

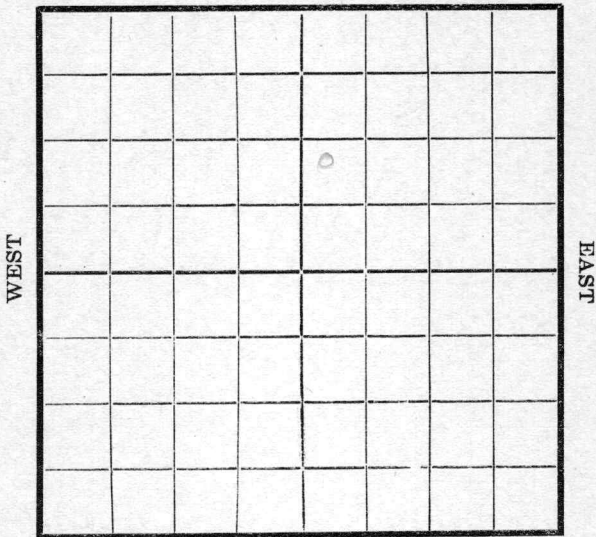

SOUTH

Location _____
 Rig Up _____
 Drilling and remarks _____

RECORD

Cased _____ in. _____ Ft.
 Sand _____
 Gas _____
 Oil _____
 Total Depth _____

PRODUCTION


1st 24 hrs. Nat. _____
 1st 24 hrs. after shot _____
 Gas _____ Cu. Ft.
 Dry Hole _____
 Abandoned _____

Date 3/6, 1911 P. C. C. C. Scout _____

Map No. _____ Sec. 21 Twp. 26 R. 4Well No. 1 Waite Farm
K.C. Daulton Oil Company

NORTH

WEST

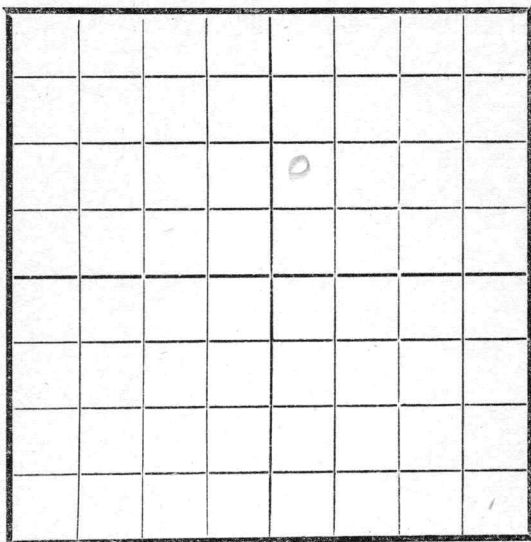

EAST

SOUTH

Location _____

Rig Up _____

Drilling and remarks

WR 1410

RECORD

Cased _____ in. _____ Ft.

Sand _____

Gas _____

Oil _____

Total Depth _____

PRODUCTION

1st 24 hrs. Nat. _____

1st 24 hrs. after shot _____

Gas _____ Cu. Ft.

Dry Hole _____

Abandoned _____


Date

3/13, 1918 J. C. Daulton Scout

Map No. _____ Sec. 21 Twp. 26 R. 4Well No. 1 waite Farm _____K.C. Daulton Oil Company _____

NORTH

WEST

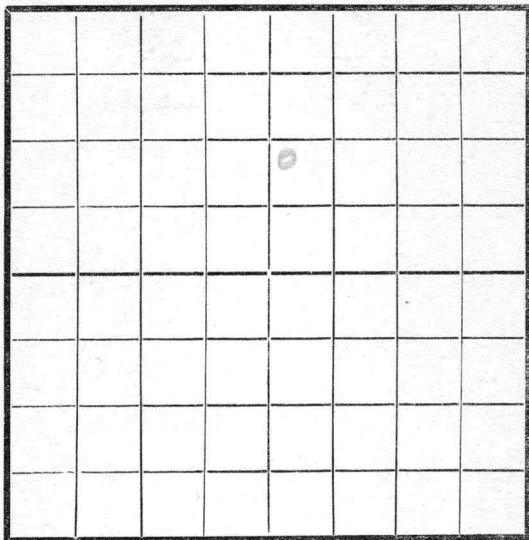

EAST

SOUTH

Location _____

Rig Up _____

Drilling and remarks

RECORD

Cased _____ in. _____ Ft.

Sand _____

Gas _____

Oil _____

Total Depth _____

PRODUCTION

1st 24 hrs. Nat. _____

1st 24 hrs. after shot _____

Gas _____ Cu. Ft.

Dry Hole _____

Abandoned _____

Date


3/20, 1918 Scout

Map No. _____ Sec. 21 Twp. 26 R. 4

Well No. 1 Waite Farm _____
K C - Smith Company

NORTH

WEST

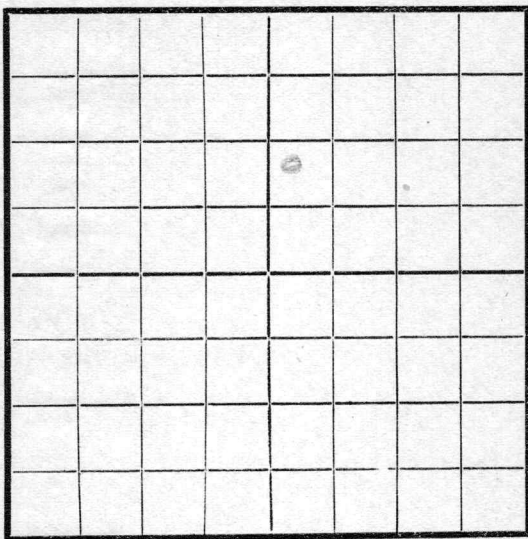

EAST

SOUTH

Location _____

Rig Up _____

Drilling and remarks

1670

RECORD

Cased _____ in. _____ Ft.

Sand _____

Gas _____

Oil _____

Total Depth _____

PRODUCTION

1st 24 hrs. Nat. _____

1st 24 hrs. after shot _____

Gas _____ Cu. Ft.

Dry Hole _____


Abandoned _____

Date

3/27, 1918 S. C. Smith Scout

Map No. _____ Sec. 21 Twp. 26 R. 4
Well No. 1 White Farm _____
Ke. D. Smith Company _____

NORTH

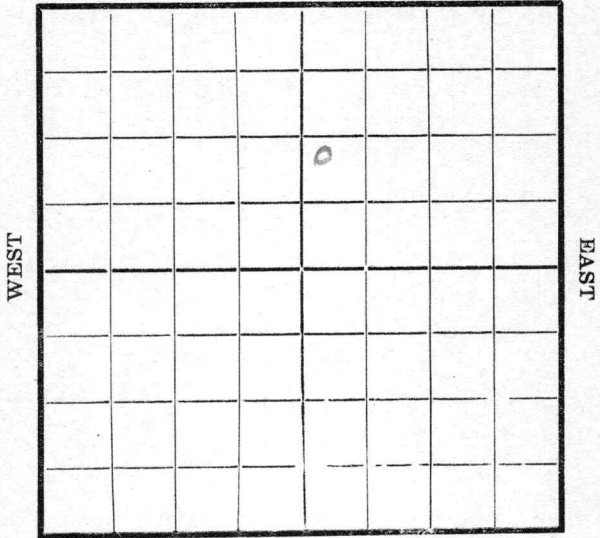

SOUTH

Location _____ Rig Up _____ Drilling and remarks <u>2130</u>	RECORD
	Cased _____ in. _____ Ft.
	Sand _____
	Gas _____
	Oil _____
	Total Depth _____
	PRODUCTION
	1st 24 hrs. Nat. _____
	1st 24 hrs. after shot _____
	Gas _____ Cu. Ft.
	Dry Hole _____
	Abandoned _____


Date _____
APR 3 1918, 1918 Candy Scout

Map No. _____ Sec. 21 Twp. 26 R. 4


NORTH

WEST

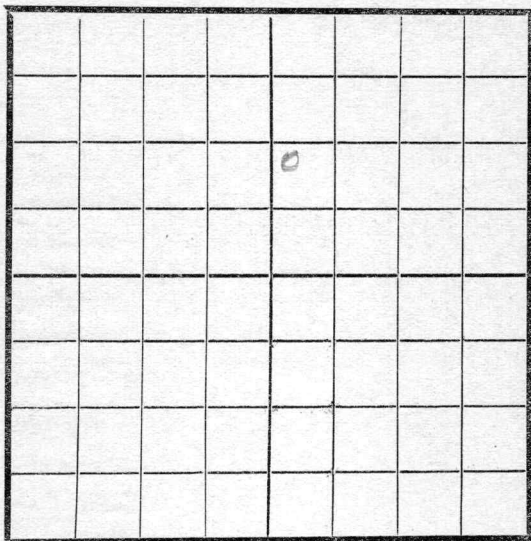

EAST

SOUTH

Location _____

Rig Up _____

Drilling and remarks

WR
2200

RECORD

Cased _____ in. _____ Ft.

Sand _____

Gas _____

Oil _____

Total Depth _____

PRODUCTION

1st 24 hrs. Nat. _____

1st 24 hrs. after shot _____

Gas _____ Cu. Ft.

Dry Hole _____

Abandoned _____

Date


4/10, 1911 S. C. G. G. G. Scout

Map No. _____ Sec. 31 Twp. 26 R. 4

Well No. 1 Farm _____
H.C. Dumble Company

NORTH

WEST

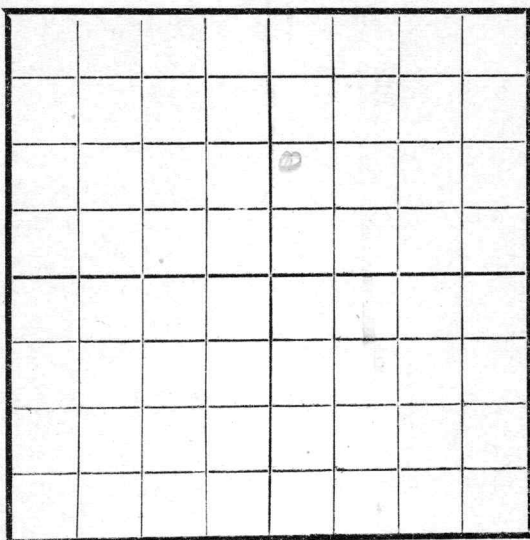

EAST

SOUTH

Location _____

Rig Up _____

Drilling and remarks

UR 2200

RECORD

Cased _____ in _____ Ft

Sand _____

Gas _____

Oil _____

Total Depth _____

PRODUCTION

1st 24 hrs. Nat. _____

1st 24 hrs. after shot _____

Gas _____ Cu. Ft.

Dry Hole _____

Abandoned _____


Date

4/17, 1918 Scout

Map No. _____ Sec. 21 Twp. 26 R. ✓Well No. 1 Waite Farm
Kansas-Delaware Company

NORTH

WEST

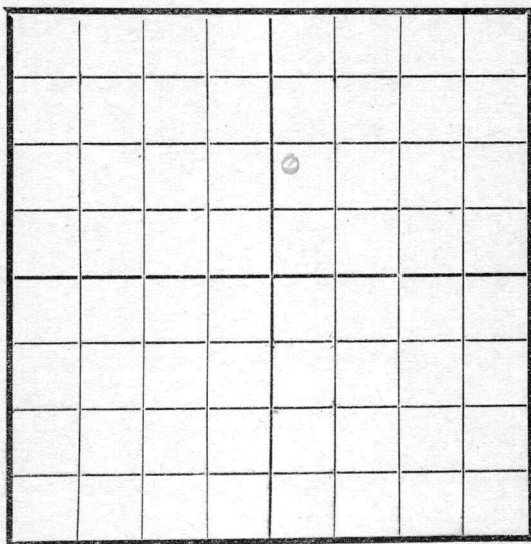

EAST

SOUTH

Location _____

Rig Up _____

Drilling and remarks

WR 2200

RECORD

Cased _____ in. _____ Ft.

Sand _____

Gas _____

Oil _____

Total Depth _____

PRODUCTION

1st 24 hrs. Nat. _____

1st 24 hrs. after shot _____

Gas _____ Cu. Ft.

Dry Hole _____

Abandoned _____


Date

4/24, 1918 Candyp Scout

Map No. _____ Sec. 21 Twp. 36 R. 4Well No. 1 Wright FarmMcC. D. D. D. D. Company

NORTH

WEST

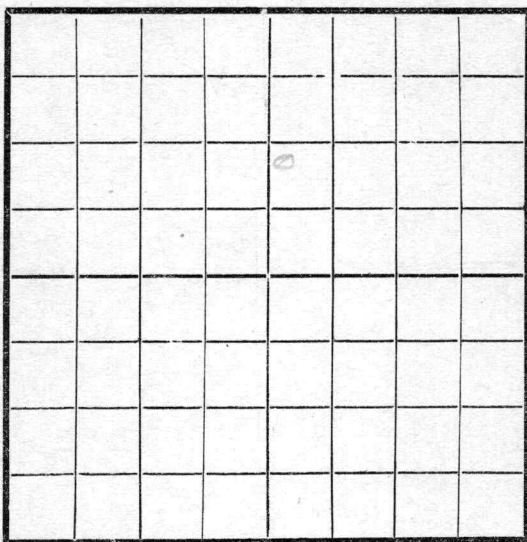

EAST

SOUTH

Location _____

Rig Up _____

Drilling and remarks

2340

RECORD

Cased _____ in. _____ Ft.

Sand _____

Gas _____

Oil _____

Total Depth _____

PRODUCTION

1st 24 hrs. Nat. _____

1st 24 hrs. after shot _____

Gas _____ Cu. Ft.

Dry Hole _____

Abandoned _____


Date

5/1, 1918 8 C. C. C. C. Scout

Map No. _____ Sec. 31 Twp. 26 R. 4Well No. 1 Wait Farm
H.C. Durbach Company

NORTH

WEST

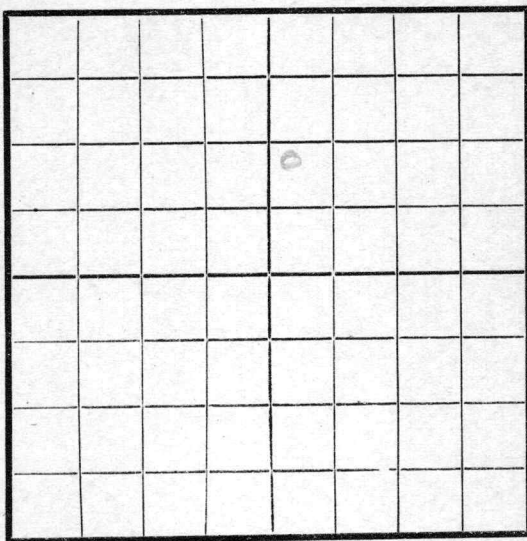

EAST

SOUTH

Location _____

Rig Up _____

Drilling and remarks

22 2450

RECORD

Cased _____ in. _____ Ft.

Sand _____

Gas _____

Oil _____

Total Depth _____

PRODUCTION

1st 24 hrs. Nat. _____

1st 24 hrs. after shot _____

Gas _____ Cu. Ft.

Dry Hole _____

Abandoned _____

Date


5/8, 1918 C. Durbach Scout

Map No. _____ Sec. 21 Twp. 26 R. 4

Well No. 1 write Farm _____
HC - Duluth Company _____

NORTH

WEST

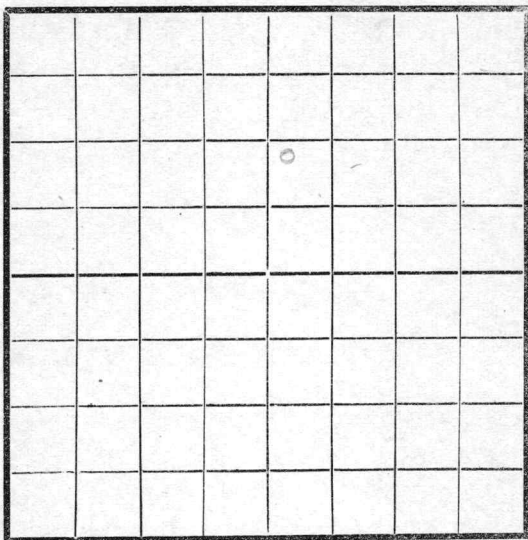

EAST

SOUTH

Location _____

Rig Up _____

Drilling and remarks

WR 2545

RECORD

Cased _____ in. _____ Ft.

Sand _____

Gas _____

Oil _____

Total Depth _____

PRODUCTION

1st 24 hrs. Nat. _____

1st 24 hrs. after shot _____

Gas _____ Cu. Ft.

Dry Hole _____


Abandoned _____

Date

5/15, 1918 Candiff Scout

Map No.----- Sec. 21 Twp. 26 R. 4
 Well No. 1201 Farm
K.C. - D. Miller Company

NORTH

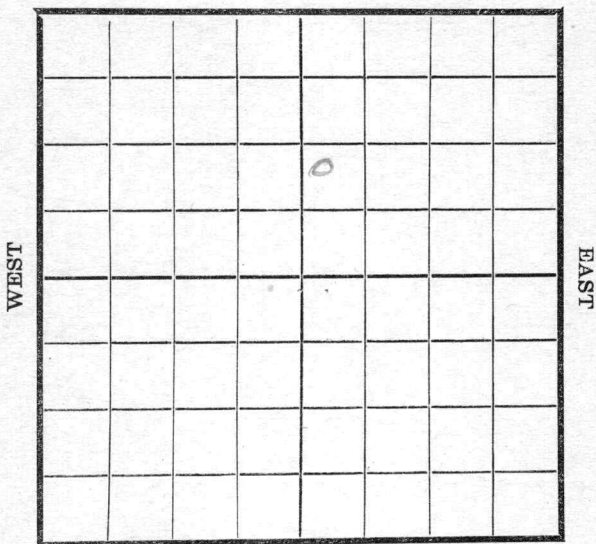

SOUTH

Location -----
 Rig Up -----
 Drilling and remarks

2545

RECORD

Cased ----- in. ----- Ft.
 Sand -----
 Gas -----
 Oil -----
 Total Depth -----

PRODUCTION

1st 24 hrs. Nat. -----
 1st 24 hrs. after shot -----
 Gas ----- Cu. Ft.
 Dry Hole -----
 Abandoned -----


Date

5/22, 1911 J. C. Anderson Scout

Map No. _____ Sec. 31 Twp. 26 R. 4Well No. 1 mile Farm _____
100 - 2nd Company _____

NORTH

WEST

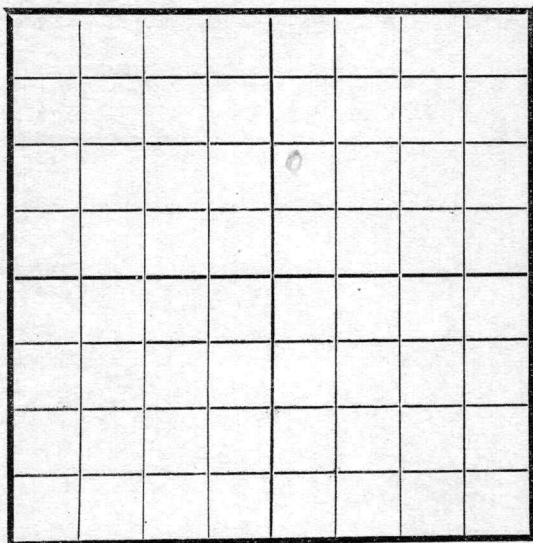

EAST

SOUTH

Location _____

Rig Up _____

Drilling and remarks

Drilling up
W.R. Diggins
25-45'

RECORD

Cased _____ in _____ Ft.

Sand _____

Gas _____

Oil _____

Total Depth _____

PRODUCTION

1st 24 hrs. Nat. _____

1st 24 hrs. after shot _____

Gas _____ Cu. Ft.

Dry Hole _____

Abandoned _____


Date

5/29 S. C. Condit
_____, 191____ Scout

Map No. K 14 Sec. 21 Twp. 26 R. 4Well No. 1 White Farm
K.C. - 2 white oil Company

NORTH

WEST

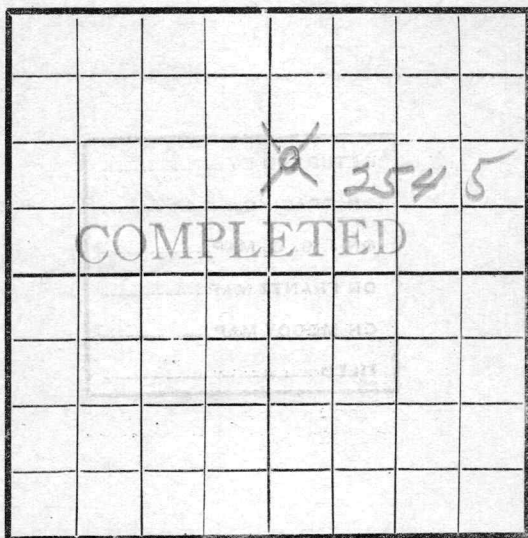

EAST

SOUTH

Location -----

Rig Up -----

Drilling and remarks

*Dry and
abandoned
2545*

RECORD

Cased ----- in. ----- Ft.

Sand -----

Gas -----

Oil -----

Total Depth -----

PRODUCTION

1st 24 hrs. Nat. -----

1st 24 hrs. after shot -----

Gas ----- Cu. Ft.

Dry Hole -----

Abandoned -----

Date

6/4, 1918 C. Anderson Scout

MAP No. K19 KANSAS SEC. 21 TWP. 26S R. 4E

WELL No. 1 North

P. M. C. & D. COMPANY

CONTRACTOR

SECTION PLAT

ABANDONED

_____ FT. FROM N. LINE

_____ FT. FROM S. LINE

_____ FT. FROM E. LINE

_____ FT. FROM W. LINE

		0	

RECORD

LOCATION _____

CASED _____ IN. _____ FT.

RIG UP _____

SAND _____

DRILLING AND REMARKS:

GAS _____

OIL _____

TOTAL DEPTH 254 1/2

PRODUCTION

1ST 24 HRS. NAT. _____

1ST 24 HRS. AFTER SHOT _____

GAS _____ CU. FT.

DRY HOLE ☒

ABANDONED ☒

DATE

6-19-18

192

SCOUT