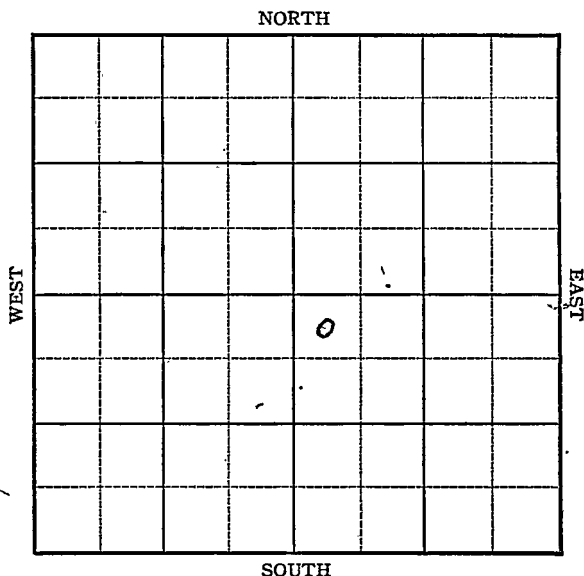


KANSAS

Butler

Section 29 Township 26 Range 7EWell No. 3 Gunther "B" (*Guenther*)Company Rex & Morris

KANSAS

Butler County

Sec. 29 Twp. 26 R. 7E

Well No. #3 Gunther "B" Farm

Rex & Morris Company


Miscellaneous

330 Ft. from N. Line

 Ft. from S. Line

 Ft. from E. Line

330 Ft. from W. Line

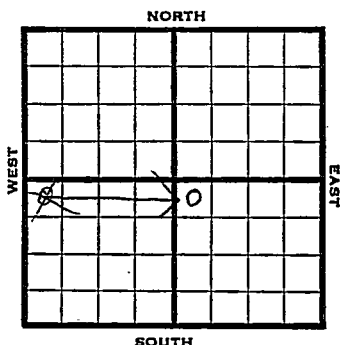

~~NW SW~~ NW SE

1946 Elev 1459' REPORT

4/24 Twin well
Spud

5/1 12" @ 850
Drlg 900'

5/7 Drlg 1465'

5/14 10" @ 1670
Drlg 1940'

5/21 Miss 2752-53 TD
7" @ 2753, WOC

5/29 Miss 2752
7" @ 2753'
TD 2785'
1000 acid
Pump 50 Pot
38.0 Gr.

COMPLETED

KANSAS

KansaPool Name MiscellaneousMap No. 75 Sec. 29 Twp. 26 R. 7EWell No. 3 Gunther "B"Rex & Morris CompanyFIRST REPORT Contractor

NW SW

SECTION PLAT

330 Ft. from N. Line Ft. from S. Line Ft. from E. Line330 Ft. from W. Line

o			

Butler CountyLocation Rig up

Drilling and Remarks:

twin well

spud

RECORD

Cased in., ft.Sand Gas Oil Total Depth

PRODUCTION

1st 24 hrs. Nat. 1st 24 hrs. after shot Gas Cu. Ft.Dry Hole Abandoned

Date


APR 24 1946 19S. J. LEWIS Scout

~~KANSAS~~ Kansas Pool Name Miscellaneous
 Map No. 10 Sec. 29 Twp. 26 R. 7E
 Well No. 3 Gunther "B"

Rex & Morris Company
CORRECTION Contractor

NW SE

SECTION PLAT

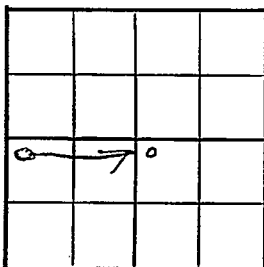

330 Ft. from N. Line
 _____ Ft. from S. Line
 _____ Ft. from E. Line
330 Ft. from W. Line

Butler County

Location _____

Rig up _____

Drilling and Remarks:

Reported
 NW SW

RECORD

Cased _____ in., _____ ft.

Sand _____

Gas _____

Oil _____

Total Depth _____

PRODUCTION

1st 24 hrs. Nat. _____

1st 24 hrs. after shot _____

Gas _____ Cu. Ft.

Dry Hole _____

Abandoned _____

Date

MAY 1 1946

19

S. J. LEWIS Scout

Kansas Pool Name Miscellaneous* KANSAS
Map No. 15 Sec. 29 Twp. 26 R. 7EWell No. 3 Gunther "B"Rex & Morris Company**COMPLETED**

Contractor

NW SE

E 11459
SECTION PLAT330 Ft. from N. Line Ft. from S. Line Ft. from E. Line330 Ft. from W. Line

		0	

Butler CountyLocation Rig up

Drilling and Remarks:

Miss 27527" @ 27531000 acidPump 50 ft380 ft**RECORD**Cased in., ft.Sand Gas Oil Total Depth 2785**PRODUCTION**1st 24 hrs. Nat. 1st 24 hrs. after shot Gas Cu. Ft.Dry Hole Abandoned

Date

MAY 29 1946 19 S. J. LEWIS Scout