Butler.


KANSAS

SECTION 22 TOWNSHIP 26S RANGE 4E

WELL NO. #1 Jommers (Sommers)

COMPANY J. E. Morris & Kewanee

NE NE NW

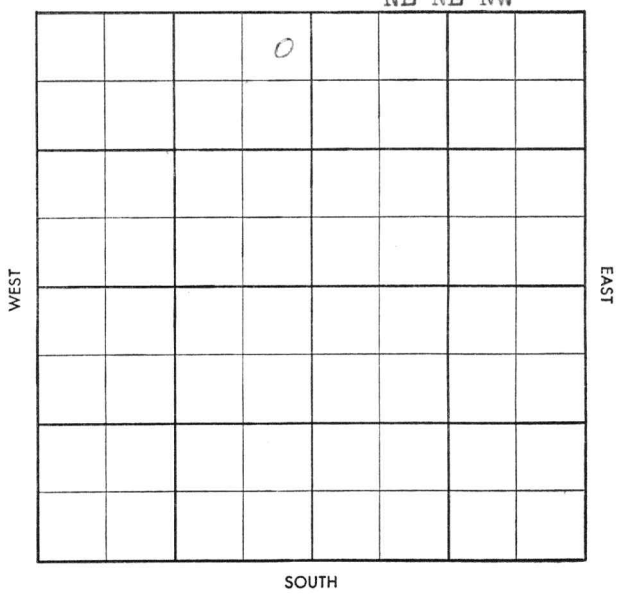

FORM 504-3 SUNRAY

Twp. X Pool X

Sec. X Facet X

S-513-B

County Butler Elev.

Sec. 22 Twp. 26 Rge. 4E

Company J. E. Morris & Kewanee

Farm Name Jommers No. 1

TOPS	DEPTH	LOG	DATUM
Anh.			
Tp.			
H.			
Tr.			
Dg.			
B. L.			
L.			
K.C.			
B.K.C.			
Ce.			
C.			
M.			
M.			
K.			
Mz.			
Mq.			
V.			
S.			
S.			
A.			
R.			
Pf.			
G.			
T.D.			

Loc. in Sec. NE NE NW

Geol.

Contr. Rex & Morris

Pool ElDorado



Date Comm. 6-30-58

8" @ 206 w/150, Drlg. 1400

Co. Lse. No. Sec. T. R.

Twp. X Pool X

Co. X Facet X

S-513-B

County Butler Elev 1304DF 1307KB

Sec. 22 Twp. 26 Rge. 4E

Company J. T. Morris & Kewanee

Farm Name Jommers No. 1

TOPS	DEPTH	LOG	DATUM
Anh.			
Tp.			
H.			
Tr.			
Dg.			
B. L.	1702		
L.	1876		
~~K.C.~~ BLSS	1969		
~~B.K.C.~~ KC	2066		
~~Ce.~~ DEC	2248		
C.		2482	
M.		2499	
M.			
K.		2521	
Mz.			
Mq.			
V.			
S. 2d		2595	
S.			
A.		2676	
R.			
Pf.			
G.			
T.D.	2690		

Loc. in Sec. NE NE NW

Geol.

Contr. Rex & Morris

Pool El Dorado

0

JUL 9 '58

ABANDONED

Date Comm. 6-30-58

8" @ 206 w/150, Drlg. 1400 JUL 9 '58

D&A

Co. Lse No. Sec. T. R.