


Section 31 Township 26 Range 7E

Well No. #1 Huntley

Company Chet Meyers

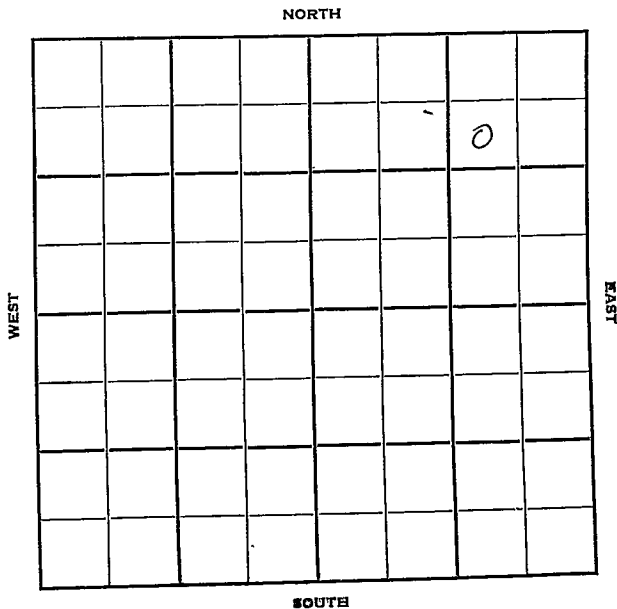

KANSAS

Butler

Sec. 31 Twp. 26 R. 7-E

Well No. #1 Huntley Farm

Chet Meyers Company

Semi-Wildcat Contractor


990 Ft. from N. Line

 Ft. from S. Line

990 Ft. from E. Line

 Ft. from W. Line

SW NE NE

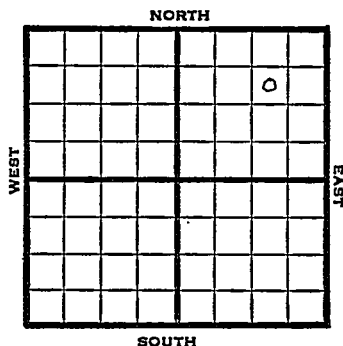

1950

Elev 1444

REPORT

9/13 MIM

10/11 Spud 9-15-50

Miss 2746

TD 2765

HFW

D&A

ABANDONED

J. E. TYRA

J. E. TYRA