


Map No. Kansas Sec. 32 Twp. 26 R. 7
 Well No. 1 Huntley Farm
Walter Hough Company

NORTH

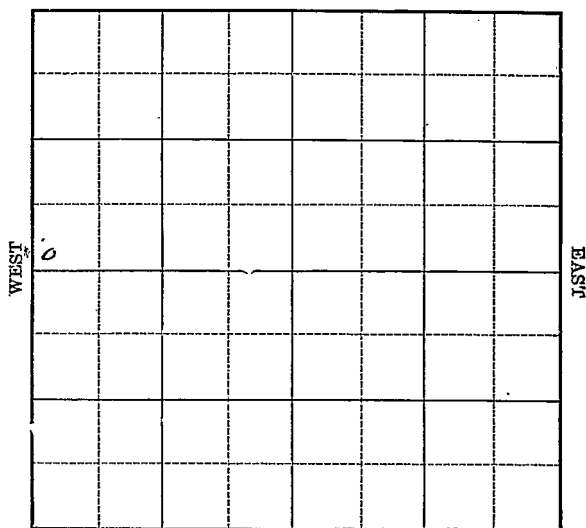

SOUTH

Location _____

Drilling Remarks

Rig Up _____

Drilling Remarks

RECORD

Cased _____ in. _____ ft.

Sand _____

Gas _____

Oil _____

Total Depth _____

PRODUCTION

1st 24 hrs. Nat. _____

1st 24 hrs. after shot _____

Gas _____ cu. ft.

Dry Hole _____

Abandoned _____

Map No. 1 Kansas Sec. 32 Twp. 26 R. 7Well No. 1 Huntley Farm
Walter Hoyh Company

NORTH


Ft. from N. Line

250 Ft. from S. Line

Ft. from E. Line

250 Ft. from W. Line

WEST

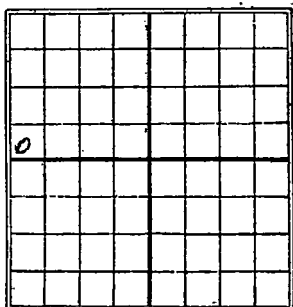

EAST

SOUTH

Date

REPORT

<u>1/25</u>	
<u>12/3</u>	<u>Rig up</u>
<u>12/10</u>	<u>Rig up</u>
<u>12/17</u>	<u>Spudding 50'</u>
<u>12/23</u>	<u>Drly 400'</u>
<u>12/31</u>	<u>S.D. 765'</u>
<u>1936</u>	
<u>1/8</u>	<u>————</u>
<u>1/14</u>	<u>Drly 900'</u>
<u>1/20</u>	<u>✓ 1100' bad hole.</u>
<u>1/27</u>	<u>✓ 1450'</u>
<u>2/4</u>	<u>✓ 1820'</u>
<u>2/10</u>	<u>✓ 1945'</u>
<u>2/17</u>	<u>✓ 2390</u>
<u>2/24</u>	<u>✓ 2739</u>
<u>3/5</u>	<u>Top line 2731 Drly 2825'</u>
<u>3/10</u>	<u>Top line 2731 " 2970</u>
<u>3/18</u>	<u>Drly 3075'</u>
<u>3/25</u>	<u>Base of Line 3090 Top Wilcox</u>
	<u>3154-58 H.F.W.D.A.</u>
<u>3/31</u>	<u>Abandoned 3158</u>

Butcher Co
 Map No. KANSAS 15 32 Sec. 26 Twp. 26 R. 7
 Well No. 1 Huntley
WALTER Hoyt Company

Contractor

SECTION PLAT

0			

Ft. from N. Line

250

Ft. from S. Line

Ft. from E. Line

250

Ft. from W. Line

FIRST REPORTS

Location ☒Rig up ☒

Drilling and Remarks:

RECORD

Cased _____ in., _____ ft.

Sand _____

Gas _____

Oil _____

Total Depth _____

PRODUCTION

1st 24 hrs. Nat. _____

1st 24 hrs. after shot _____

Gas _____ Cu. Ft.

Dry Hole _____

Abandoned _____

Date

DEC 3 1925

CHAS. L. SHERWOOD

192

Scout

K15 KANSAS 32 26 R. 7
 Map No. Sec. Twp. R.
 Well No. *Huntley*
Walton Hoyt Company
 Contractor

COMPLETED

SECTION PLAT

Ft. from N. Line

250

Ft. from S. Line

Ft. from E. Line

250

Ft. from W. Line

0			

ABANDONED

Location

Rig up

Drilling and Remarks:

Top line 2731'

Top Wilcox 3154'

3158' R.F.H.

Dry & whd

RECORD

Cased _____ in., _____ ft.

Sand _____

Gas _____

Oil _____

Total Depth 3158'

PRODUCTION

1st 24 hrs. Nat. _____

1st 24 hrs. after shot _____

Gas _____ Cu. Ft.

Dry Hole ☒Abandoned ☒

Date

MAR 31 1926

CHAS. L. SHERWOOD

192

Scout